


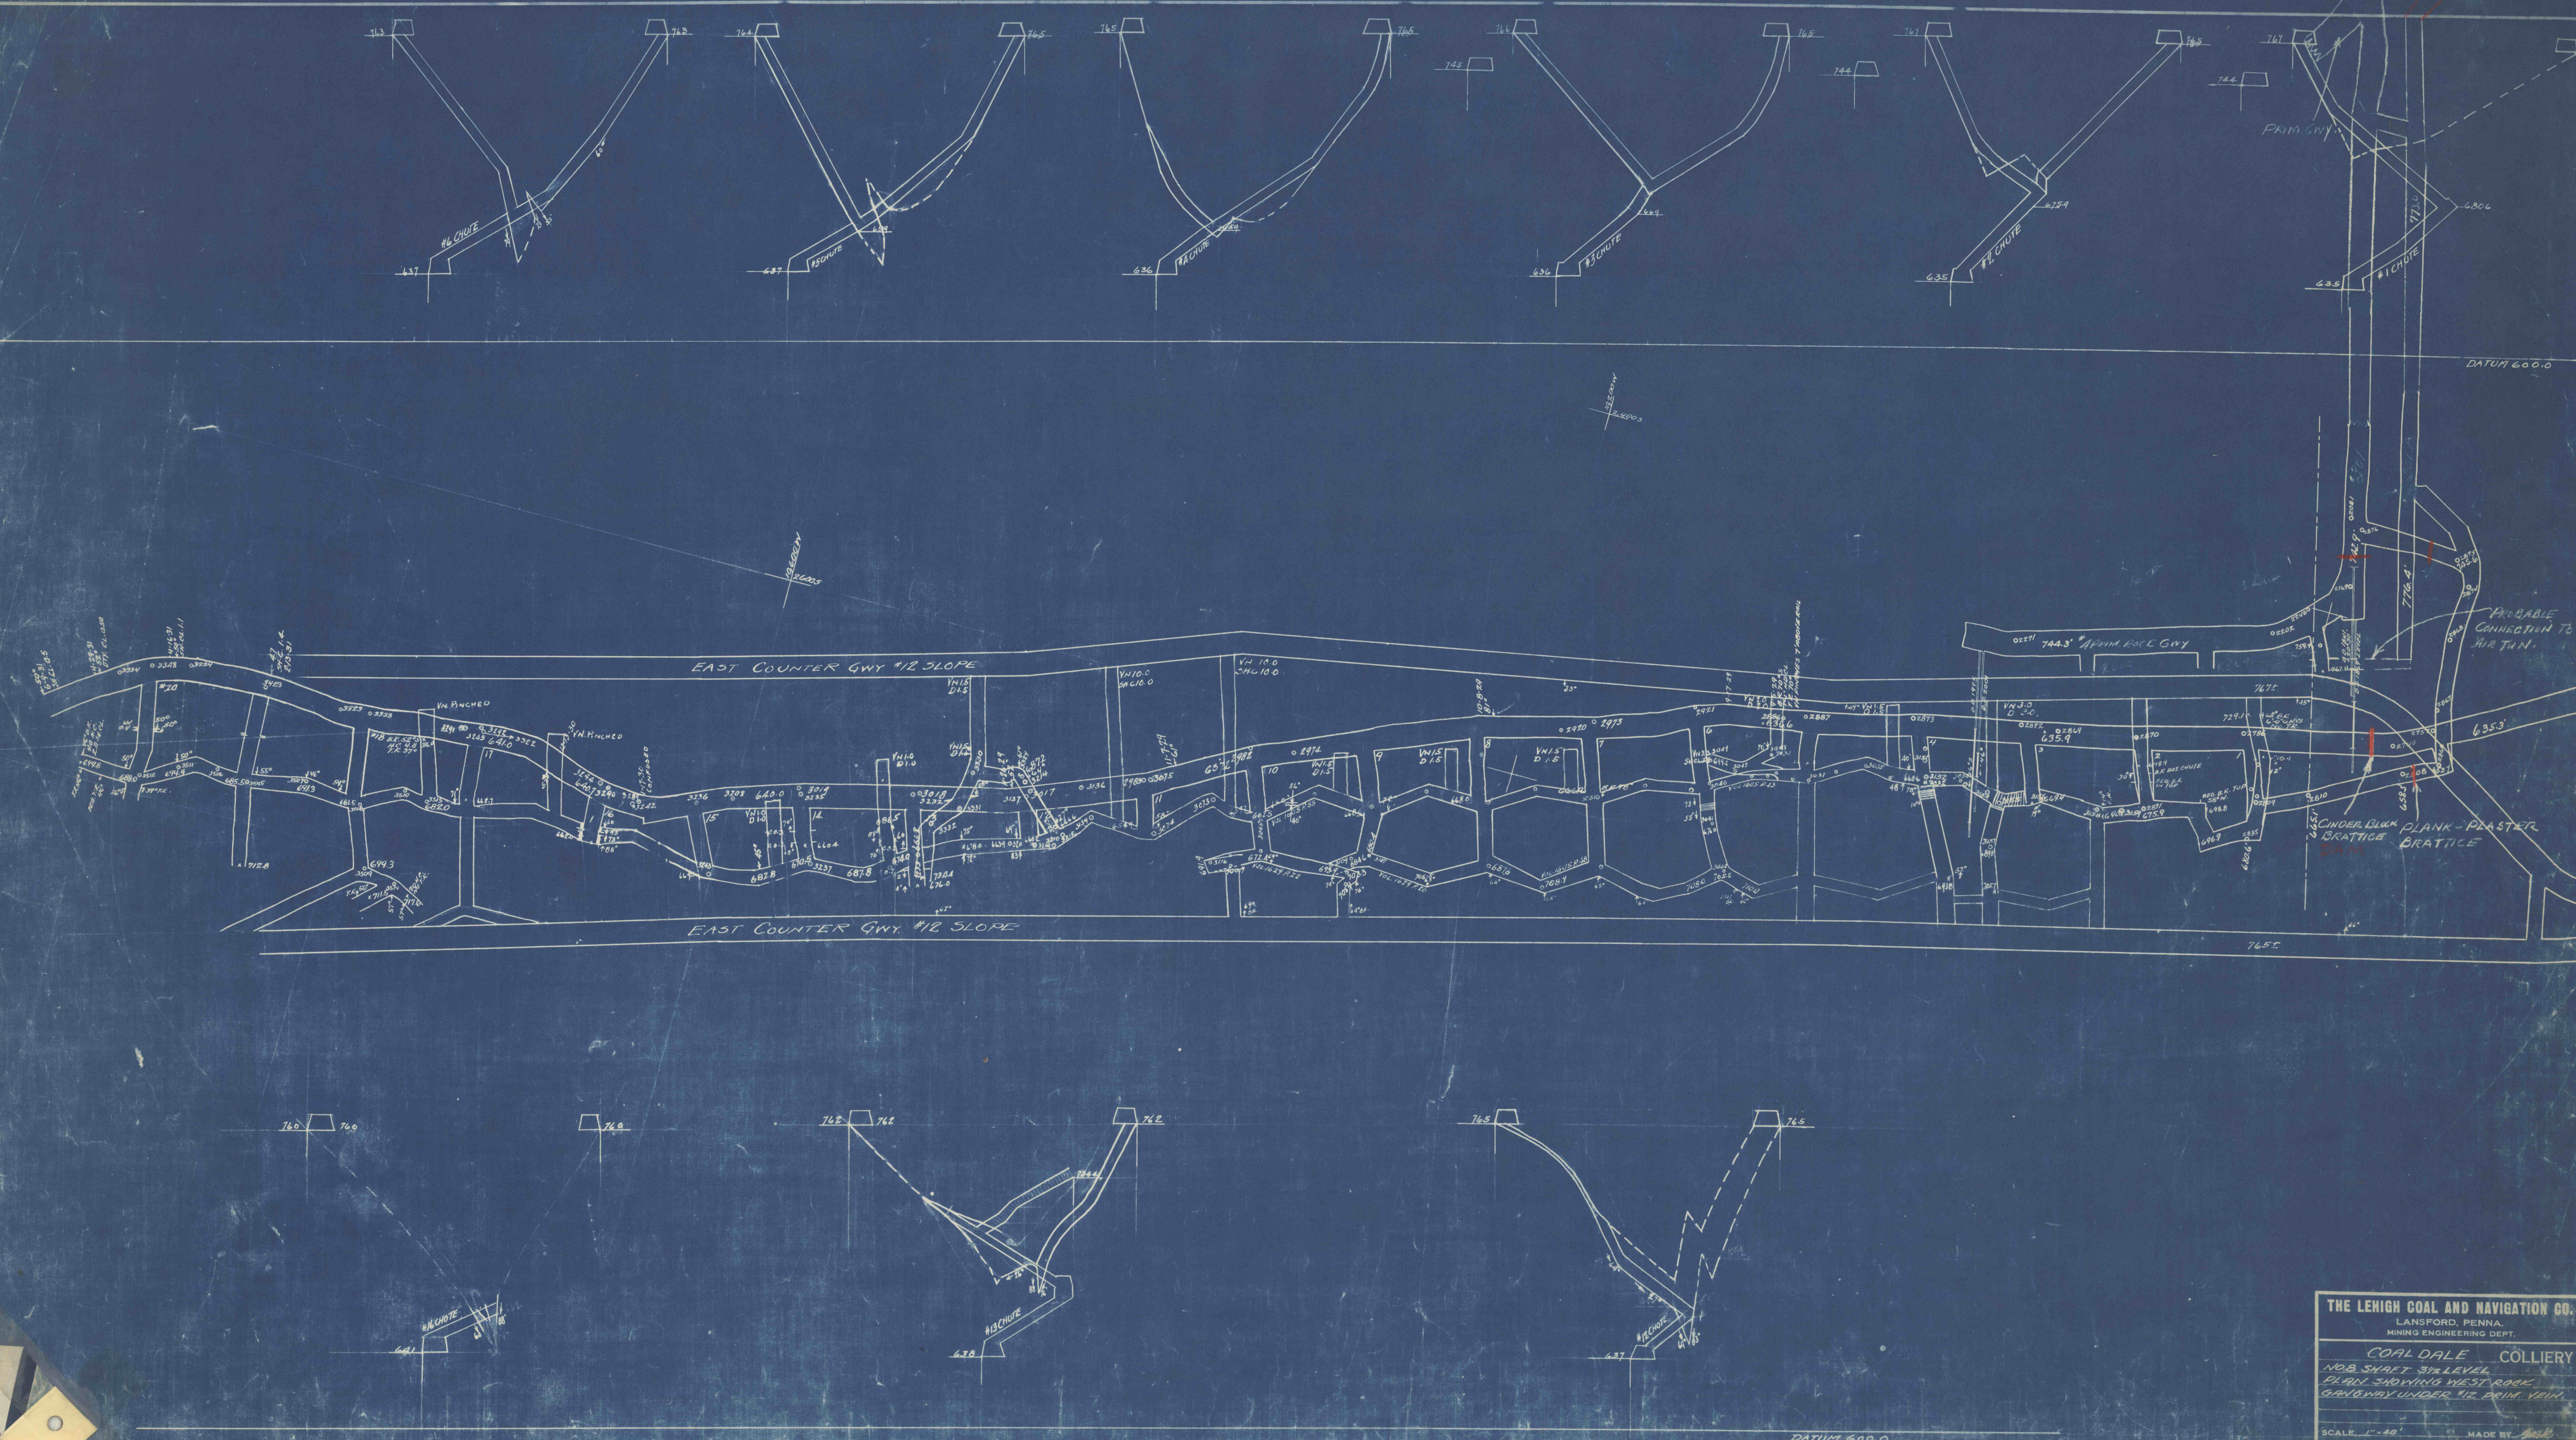

THE LEHIGH COAL AND NAVIGATION CO.
LANSDFORD, PENNA.
MINING ENGINEERING DEPT.

COAL DALE COLLIERY


SCALE 1" = 40' MADE BY J. H. B. 10/22/22

1065