




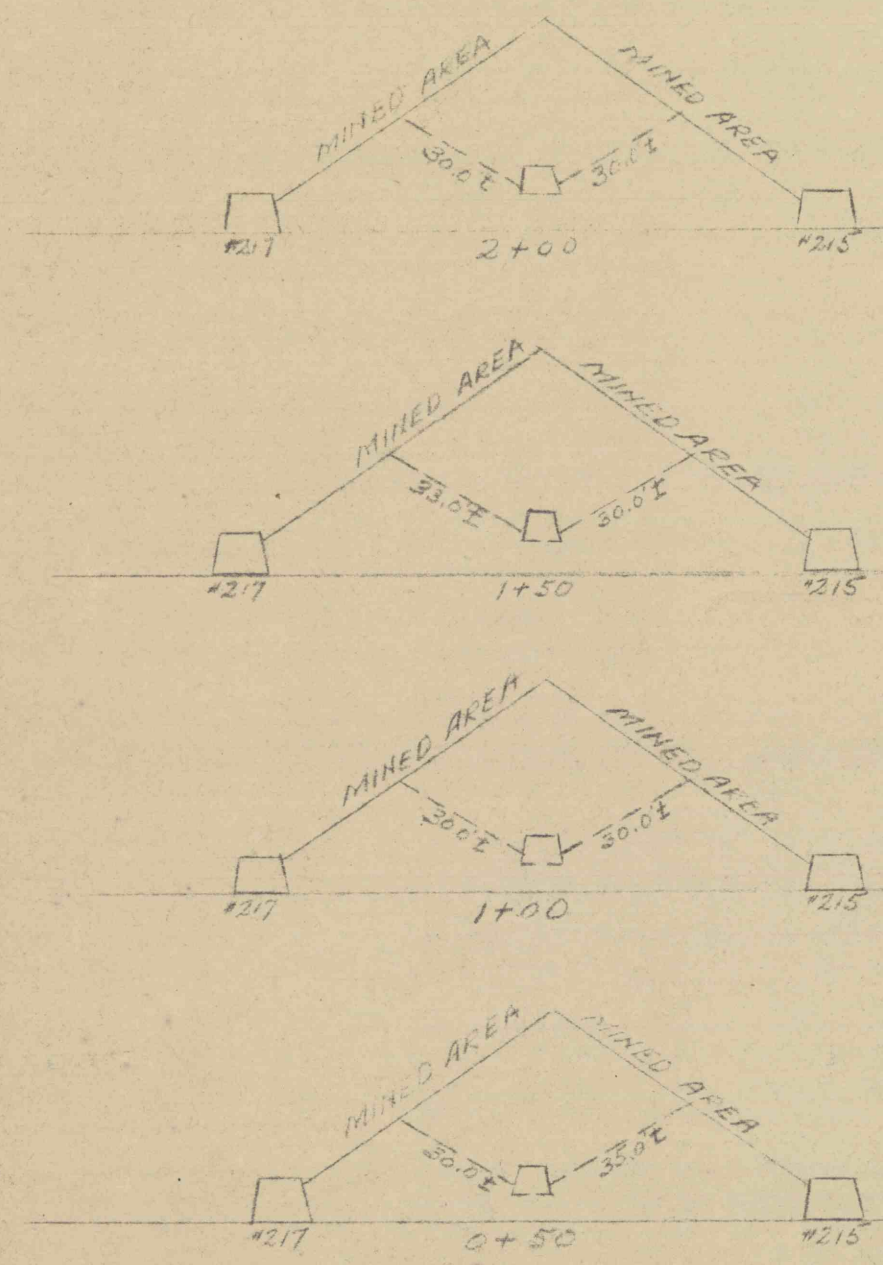


SECTIONS LOOKING NORTH
#217 AND #215 TUN.
1" = 40'

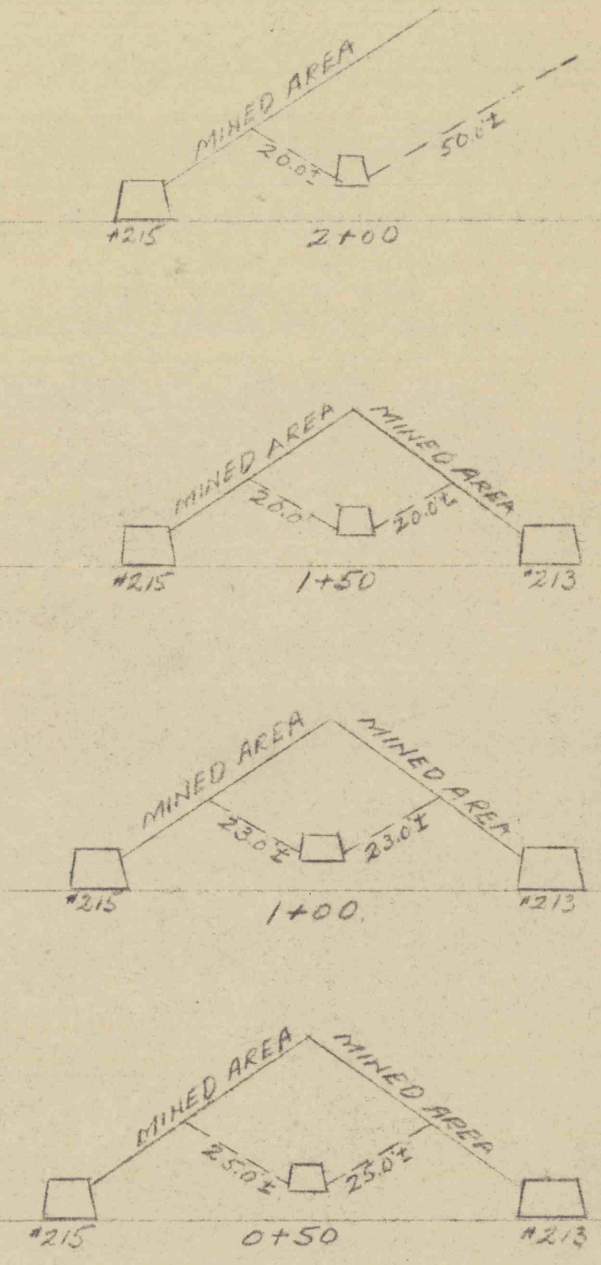

SECTIONS LOOKING NORTH
#215 AND #213 TUN.
1" = 40'

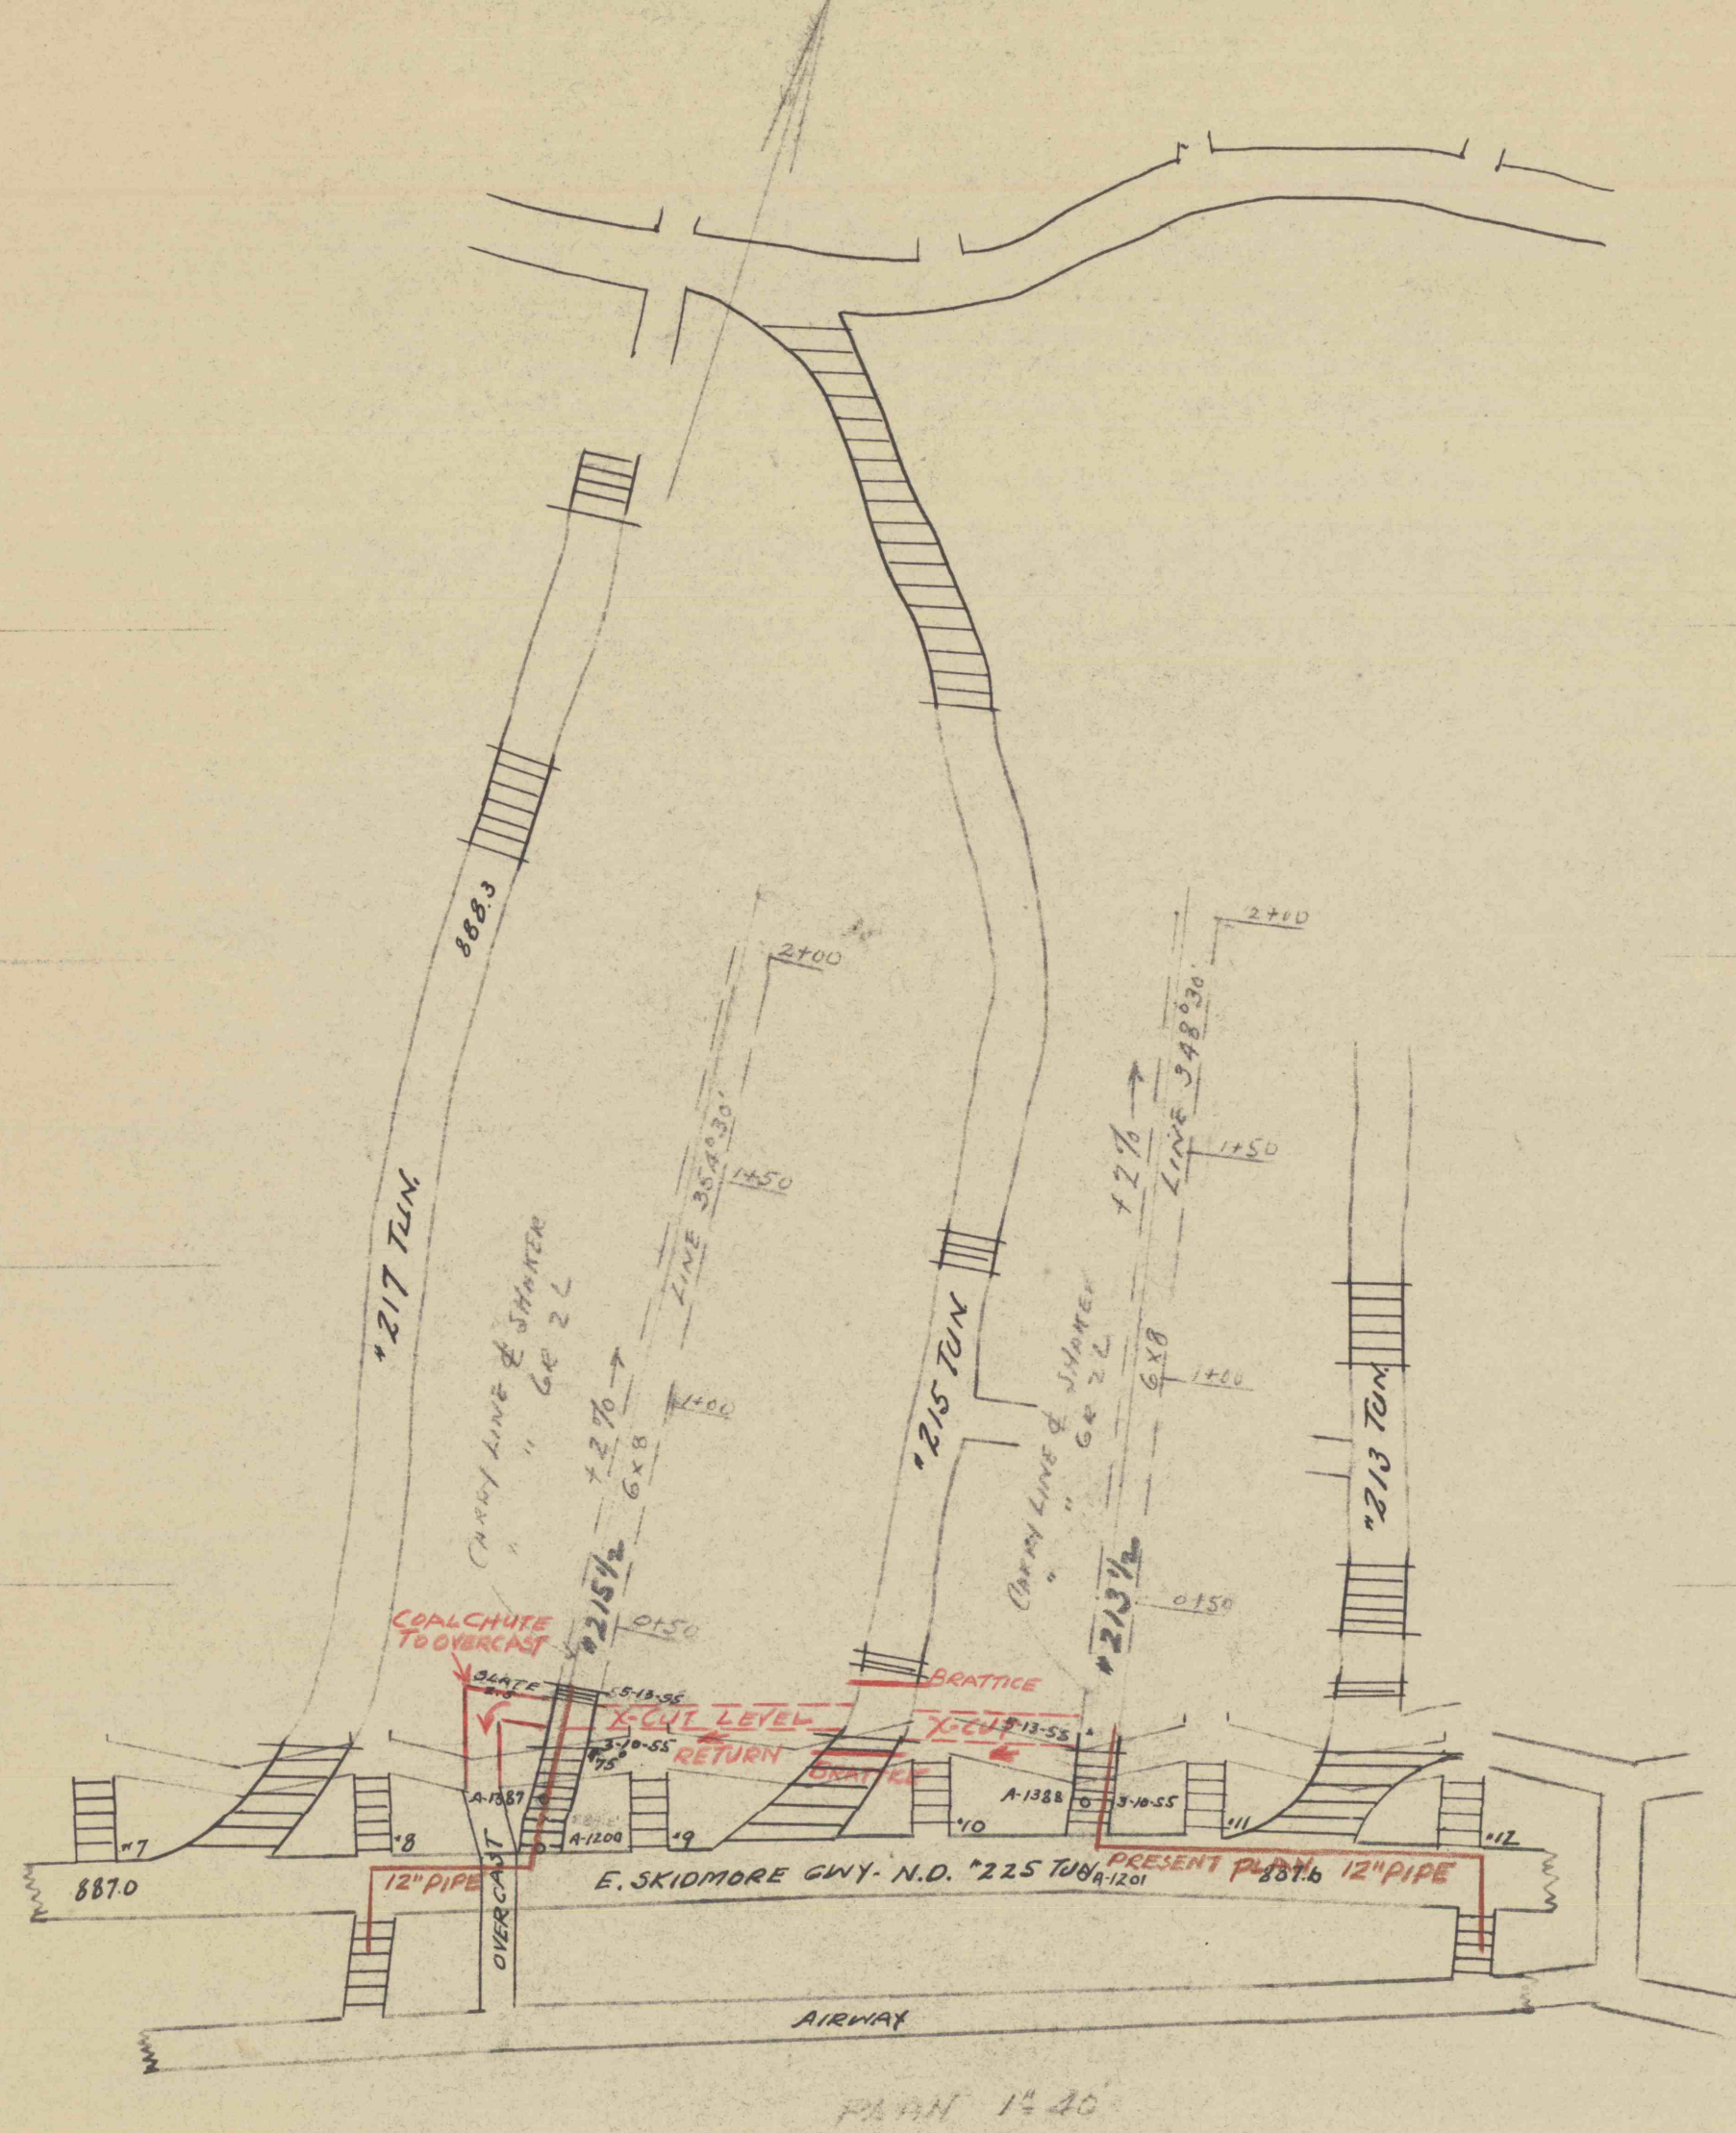

PLAN 1" = 40'

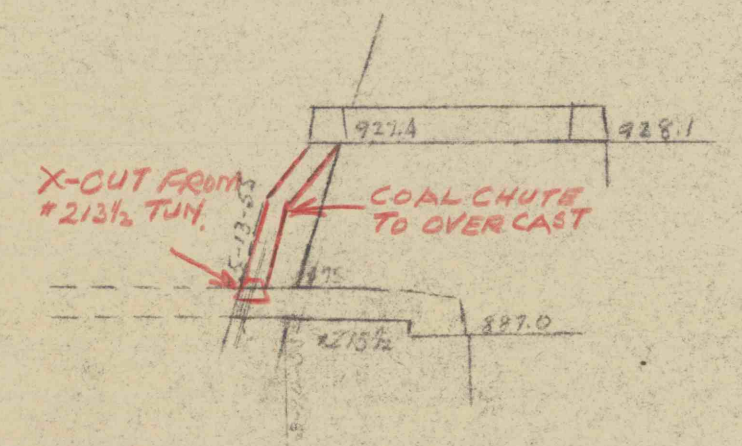

SECTION THRU #8 1/2 OVERCAST
213 1/2 TUN
1" = 40'

9/14/55

LEHIGH NAVIGATION COAL CO., INC.	
LANSFORD, PENNA.	
MINING ENGINEERING DEPT.	
COALDALE COLLIERY	
PLAN SHOWING PROPOSED	
CONVEYOR ENTRIES FOR STUMP	
MINING - 2 ND LEVEL - #9 SHAFT	
SCALE 1" = 40'	DATE 2-8-55
MADE BY GAX	TRACED BY GAX
REVISOR	CHECKED BY
APPROVED: _____	MIN. ENG.
REQUEST _____	DIST. SUPT.
JOB NO. _____	GEN. MGR

C/225