


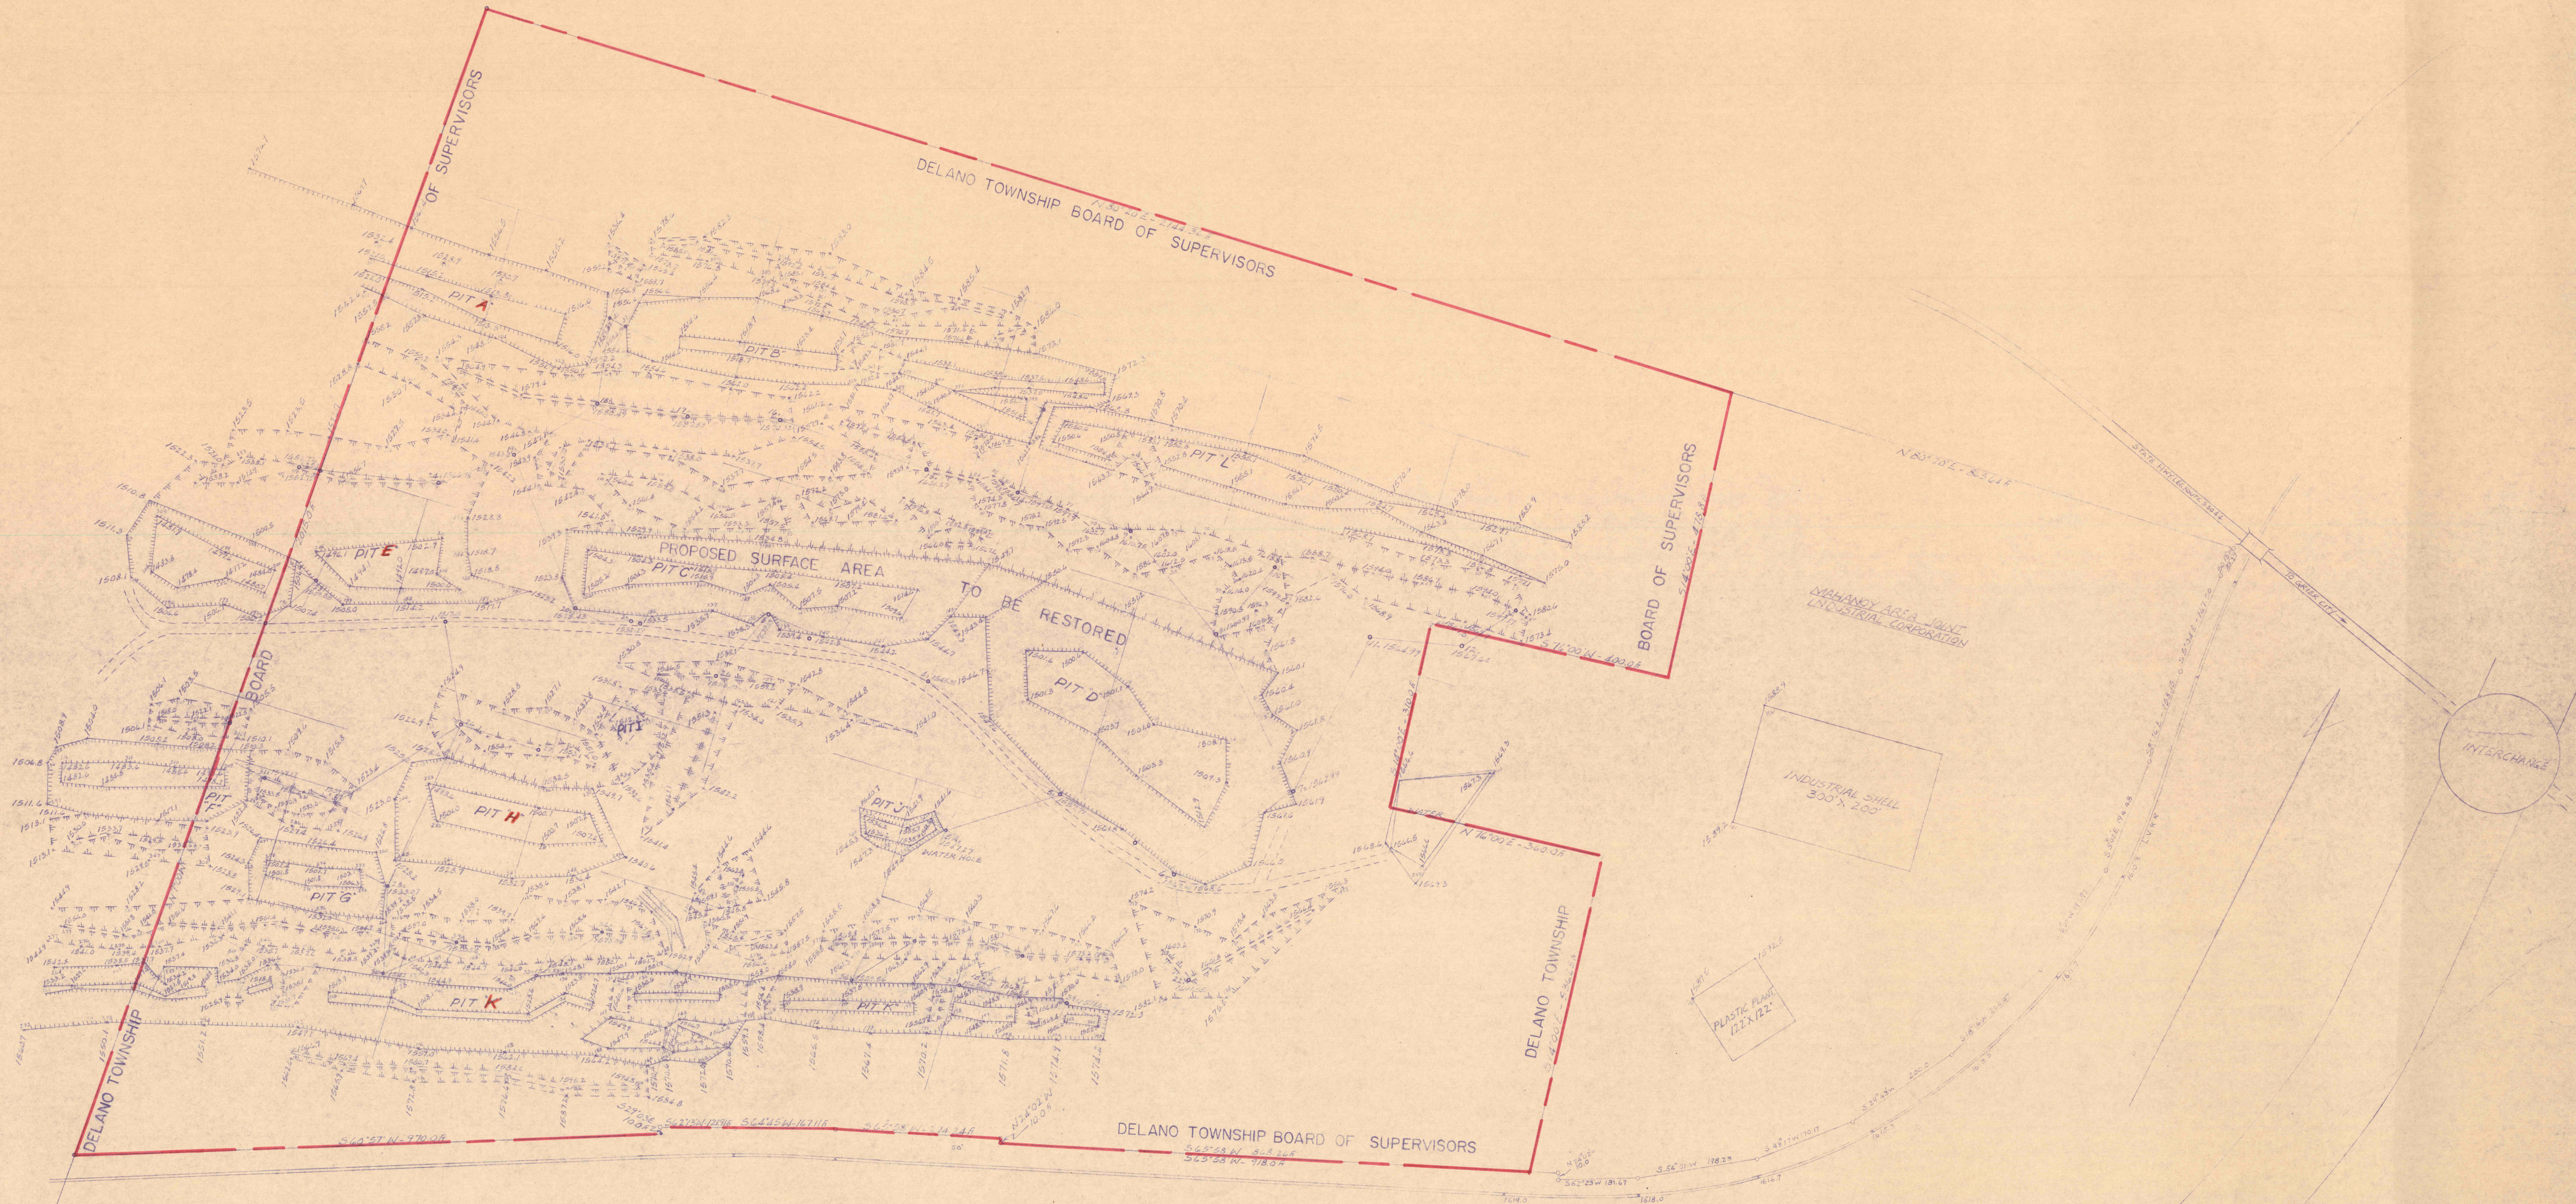

Western Middle Field, Delano Colliery.
 "SURFACE 1"=100'. A.S.M.P.#3. OLD PITS-BACK-FILLED."
 DELANO Twp, SCHUYLKILL COUNTY, PA. E. MAHANOY #10 DISTRICT.
 .. SHEET: 2 OF 2.