


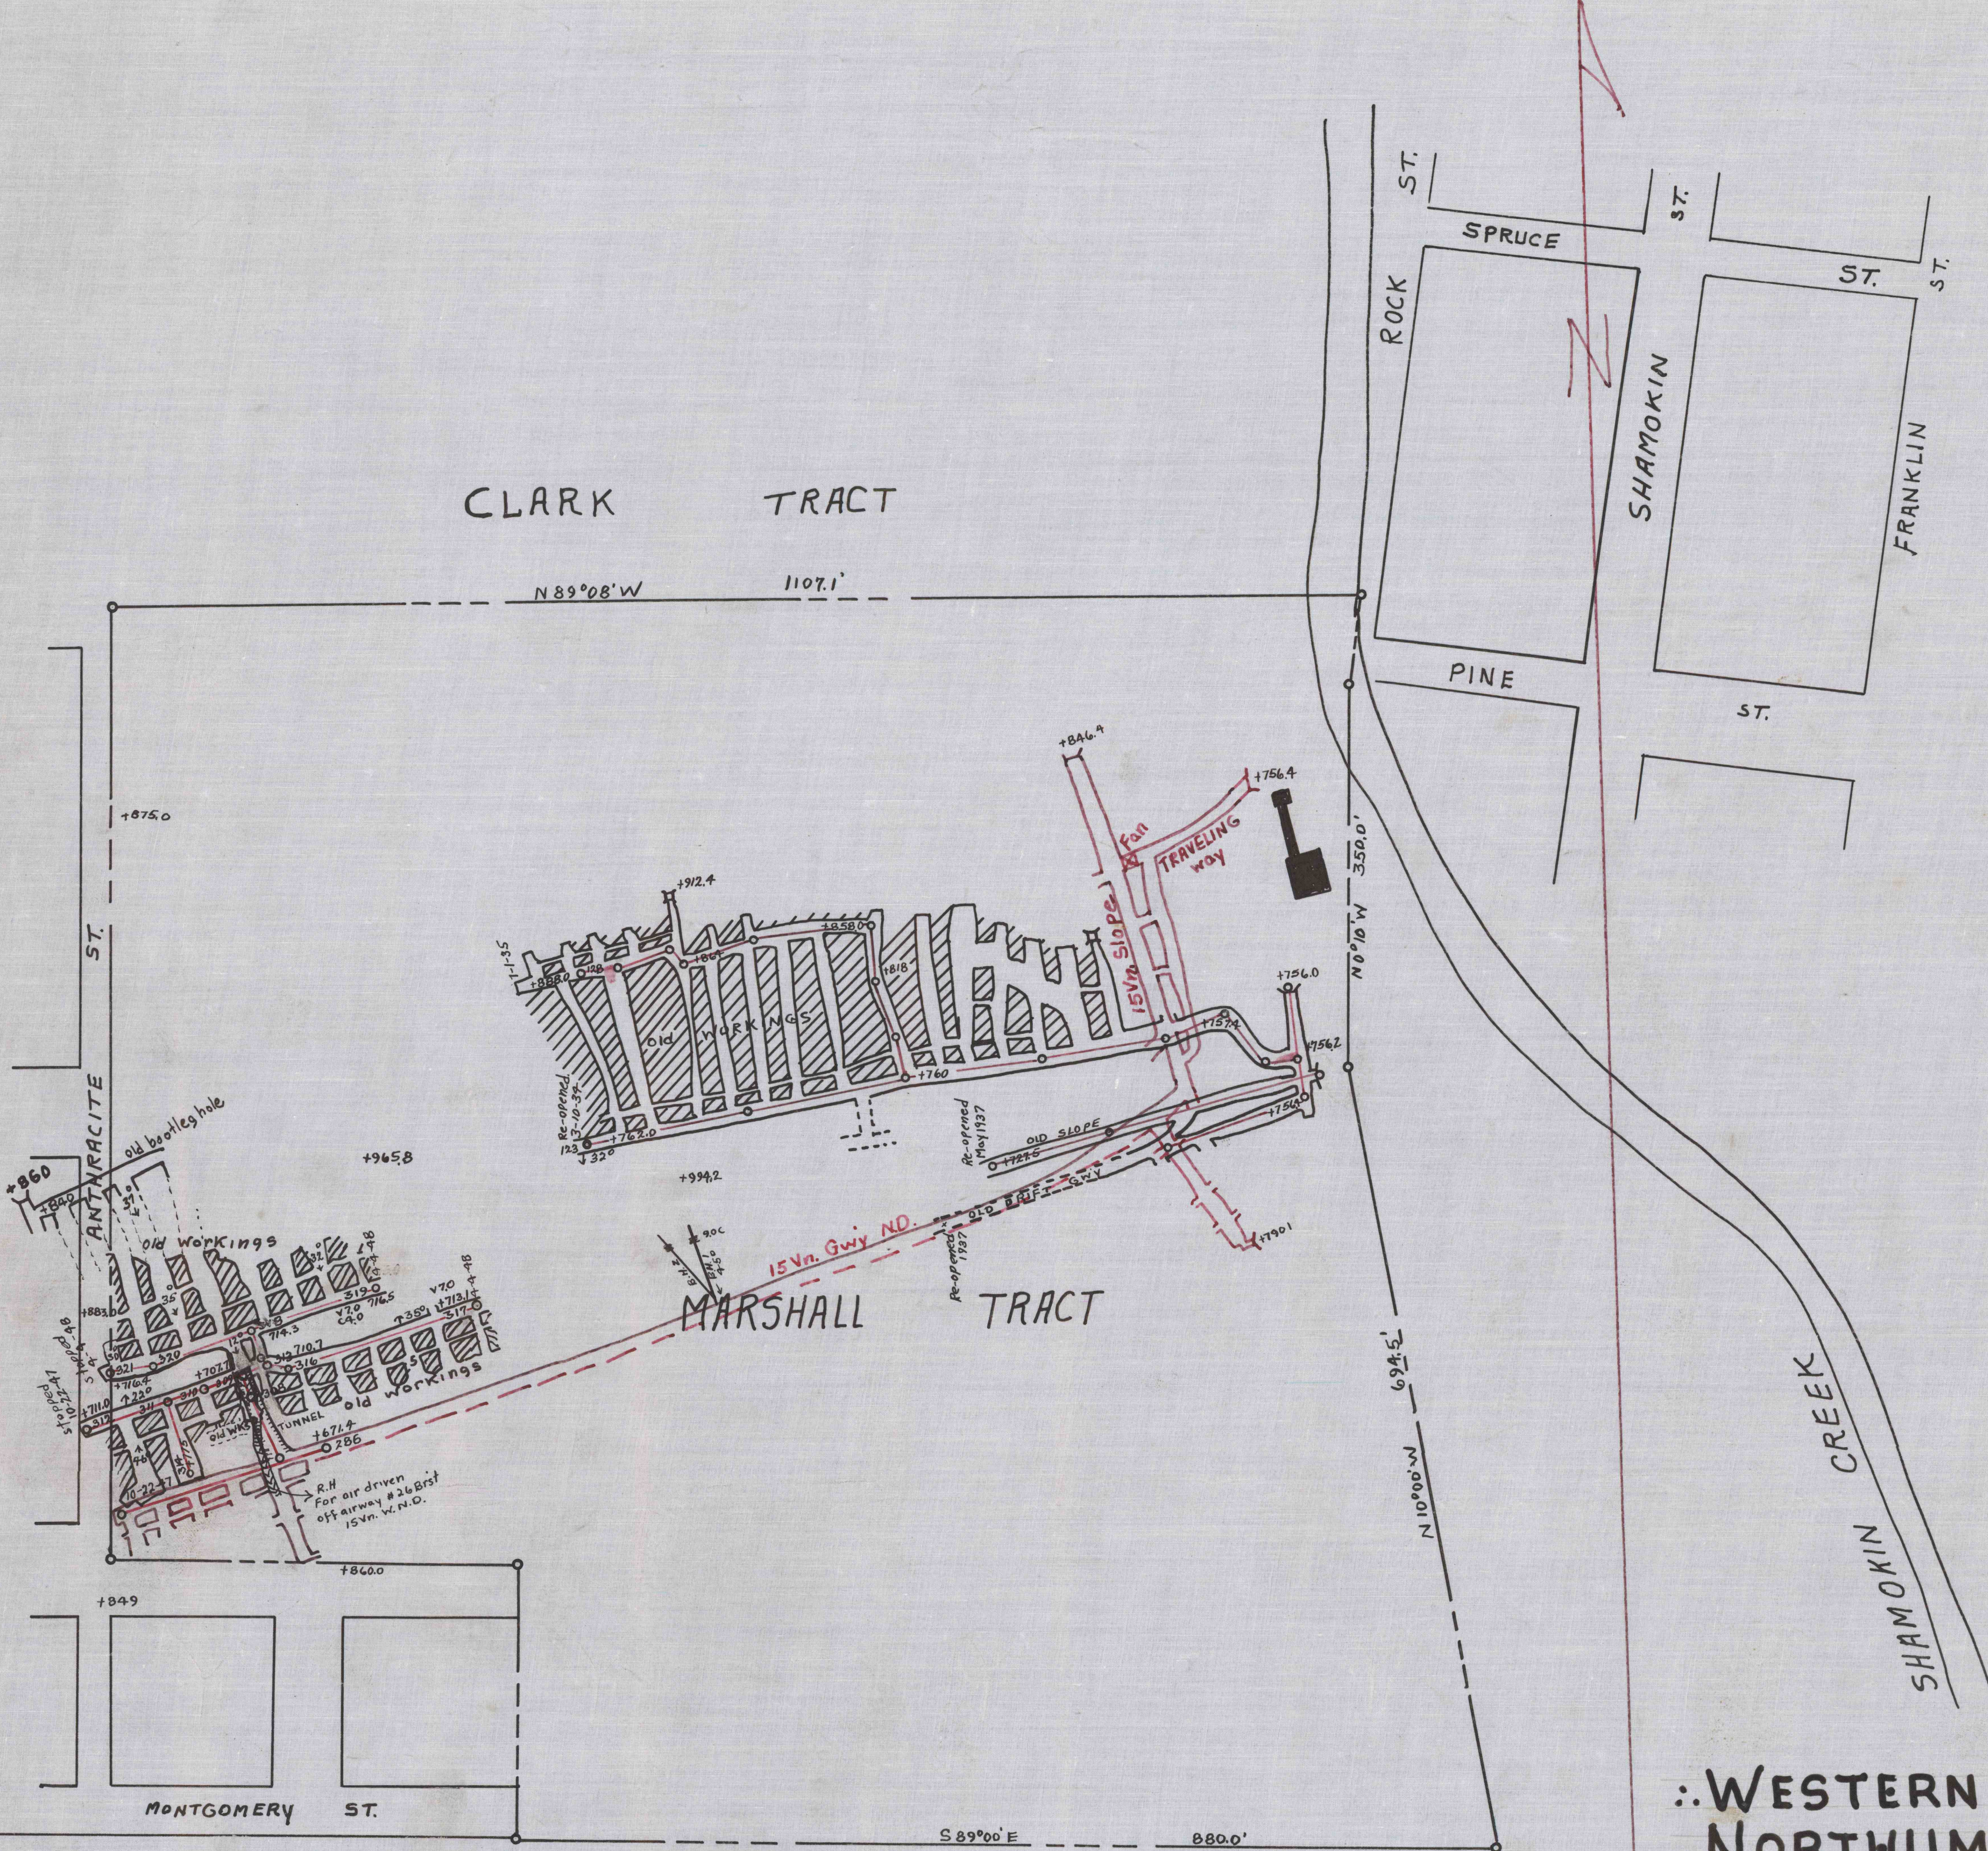

WESTERN Middle COAL FIELD:
NORTHUMBERLAND COUNTY

16VEIN MINE WORKINGS.

DANCOTT COAL CO.

SHAMOKIN PA.

SCALE 1" = 100'

NOV 16 1972

POSTED TO April 4 1948