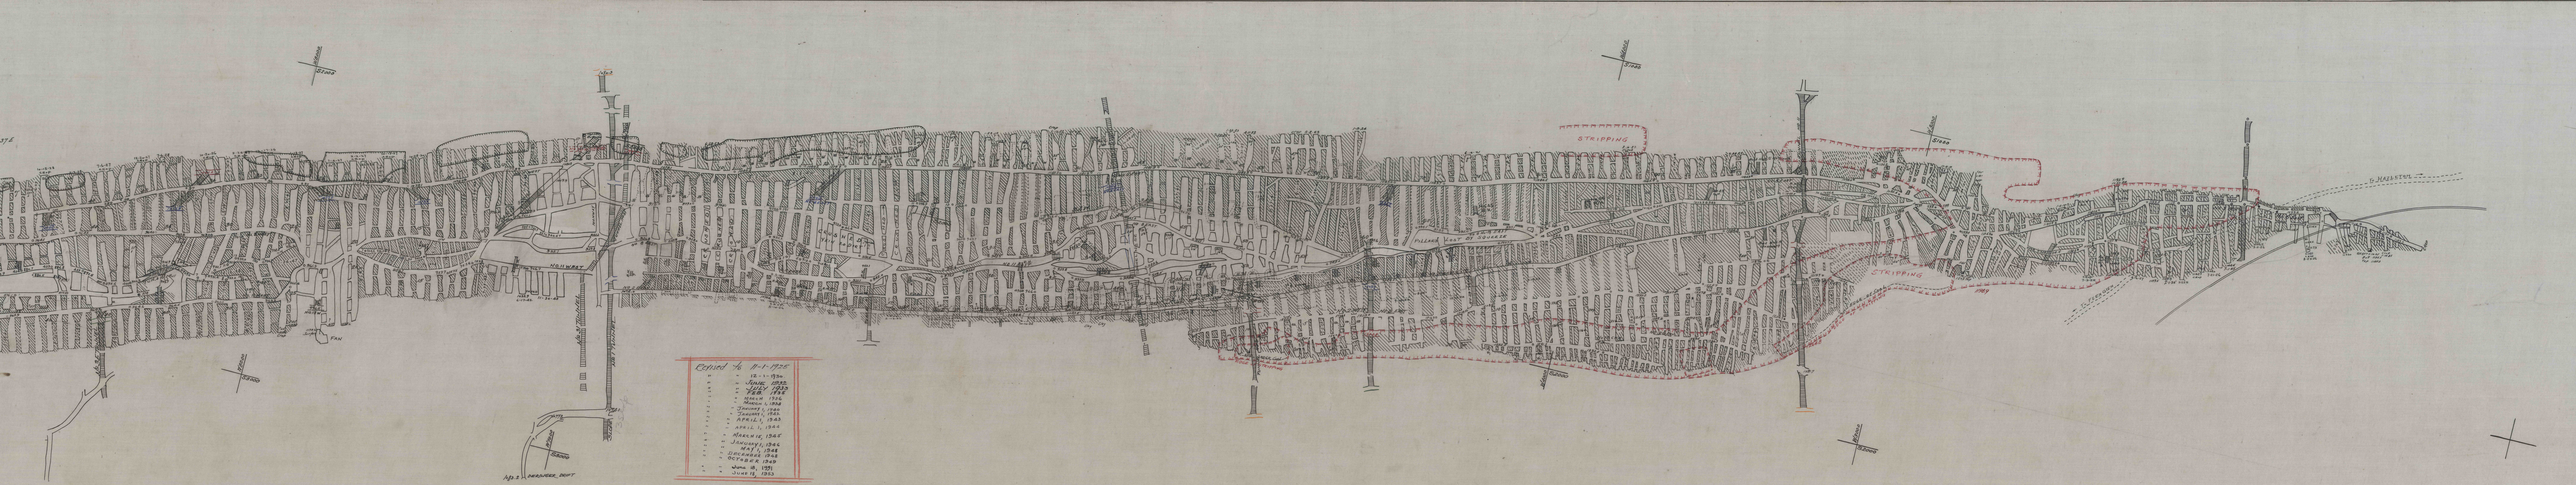
STRIPPING
STRIPPING
19-11-1934
JUNE, 1935
JULY, 1935
MAY, 1936
MARCH, 1942
JANUARY, 1942
MARCH, 1943
APRIL, 1943
APRIL 1, 1944
MARCH 15, 1945
JANUARY, 1946
MAY 1, 1948
DECEMBER, 1948
OCTOBER, 1949
JUNE 8, 1951
JUNE 11, 1953
NF
NOV 8 1972