


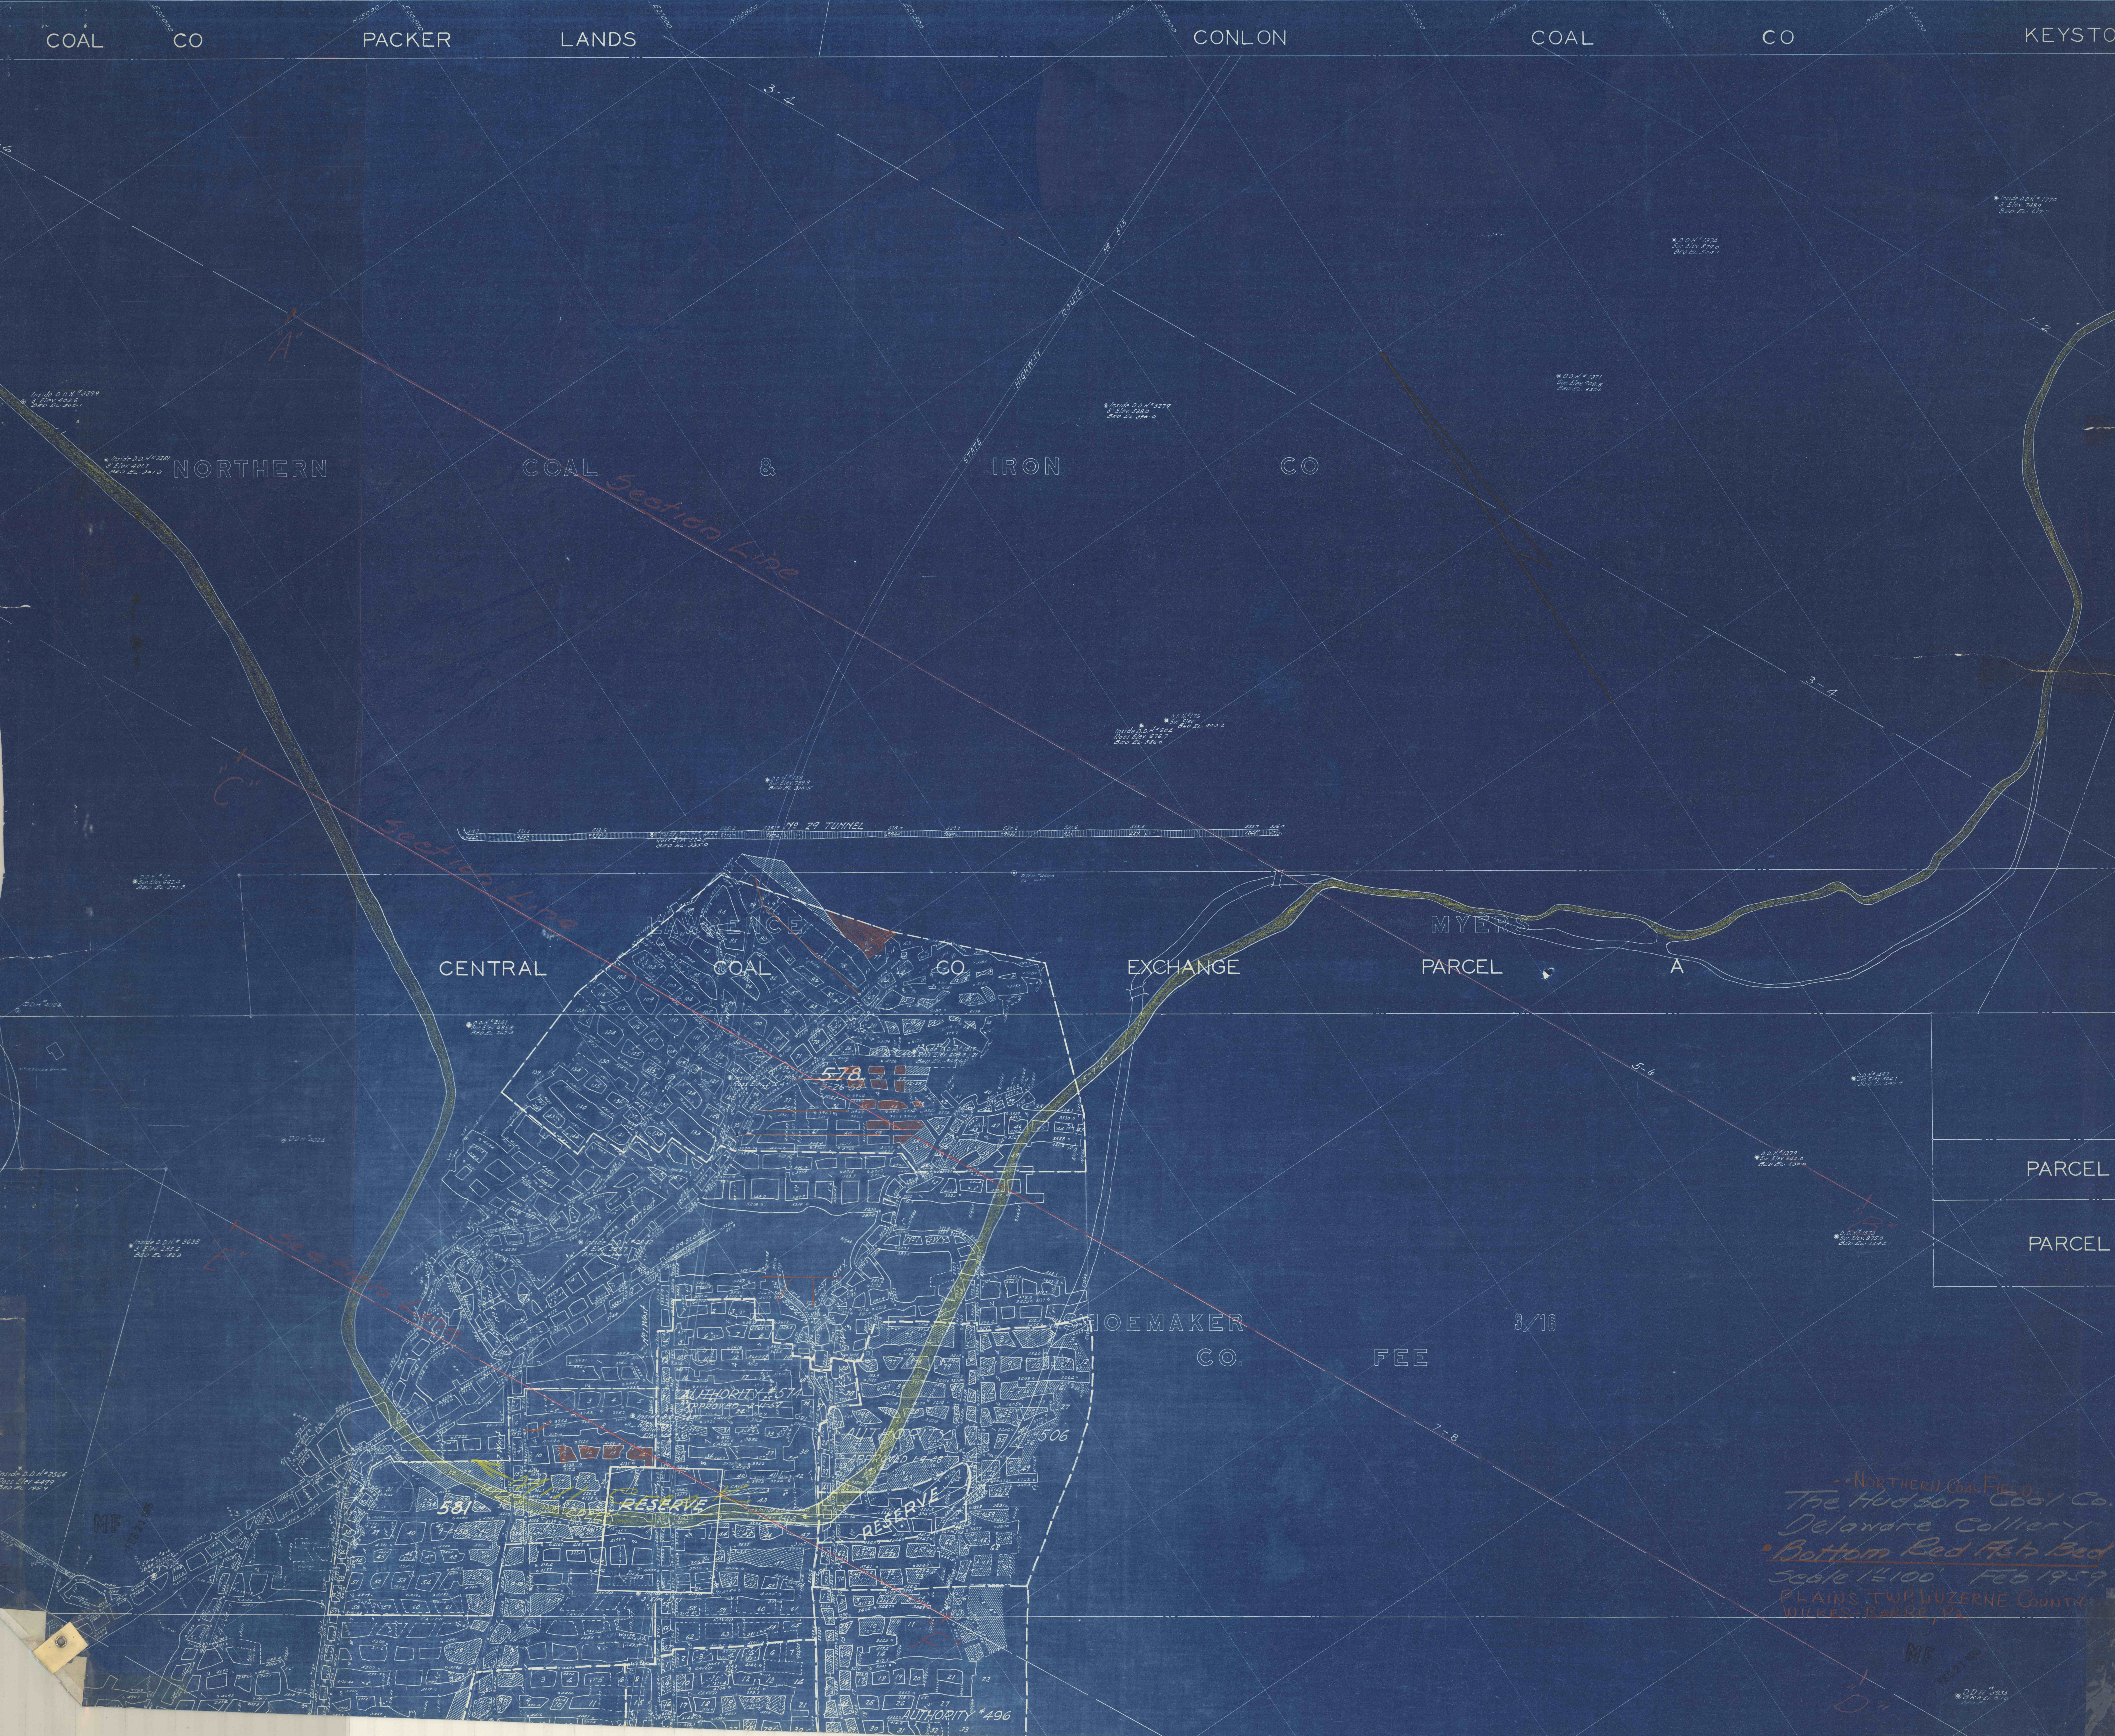

COAL CO PACKER LANDS CONLON COAL CO KEYSTO

A

NORTHERN

COAL

&

IRON

CO

Section Line

C

Section Line

CENTRAL

COAL

CO

EXCHANGE

MYERS

PARCEL

A

PARCEL

PARCEL

HOEMAKER
CO.

FEE

3/16

- NORTHERN Coal Field
The Hudson Coal Co.
Delaware Colliery
Bottom Red Flat Bed
Scale 1"=100' Feb 1959
PLAINS TWP WUZERNE COUNTY
WILKES-BARRE, PA.

MF

D

MS 29 TUNNEL

RESERVE

RESERVE

AUTHORITY #574

AUTHORITY #506

581

AUTHORITY #496