


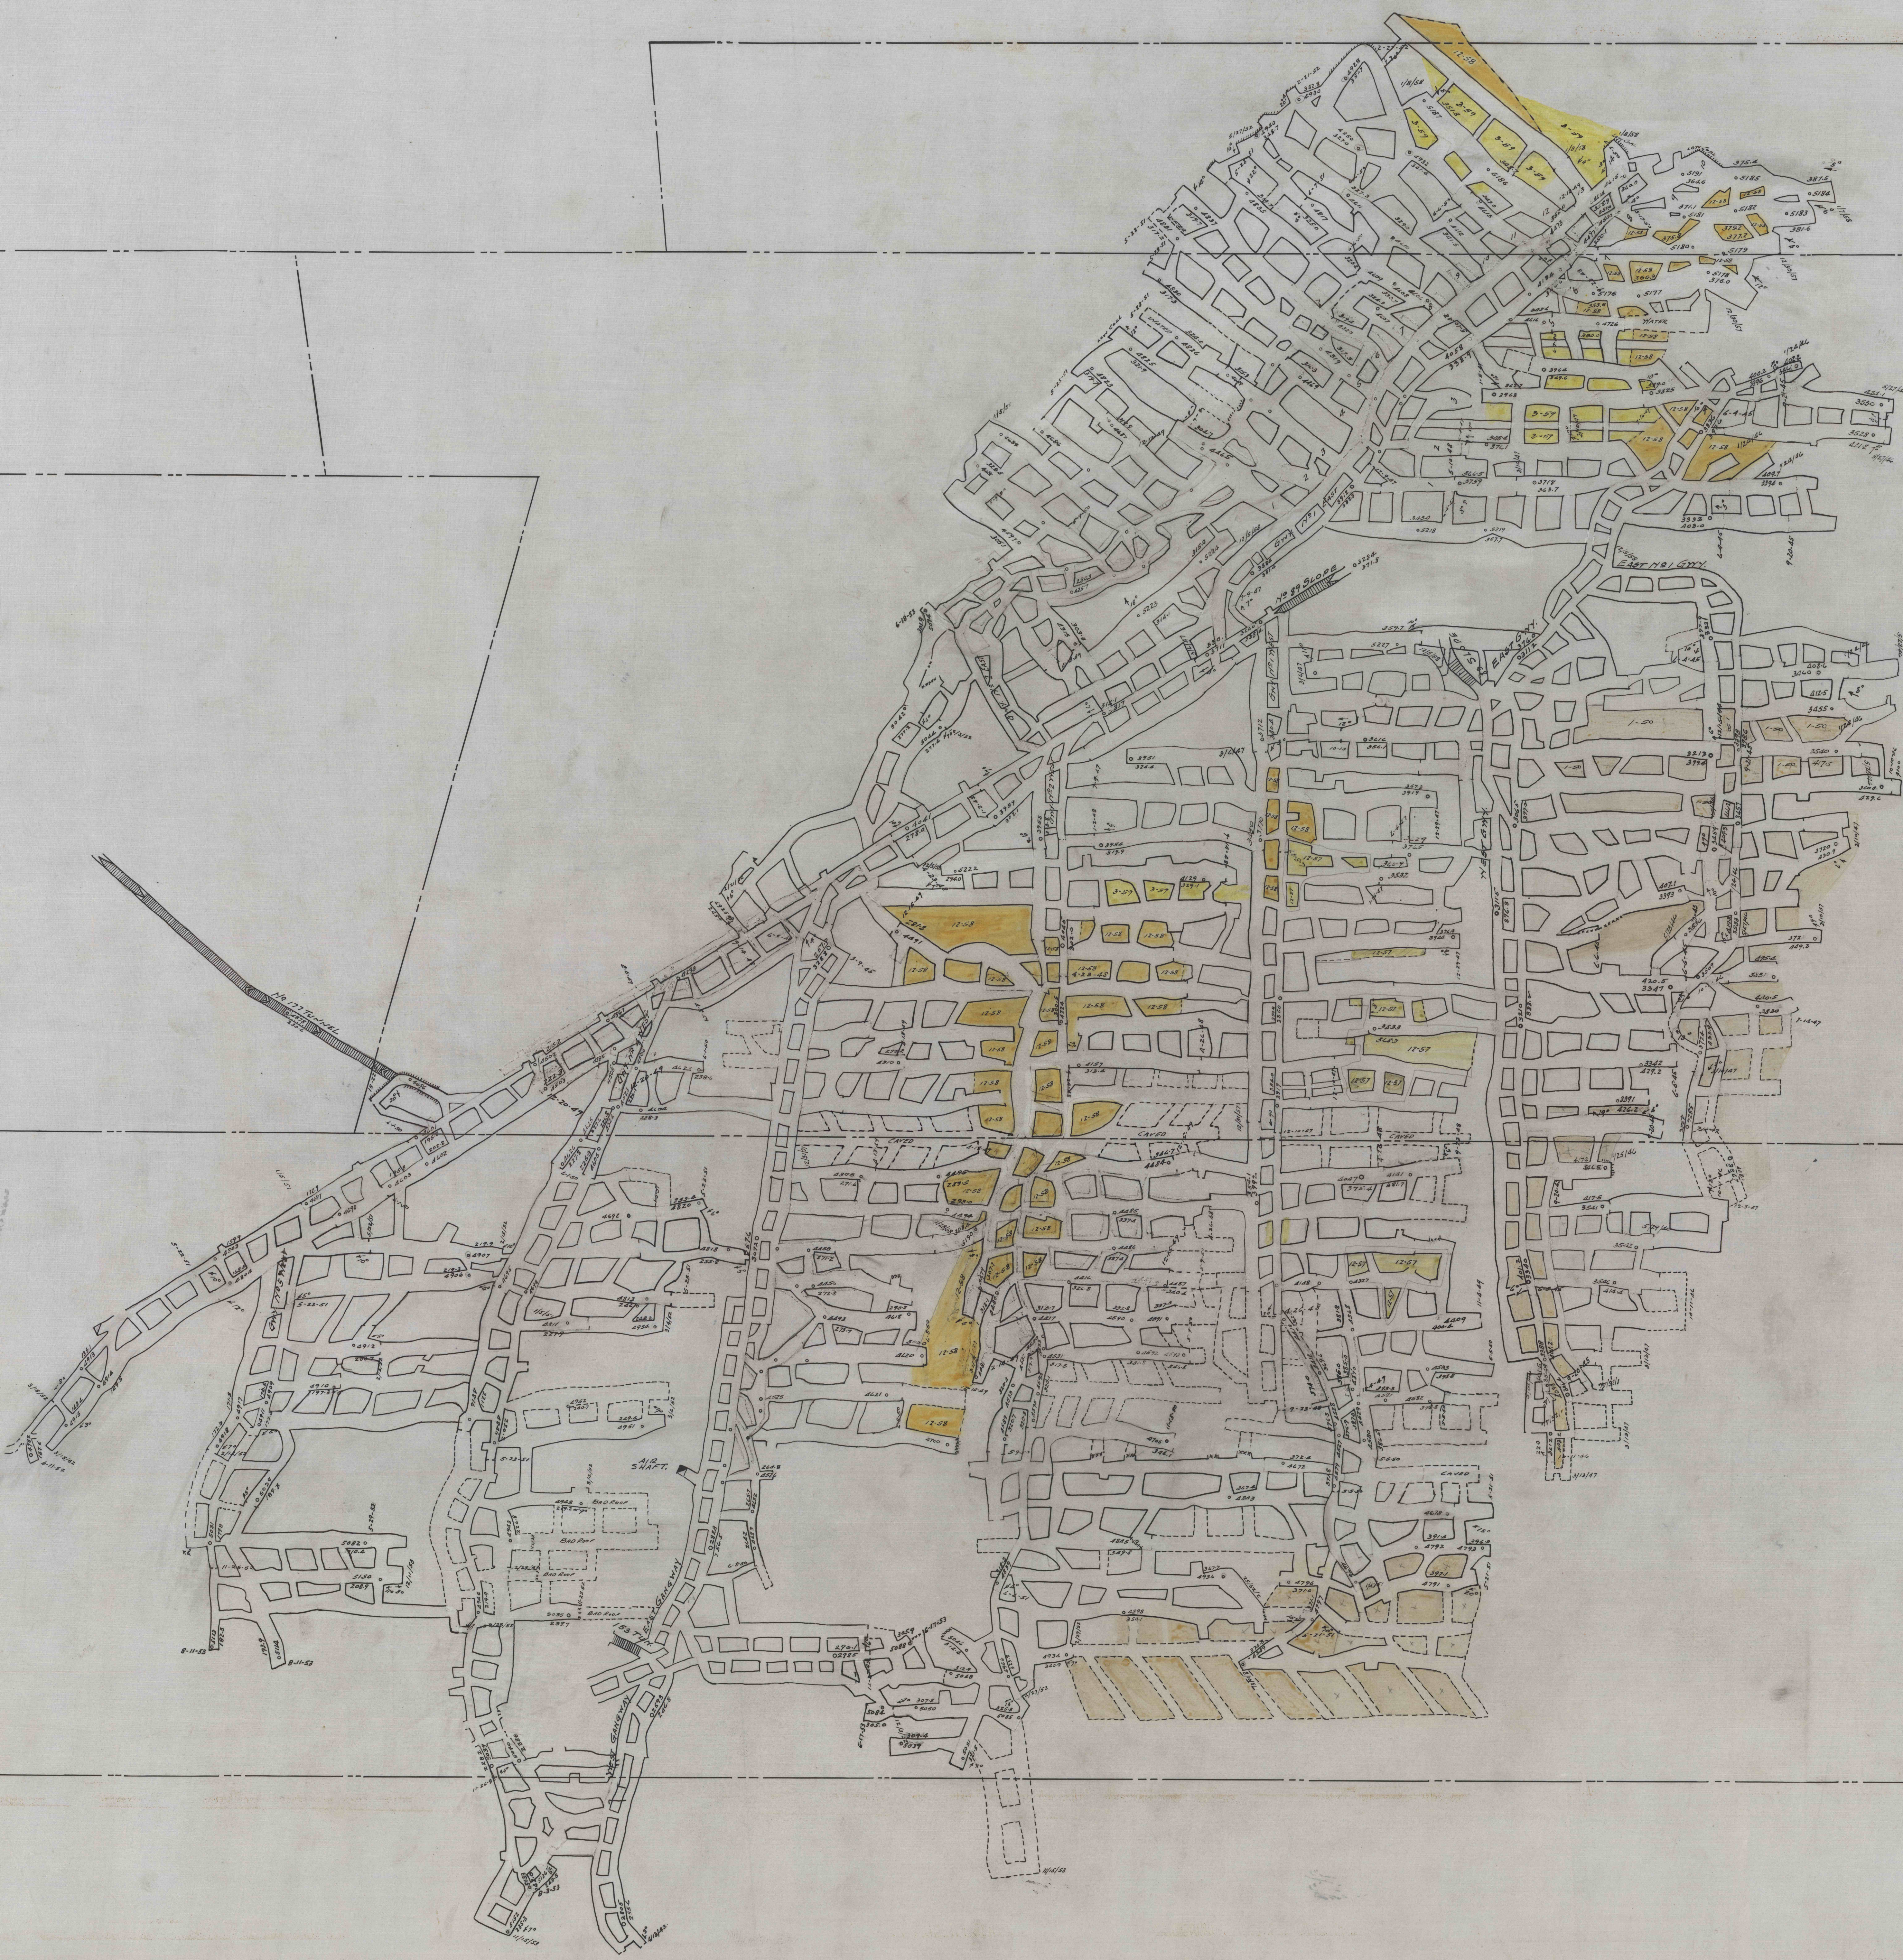

CENTRAL COAL CO.
L.D.S. 3/6

L.D.S. 3/6
B & P

DATE POSTED	BY
JULY 20 - 1945	L. Mosher
OCT. 26 - 1945	M. Giles
MARCH 15th - 1945	D. CARSWELL
AUGUST 5, 1946	D. CARSWELL
NOV. 29, 1946	G. GALT
MAR. 31, 1947	G. GALT
AUG. 11th, 1947	D. CARSWELL
JAN. 20th 1948	F. WILLIS
JUNE 4th 1948	L. MOSHER
DECEMBER 10th 1948	F. WILLIS
FEBRUARY 6th 1949	D. CARSWELL
JANUARY 5, 1951	F. MARCON
JULY 25, 1951	F. WILLIS
APRIL 30, 1952	F. WILLIS
JANUARY 24, 1952	D. CARSWELL
JANUARY 6th 1954	F. WILLIS

NORTHE
DELA
-RE
MINE I.
MINING &
PLAINS T
WILKES-E
..20F2 TR