


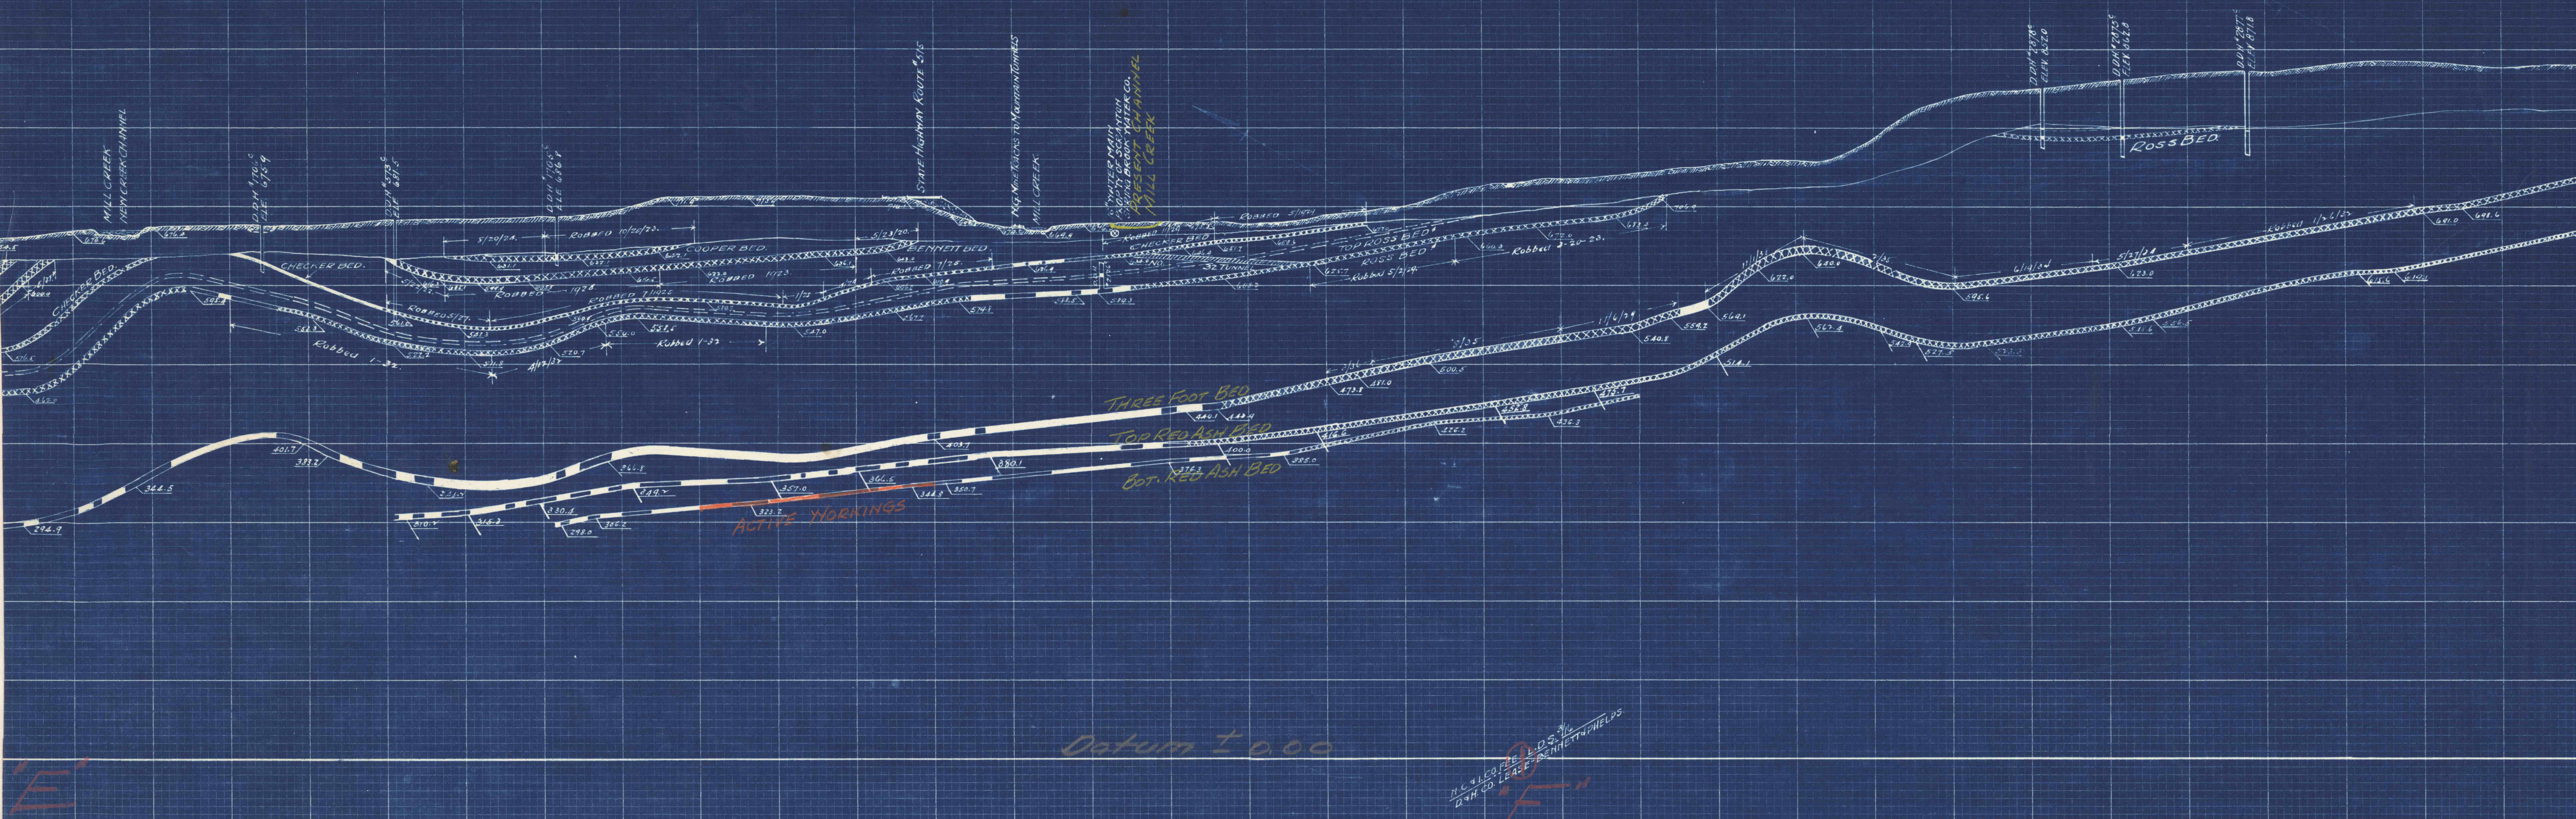

The Hudson Coal Co
 DELAYARE AND LAUREL RUN COLL'YS.
 CROSS-SECTION THRU COAL MEASURES.
 SCALE 100' TO 1"
 OCT. 1931.
 FEB 21 1935