


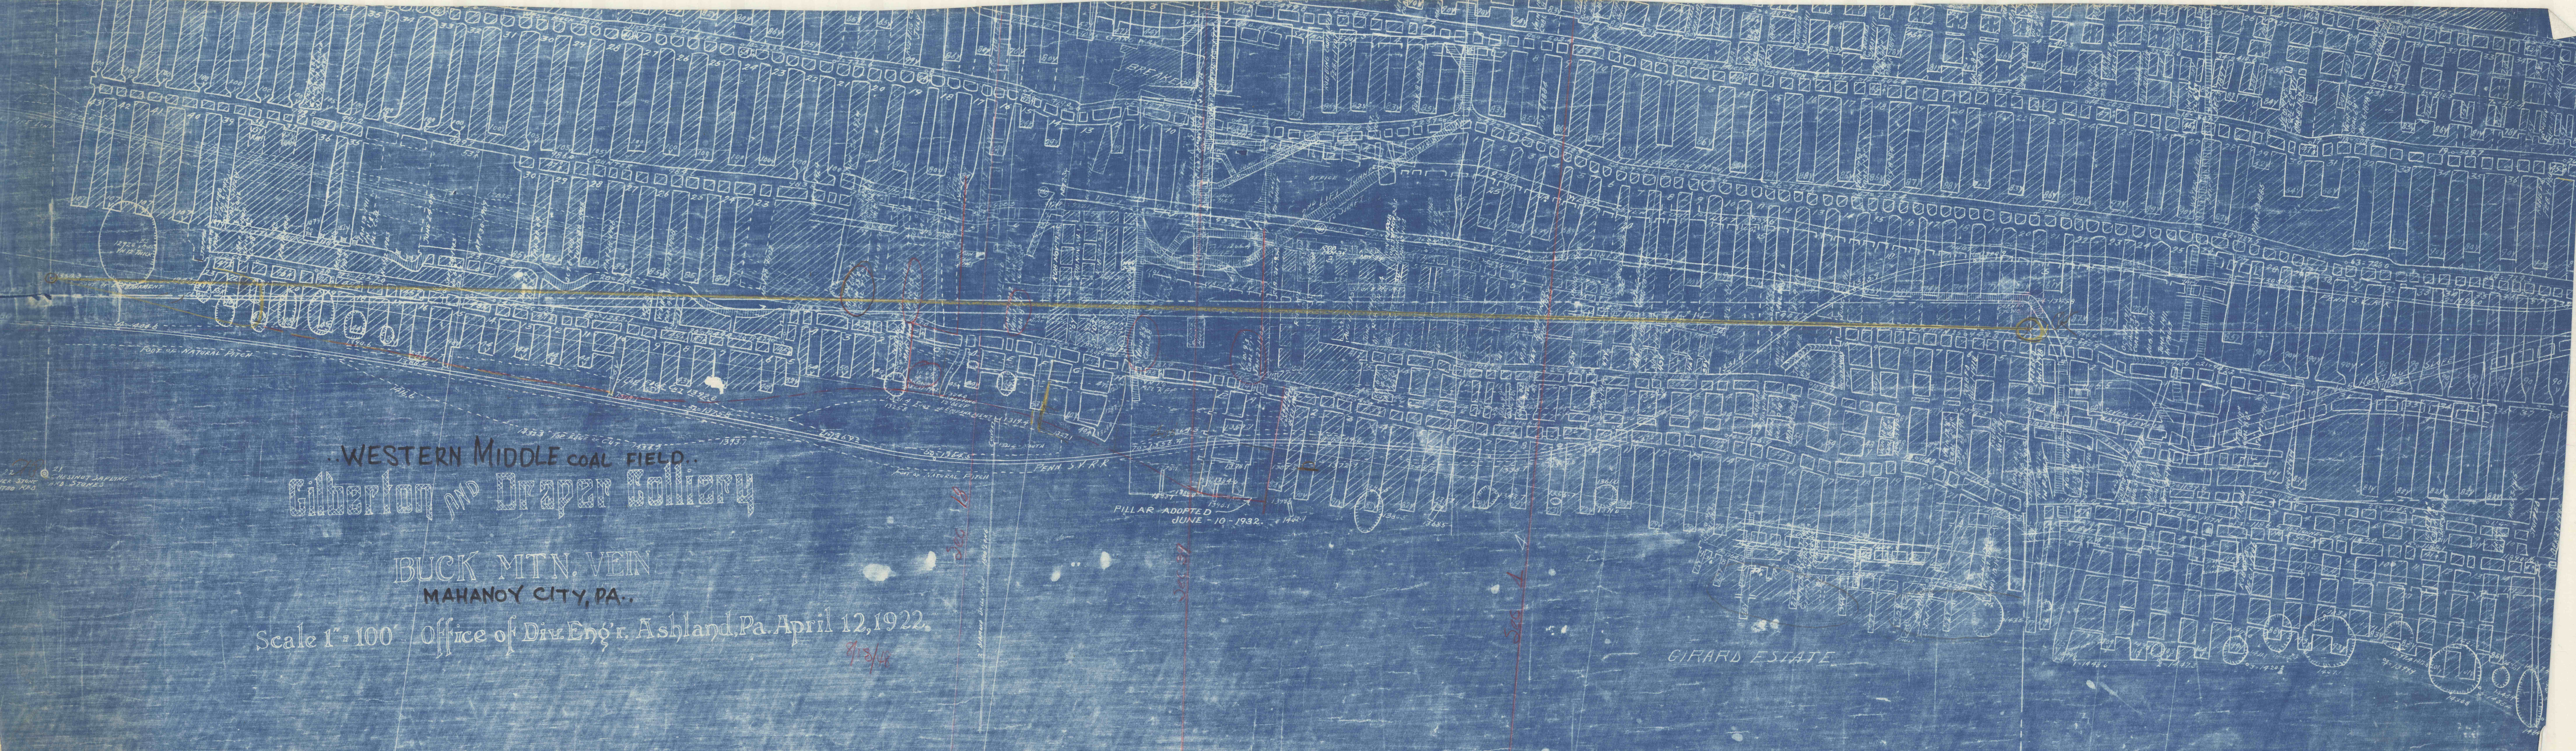

WESTERN MIDDLE COAL FIELD.
Gibberton and Draper Colliery

BUCK MTN. VEIN
MAHANOT CITY, PA.

Scale 1" = 100' Office of Div. Eng'r. Ashland, Pa. April 12, 1922.

PENN. S. F. R.
PILLAR ADOPTED
JUNE - 10 - 1932.

GIRARD ESTATE