


Duryea Anthracite Co.  
Dupont Basin  
Hawk Red Ash Vein  
Scale - 1"=100'  
NORTHERN FIELD,  
LUZERNE COUNTY,  
WYOMING REGION -  
WILKES-BARRE, PA.

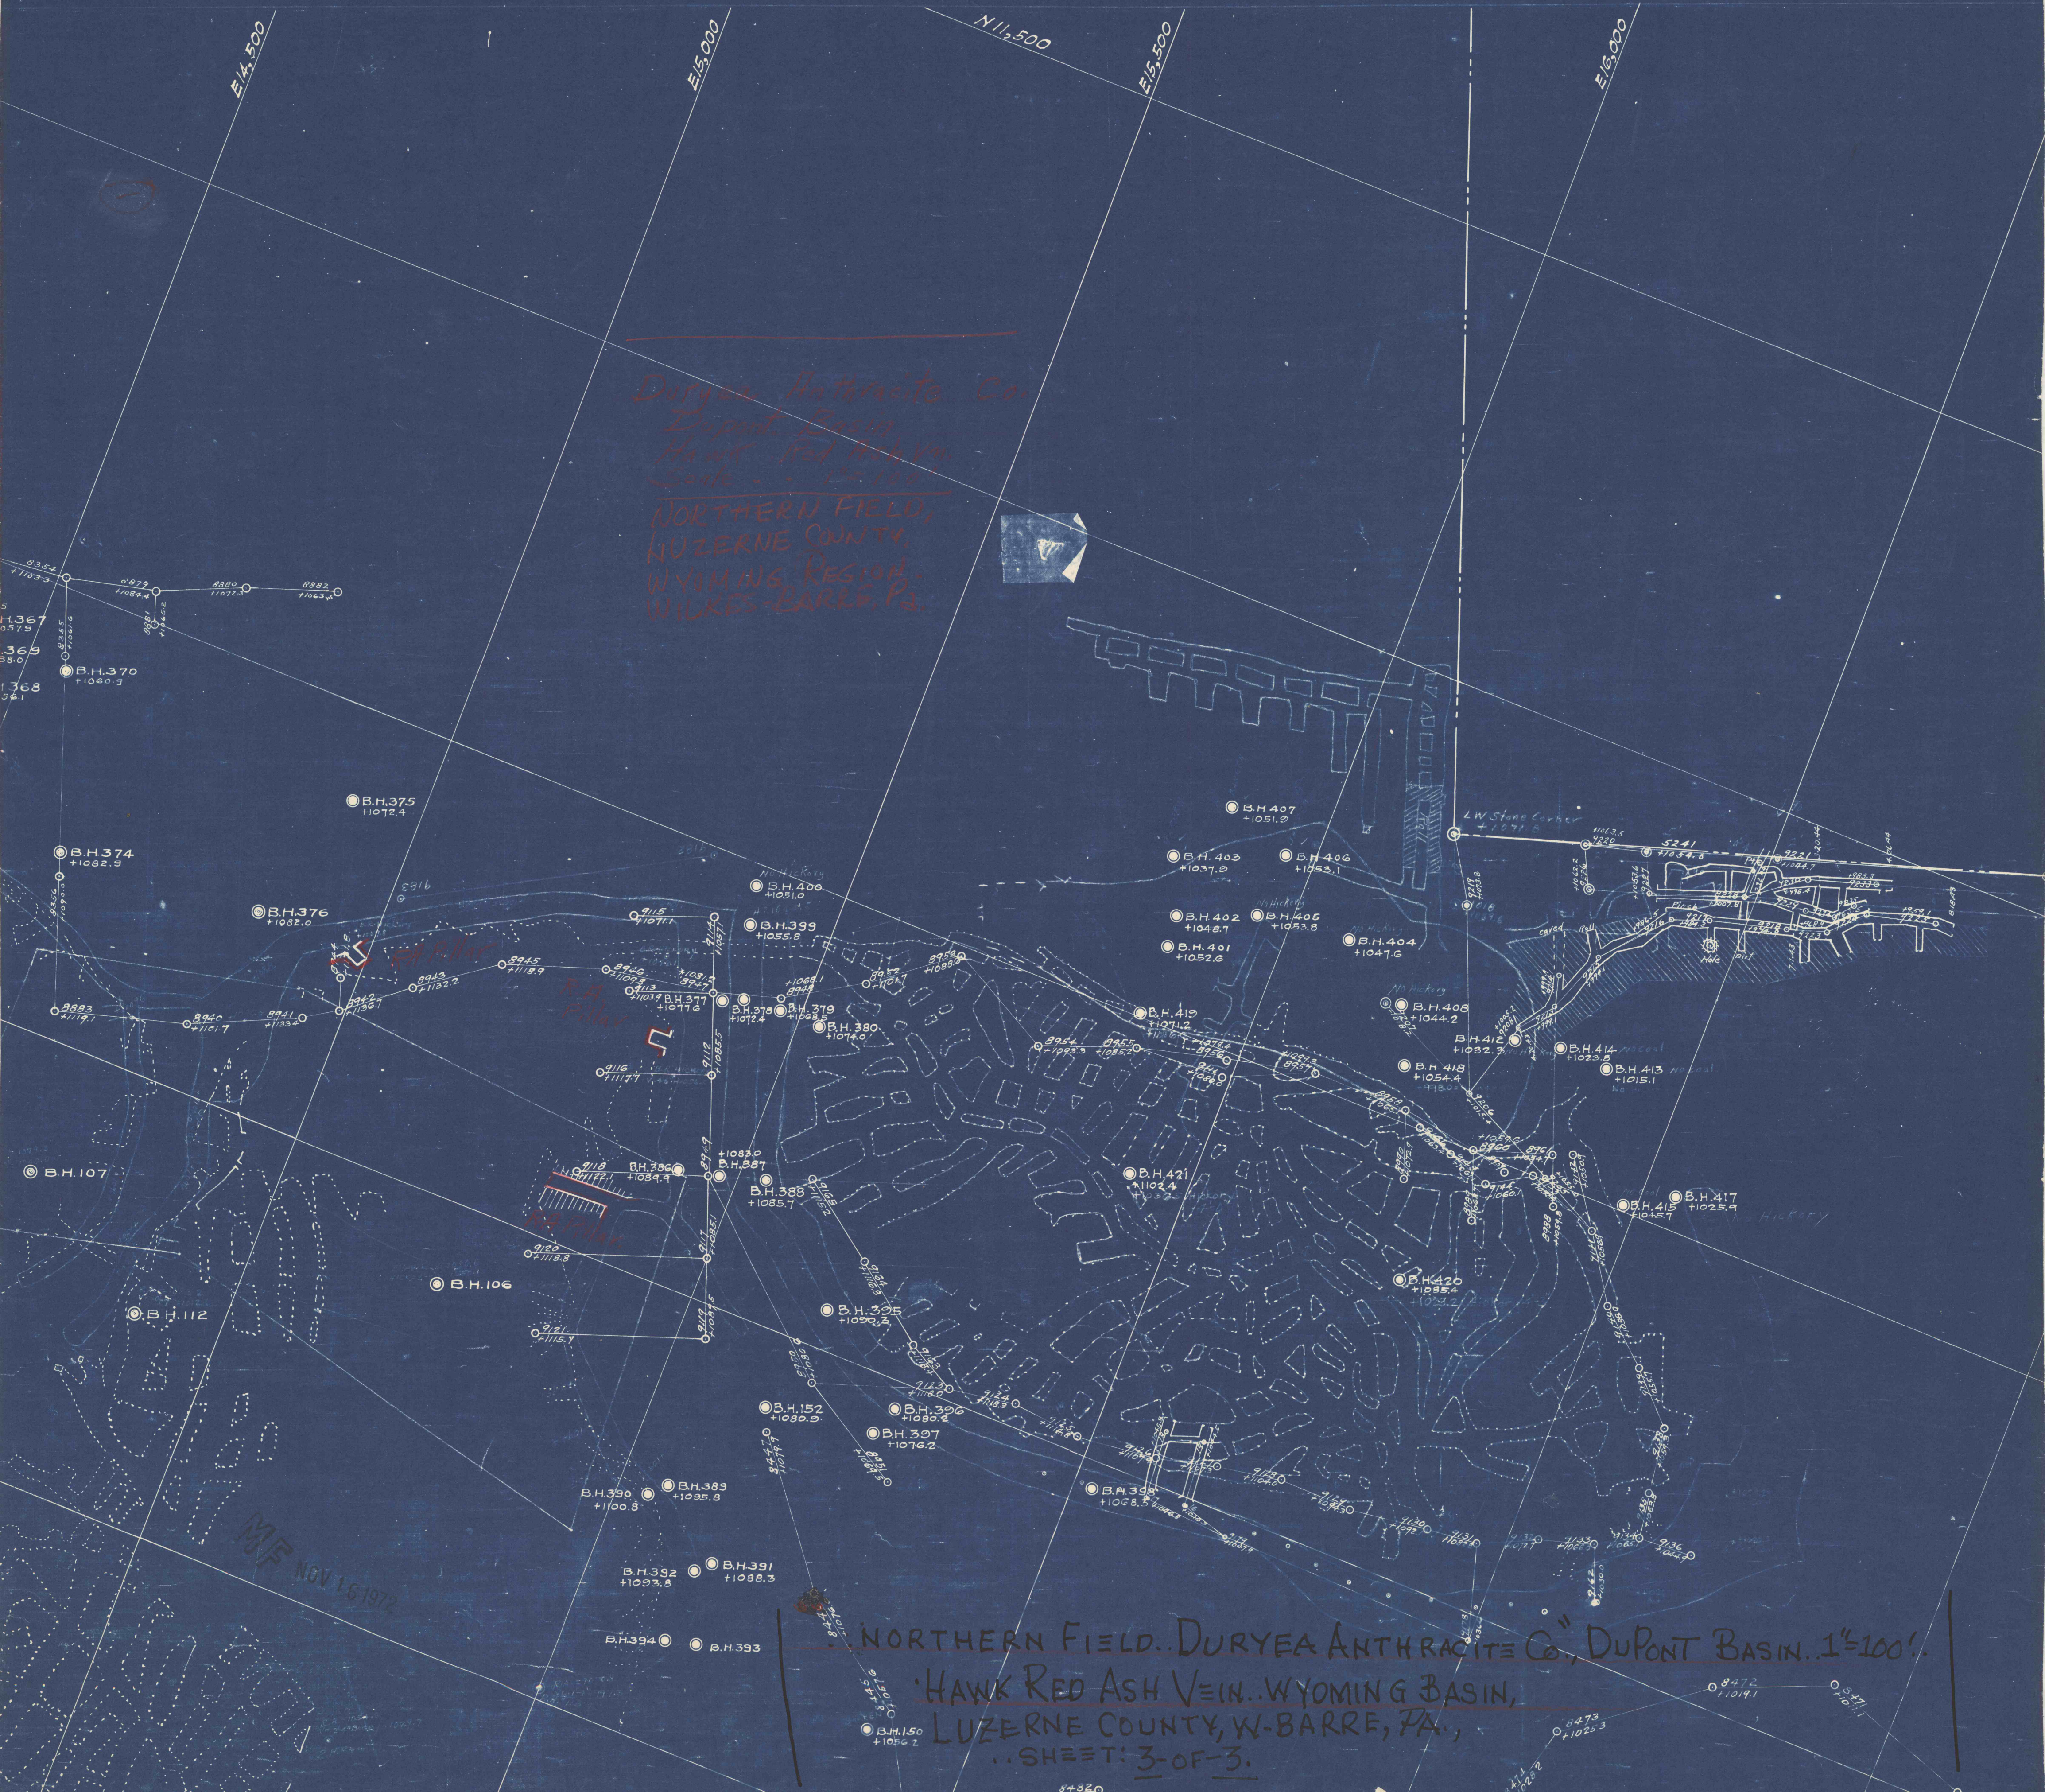

NORTHERN FIELD. DURYEA ANTHRACITE CO., DUPONT BASIN. 1"=100'.  
HAWK RED ASH VEIN. WYOMING BASIN,  
LUZERNE COUNTY, W-BARRE, PA.,  
SHEET: 3-OF-3.