


FOSTER TOWNSHIP

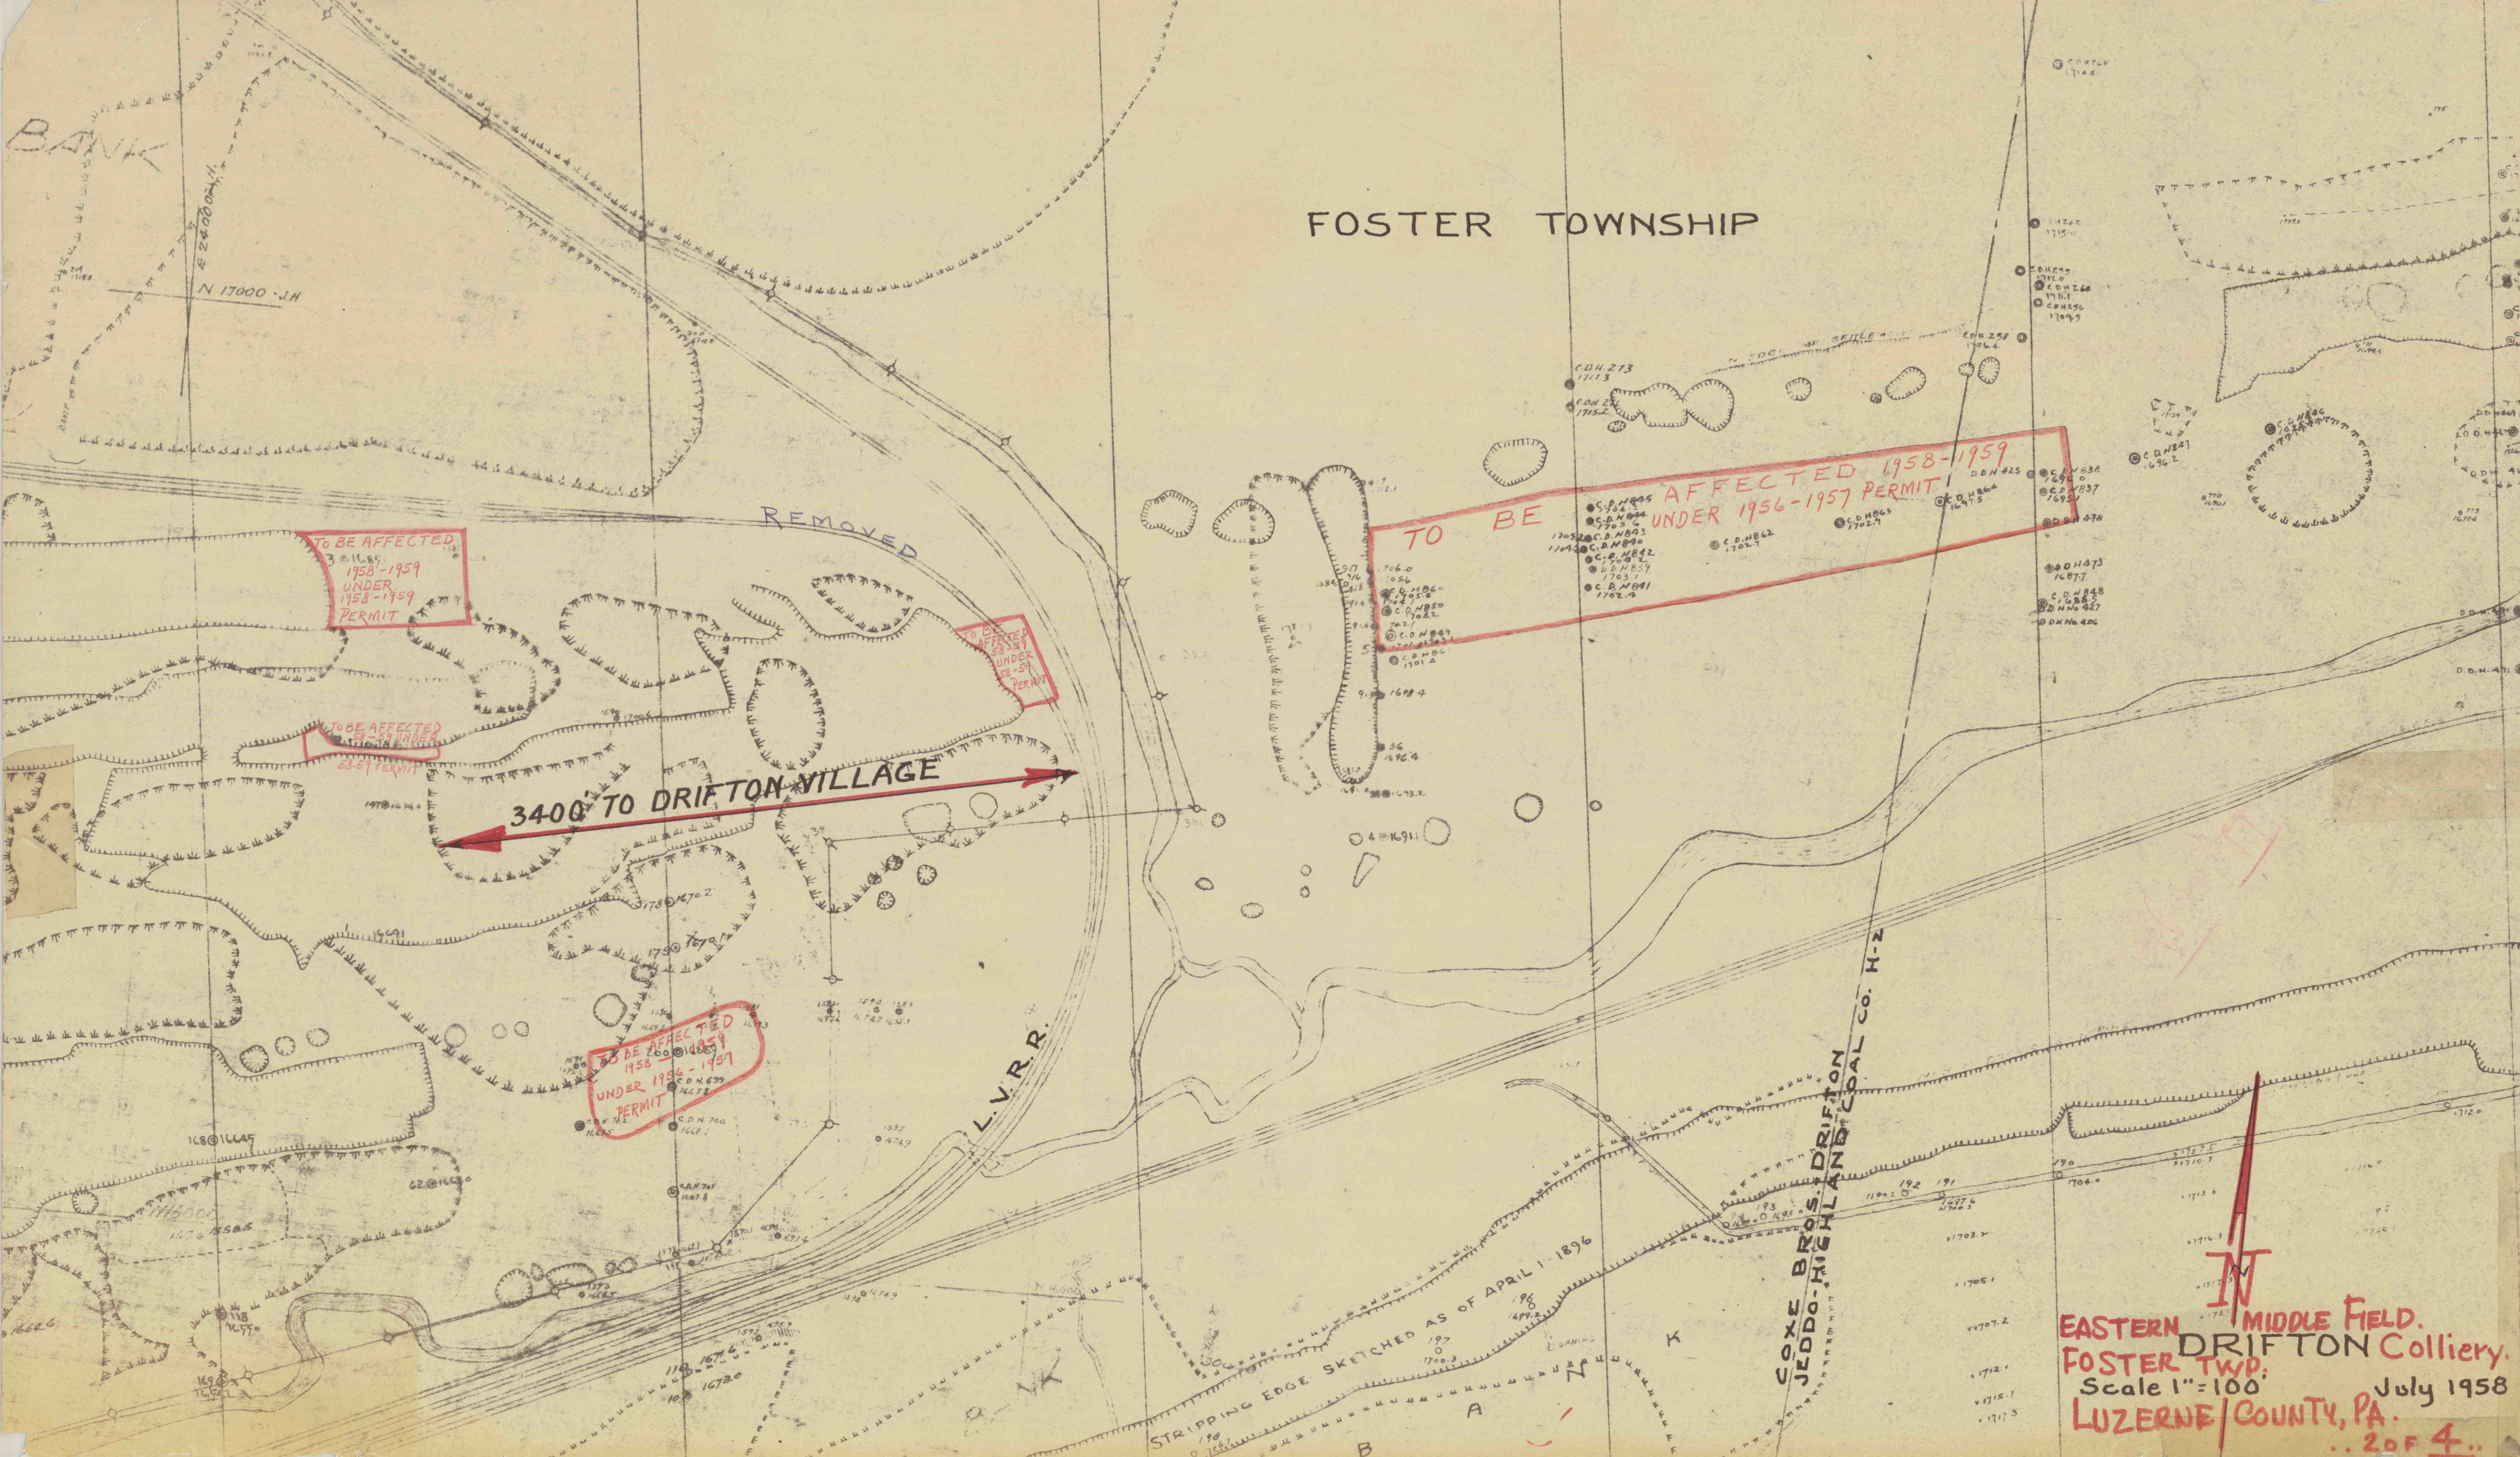

TO BE AFFECTED
1958-1959
UNDER
1958-1959
PERMIT

TO BE AFFECTED
1958-1959
UNDER
1958-1959
PERMIT

TO BE AFFECTED
1958-1959
UNDER
1958-1959
PERMIT

TO BE AFFECTED
1958-1959
UNDER
1956-1957 PERMIT

3400 TO DRIFTON VILLAGE

STRIPPING EDGE SKETCHED AS OF APRIL 1-1896

COXE BROS. DRIFTON
JEDDO-HIGHLAND COAL CO. H-2

EASTERN MIDDLE FIELD
FOSTER TWP. DRIFTON Colliery.
Scale 1"=100' July 1958
LUZERNE COUNTY, PA.
.. 2 of 4 ..