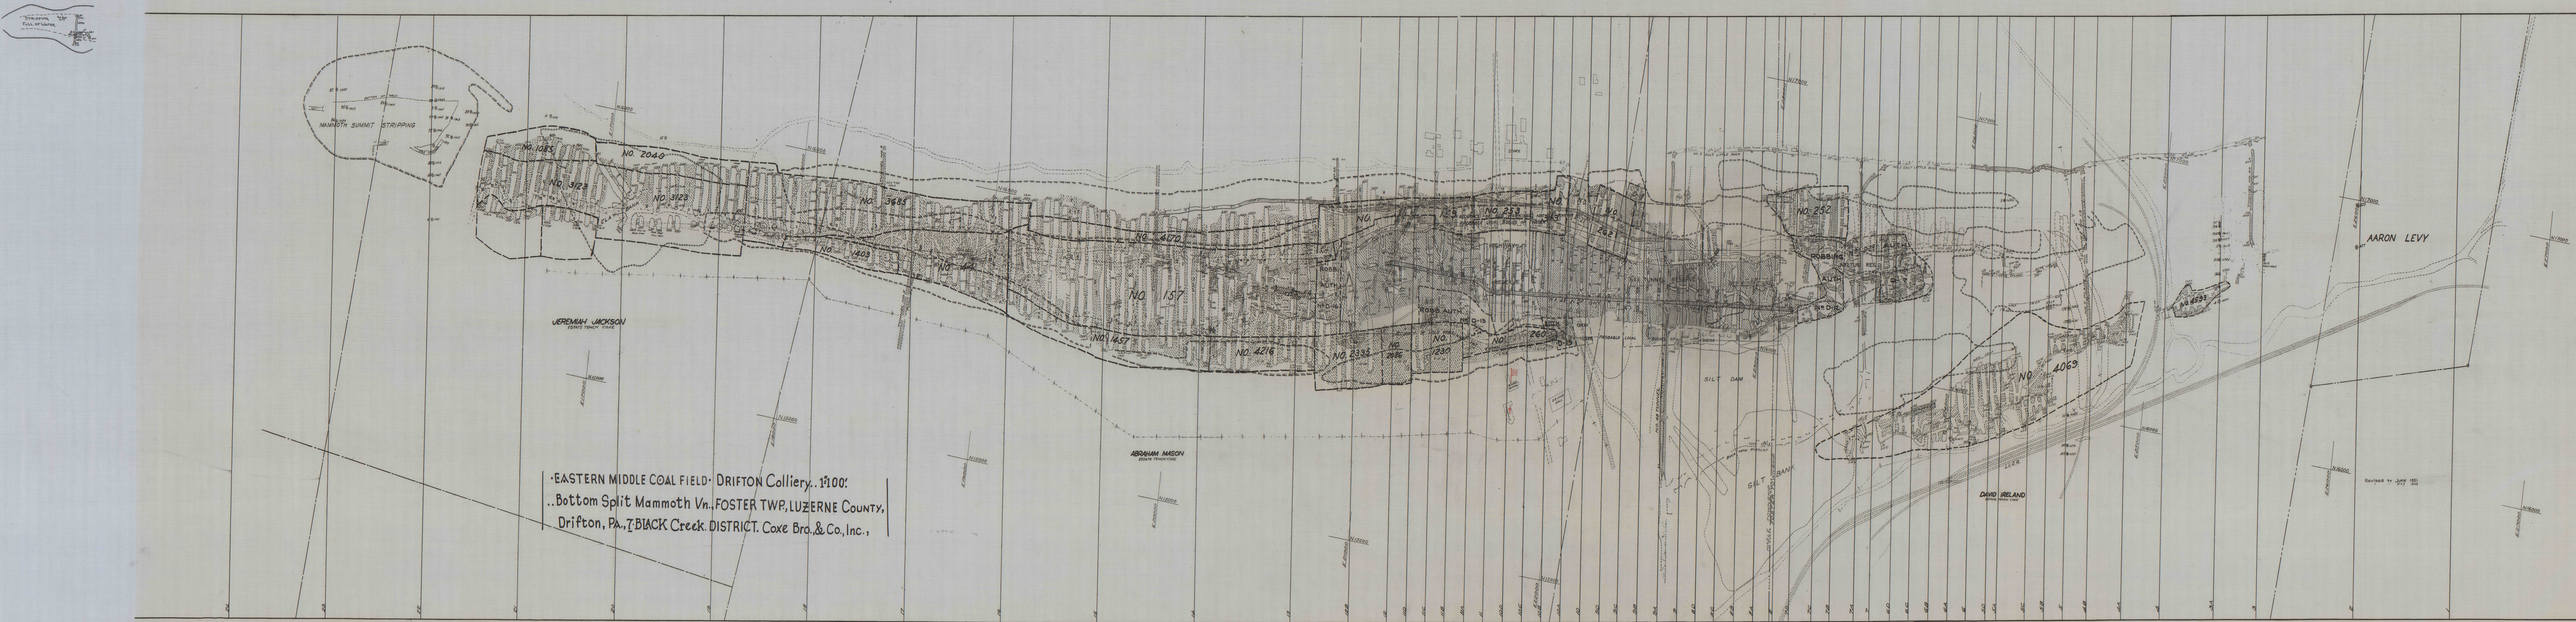
MAMMOTH SUMMIT STRIPPING
NO. 1085
NO. 2049
NO. 3123
NO. 3123
NO. 3685
NO. 1409
NO. 470
NO. 482
NO. 517
NO. 457
NO. 4216
NO. 2333
NO. 285
NO. 720
NO. 233
NO. 262
NO. 4693
NO. 4069
JEREMIAH JACKSON
ABRAHAM MASON
DAVID IRELAND
AARON LEVY
ROSS AUX
SILT DAM
SILT BANK
·EASTERN MIDDLE COAL FIELD· DRIFTON Colliery.. 1"=100'
..Bottom Split Mammoth Vn., FOSTER TWP, LUZERNE County,
Drifton, Pa., BLACK Creek DISTRICT. Coxe Bro. & Co., Inc.,