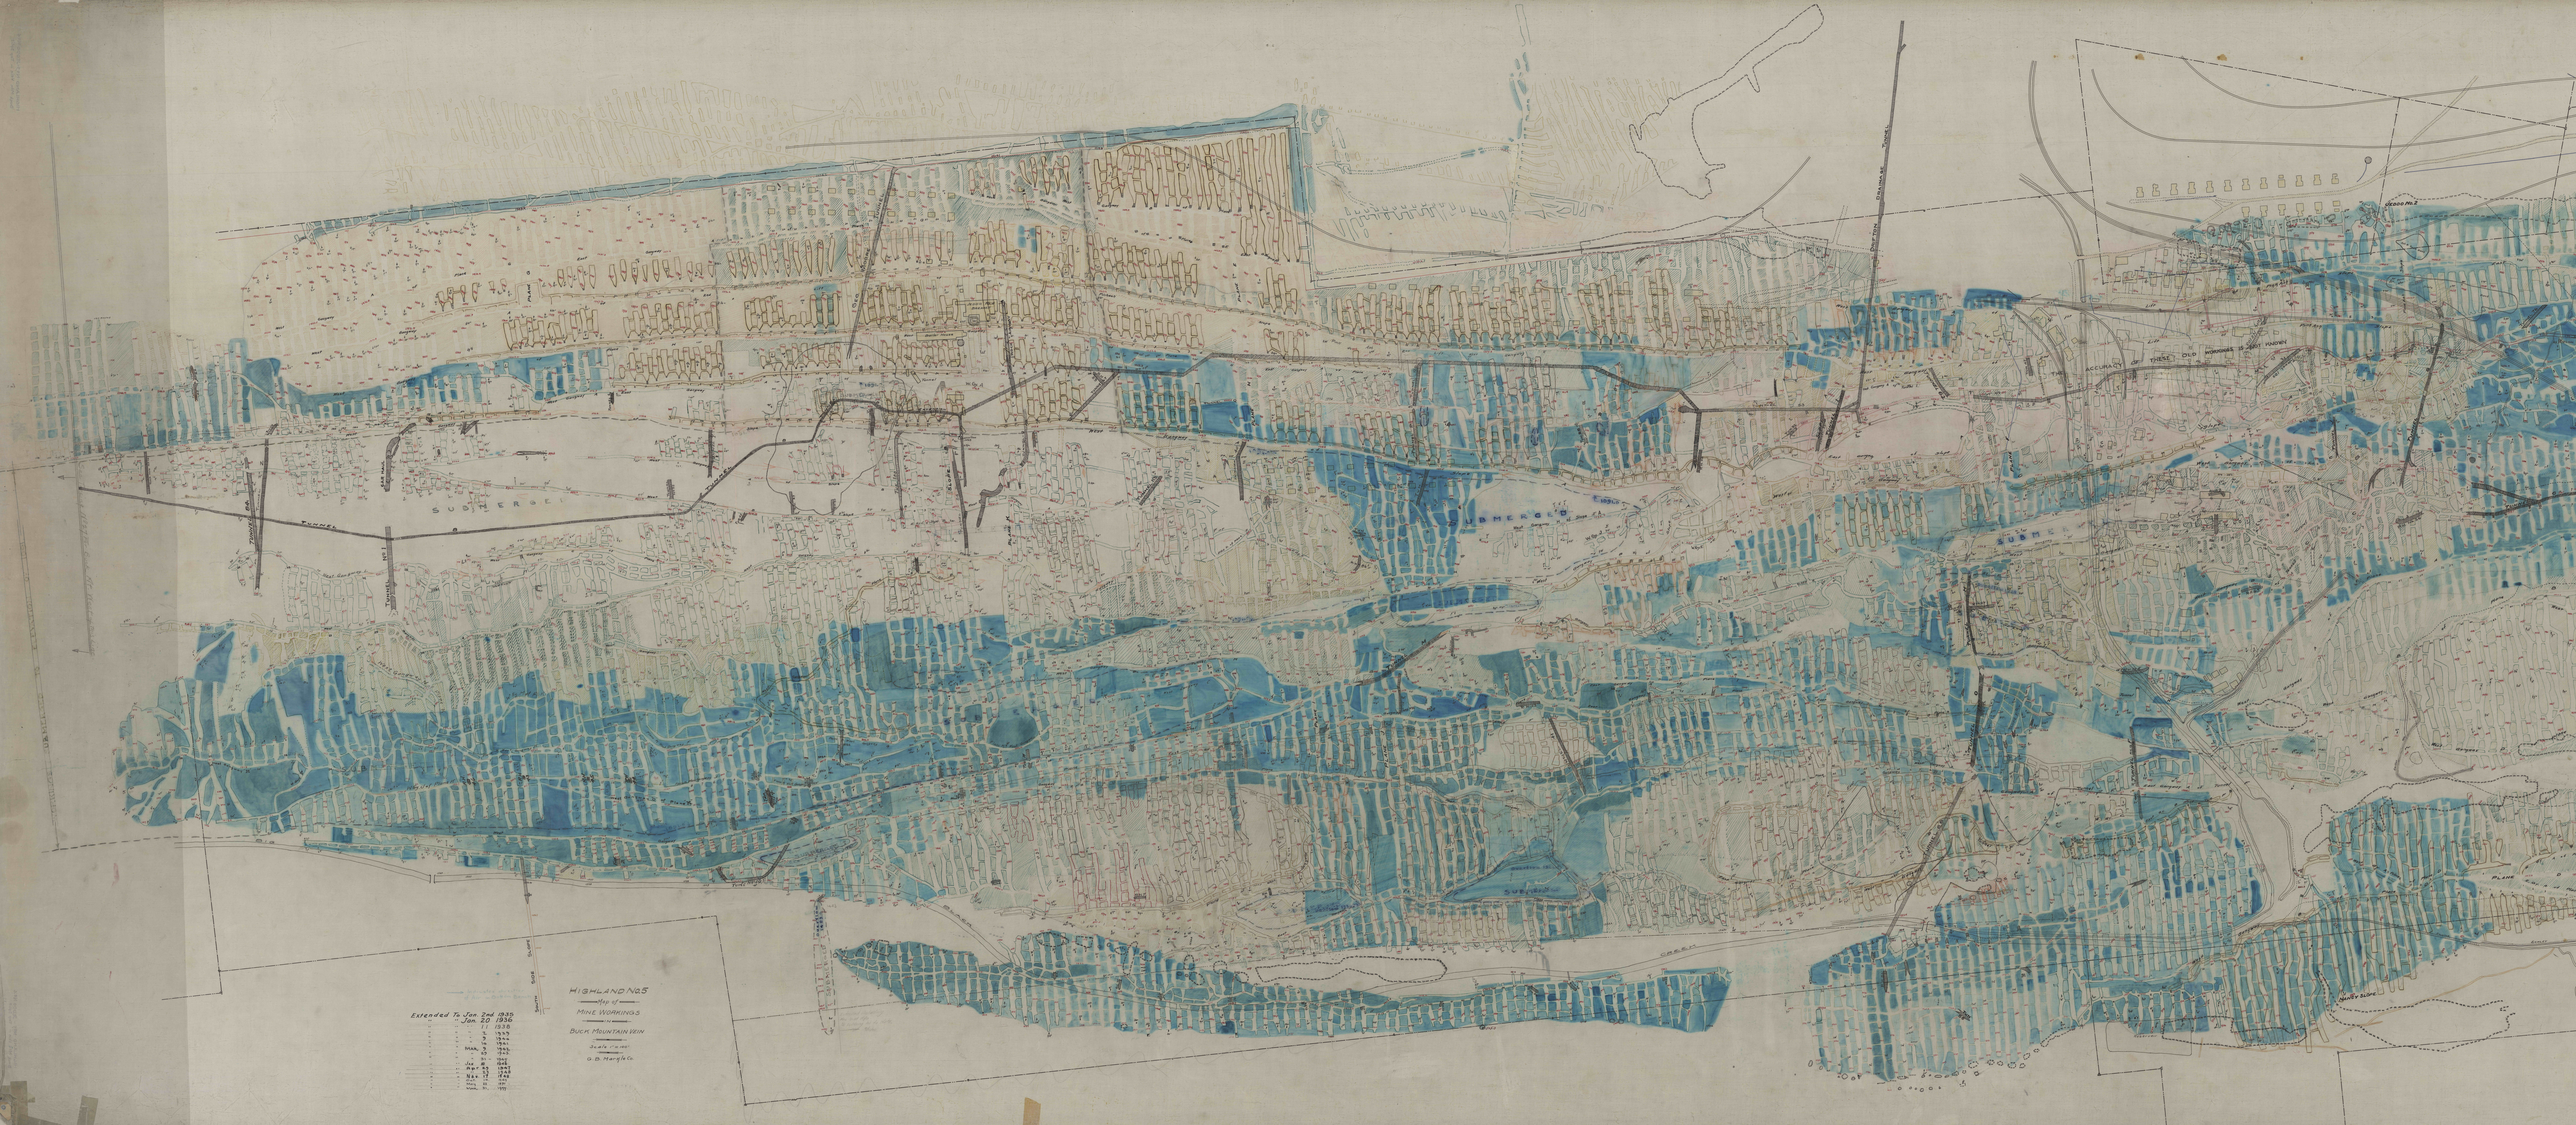
HIGHLAND No. 5
Map of
MINE WORKINGS
IN
BUCK MOUNTAIN VEIN
Scale Paper
G. B. Morgle Co.
Extended To Jan. 2nd 1935
" " Jan. 20 1936
" " " 11 1938
" " " 3 1939
" " " 14 1940
" " MAR. 9 1942
" " " 23 1943
" " Jan. 8 1944
" " Apr. 23 1945
" " Nov. 12 1946
" " Mar. 21 1947
" " Mar. 21 1948
" " Mar. 21 1949
SOUTH SIDE SLOPE
SUBMERGED
TUNNEL
ACCURACY OF THESE OLD WORKINGS IS NOT KNOWN