

2,000 NORTH

5,000 EAST

5,000 EAST

5,000 EAST

8,000 NORTH

8,000 NORTH

8,000 NORTH

CONSUMERS PA WATER CO

Nathan Brown Tract

CONSUMERS PA WATER CO

ENGINEER'S CERTIFICATION

I hereby certify that to the best of my knowledge that the areas that I have surveyed are true and correct as to the requirements of 30 CFR Part 75.1200. All other information shown has been derived from the best available information but can not be field checked. Therefore, engineer makes no certification to their accuracy.

David L. Williams
David L. Williams, P.E.

MINE FOREMAN CERTIFICATION

I depose and say that the mine ventilation information shown on this map meets the requirements of 30 CFR Part 75.372 and was prepared by me or under my direction for which I accept full responsibility.

A. J. Hunt
Mine Foreman

Robert Jordan Tract

Burn Rite Slope #2 Vein
ID #36-08547


Ebenezer Branham Tract

JETT COAL COMPANY

Andrew Porter Tract

Burnrite Coal Company
325 Mulberry St.
Atlas, PA 17851

MINE MAP
for the
Burn Rite Slope
situate
Conyngham Twp., Columbia County

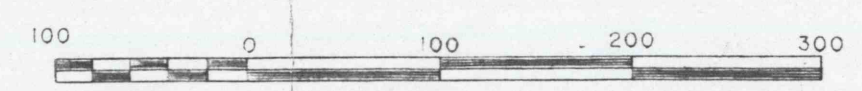

Scale 1 inch = 100 feet

Surveyed: Feb. 26, 1997
March 25, 1998

