
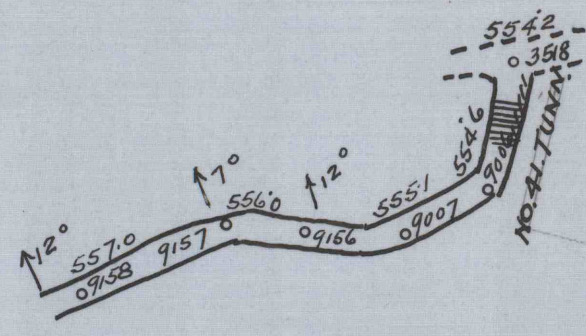


COAL VALLEY LEHIGH
COMPANY

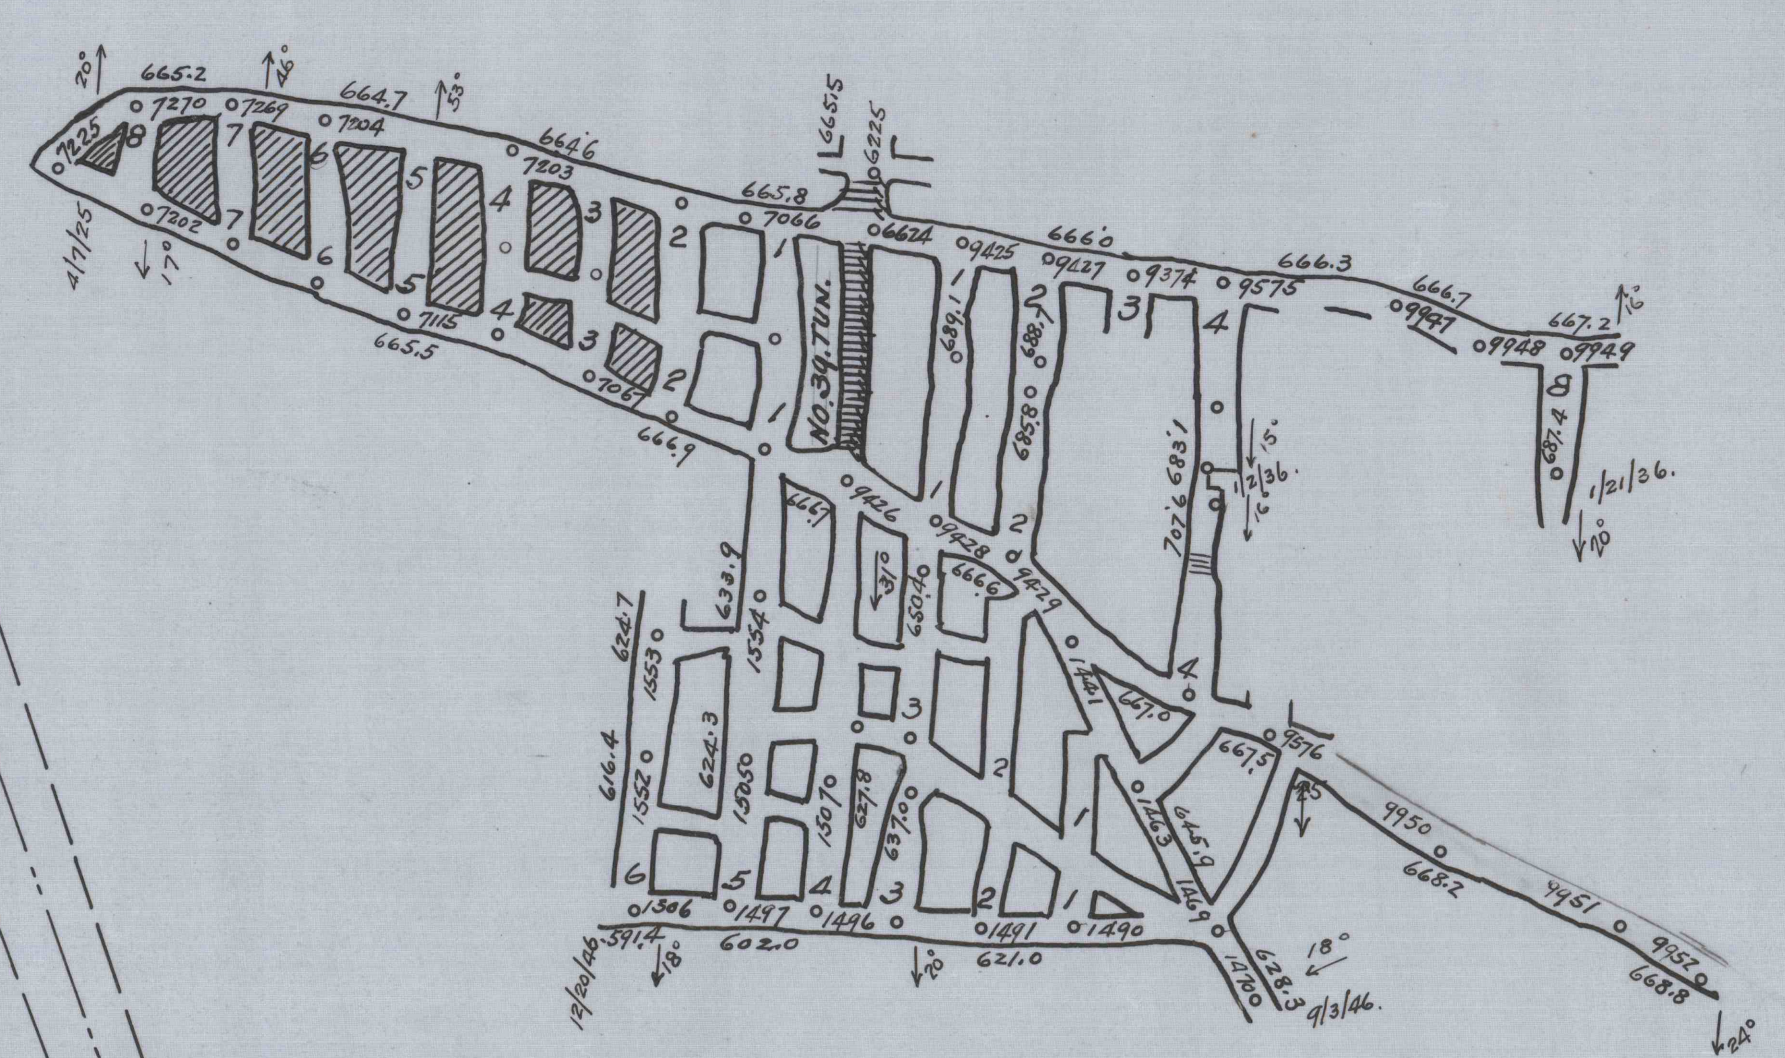

|||