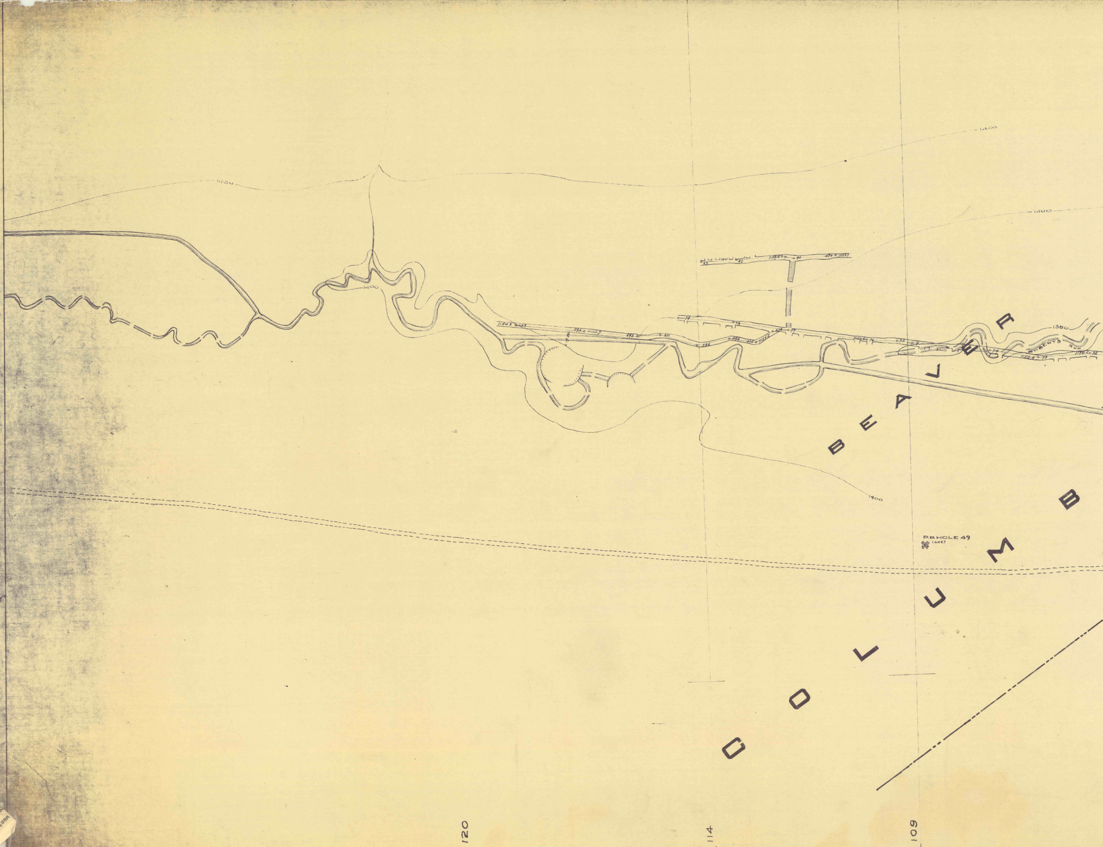
1420
1400
1400
1380
1400
11543
11537
11524
11519
11504
11501
11594
11537
1150.4
1150.4
ROBERTS RUN
BEAVER
COLUMB
P.R. HOLE 49
14067
120
114
109

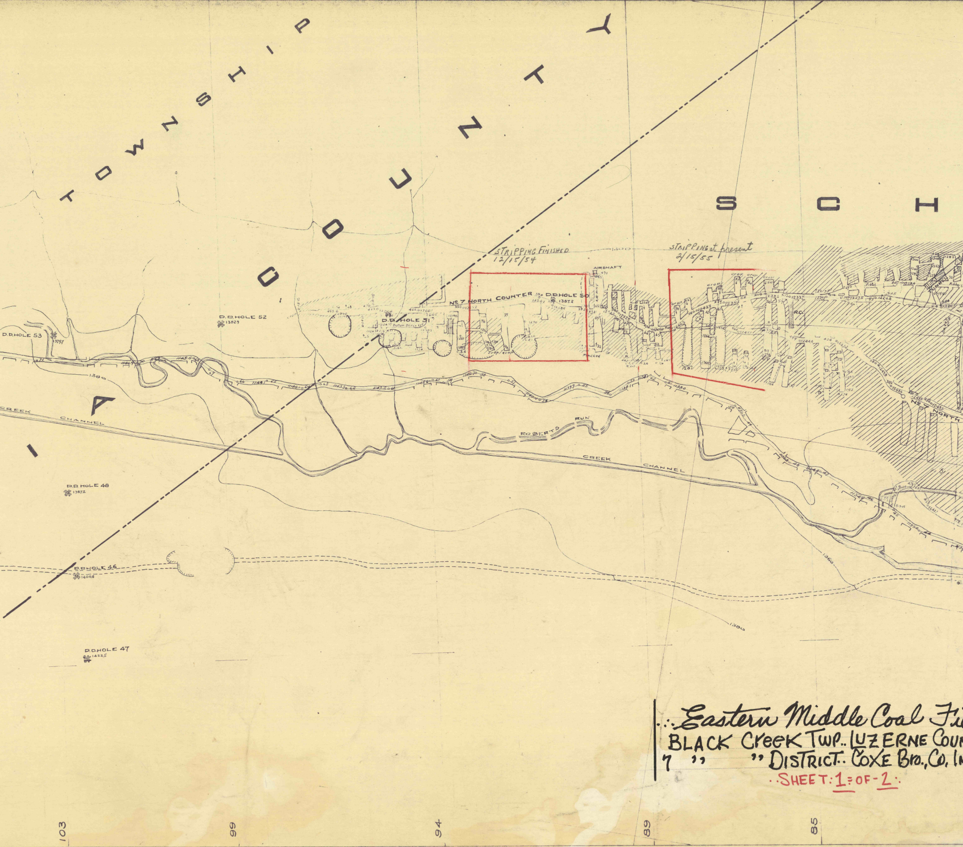
TOWNSHIP
COUNTY
SCH
A
I
STRIPPING FINISHED 12/15/54
STRIPPING at present 2/15/55
1400
AIRSHAFT
AIRWAY
No 7 NORTH COUNTER
D.D. HOLE 50
1387.2
D.D. HOLE 51
D.D. HOLE 52
13829
D.D. HOLE 53
13797
Pinched
crop
R.C.
No NORTH
1380
ROBERTS RUN
CREEK CHANNEL
CREEK CHANNEL
1360
1300
D.D. HOLE 48
13872
D.D. HOLE 46
14006
D.D. HOLE 47
1422.5
103
99
94
89
85

.:. Eastern Middle Coal Fi
BLACK Creek TWP.. LUZERNE COUN
7 " " DISTRICT.. COXE Bro., Co. In
.. SHEET: 1 = OF - 2 .:

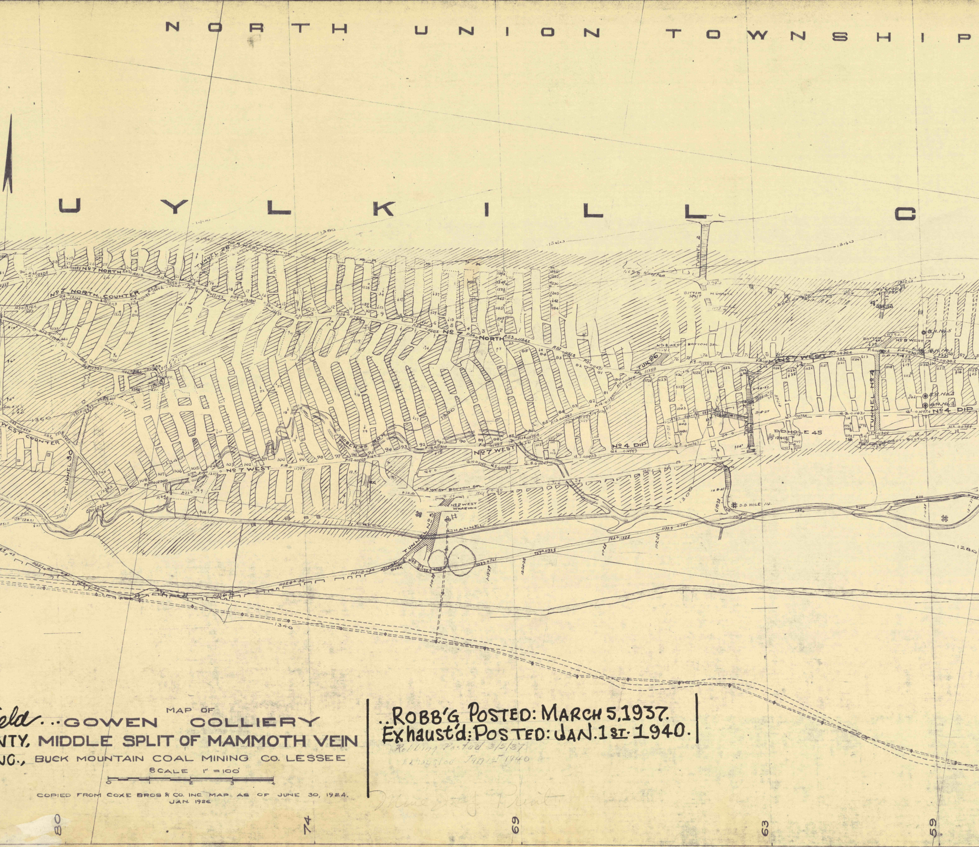
N O R T H   U N I O N   T O W N S H I P
U Y L K I L L   C
No 7 NORTH
No 7 NORTH COUNTER
TUNNEL 28
No 8 WEST WHARTON
TUNNEL 2
BOTTOM SPLIT
MAMMOTH
No 8 WEST BOTTOM SPL.
TUN 26
No 7 WEST
No 8 WEST
D.D.H. No 5
D.D.H. No 3
No 4 DIP
TUNNEL No 4
D.D. HOLE 45
ROBERTS
WEST COUNTER
TUNNEL 30
No 8 WEST BOTTOM SPL.
No 8 WEST WHARTON
CHANNEL
TUNNEL
BUCK
D.D. HOLE 112
1380
1360
1340
1320
1300
1280
1350
80
74
69
63
59

MAP OF

...eld ..GOWEN COLLIERY

...NTY, MIDDLE SPLIT OF MAMMOTH VEIN

...NC., BUCK MOUNTAIN COAL MINING CO. LESSEE

SCALE 1" = 100'

0 1 2 3 4

COPIED FROM COXE BROS & CO. INC. MAP AS OF JUNE 30, 1924.
JAN. 1926.

..ROBB'G POSTED: MARCH 5, 1937.
Exhaust'd: POSTED: JAN. 1st 1940.

Robbing Posted 3/5/37
Exhausted Jan 1st 1940

Mine Eng Print

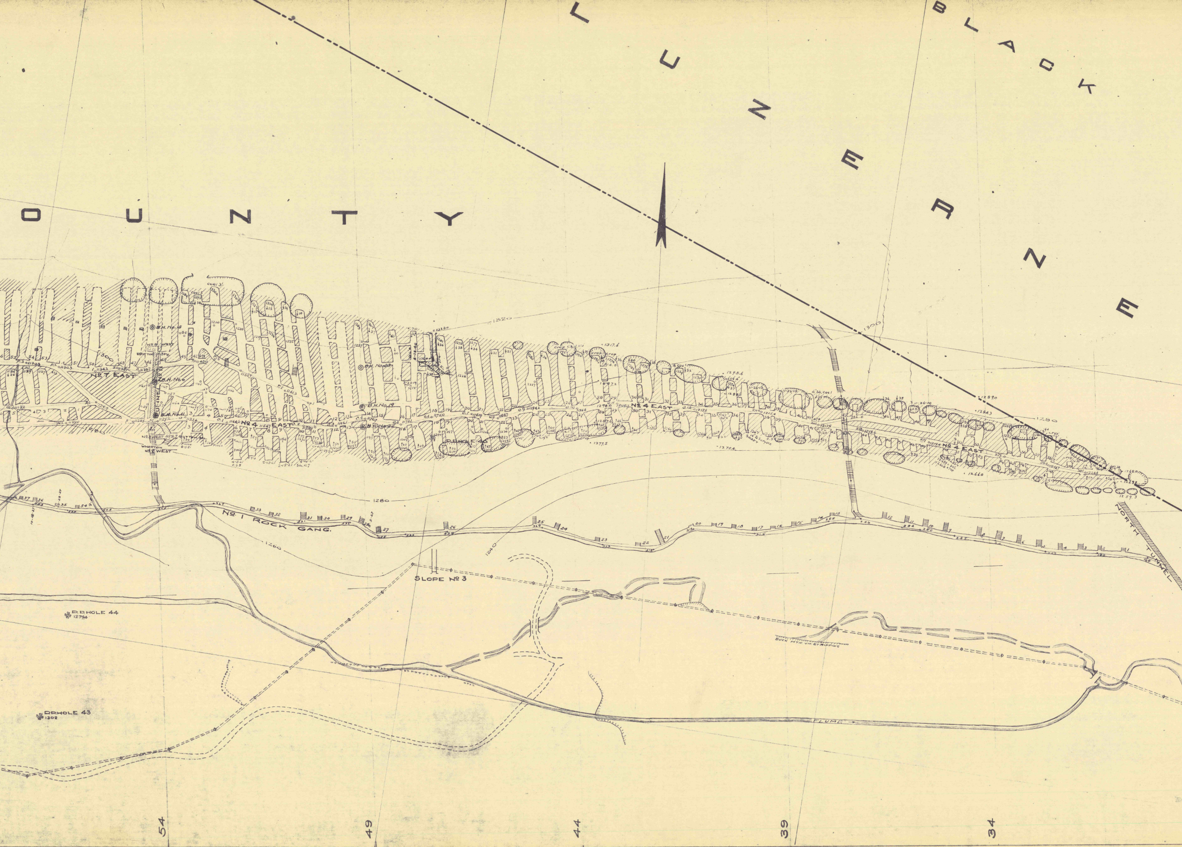
BLACK
LUZERNE
OUNTY
1320
1300
1280
1260
1240
1290
No 7 EAST
No 8 WEST
No 4 EAST
B.H. No 19
D.D. HOLE 46
1317.6
1295.6
1277.5
No 1 ROCK GANG
NORTH TUNNEL
SLOPE No 3
D.D. HOLE 44
1279.4
D.D. HOLE 43
1302
BUCK MTN VN STRIPPING
FLUME
54
49
44
39
34

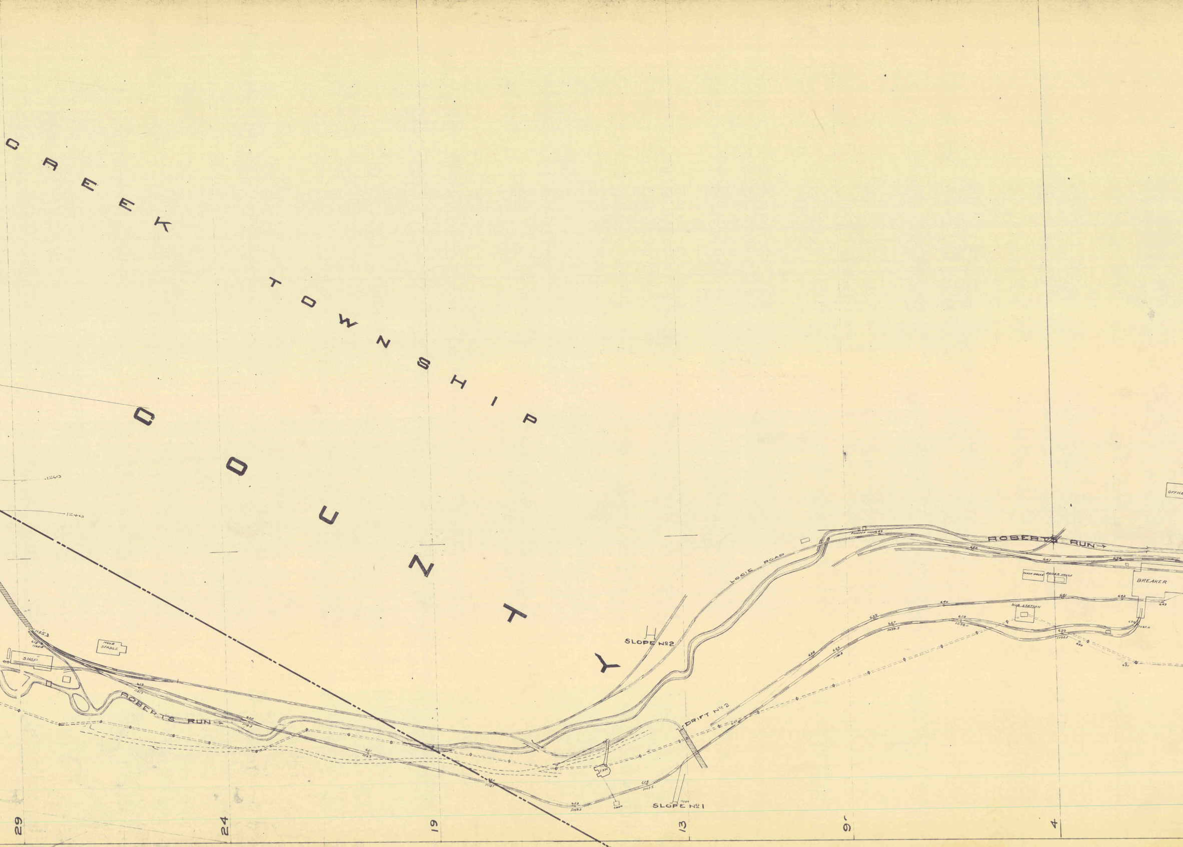
CREEK TOWNSHIP
COUNTY
1240
1240
LOGIC ROAD
POWDER HOUSE
649
ROBERTS RUN→
648
647
646
OFFICE
WASH HOUSE
BOILER HOUSE
BREAKER
640
641
642
643
SUB STATION
639
627
1039.5
628
1098.0
629
1102.1
630
1097.0
638
626
1101.3
631
SLOPE No 2
DRIFT No 2
625
FAN
TANK
SLOPE No 1
1104
624
1107.5
623
1109.2
622
1118.1
621
1116.3
620
1118.3
619
1121.7
ROBERTS RUN→
1125.3
618
1125.4
MULE STABLE
SHOP
29
24
19
13
9
4

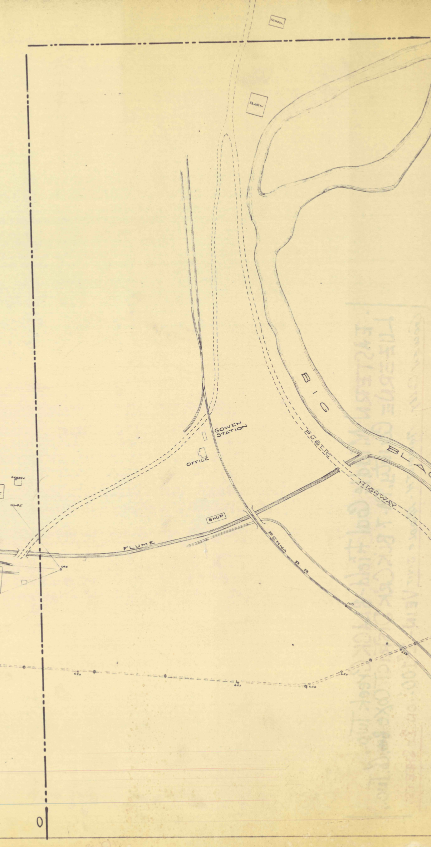
SCHOOL
BARN
GOWEN STATION
OFFICE
GARAGE
0.645
SHOP
FLUME
PENNA R.R.
100
BIG BLAC
PUBLIC HIGHWAY
0