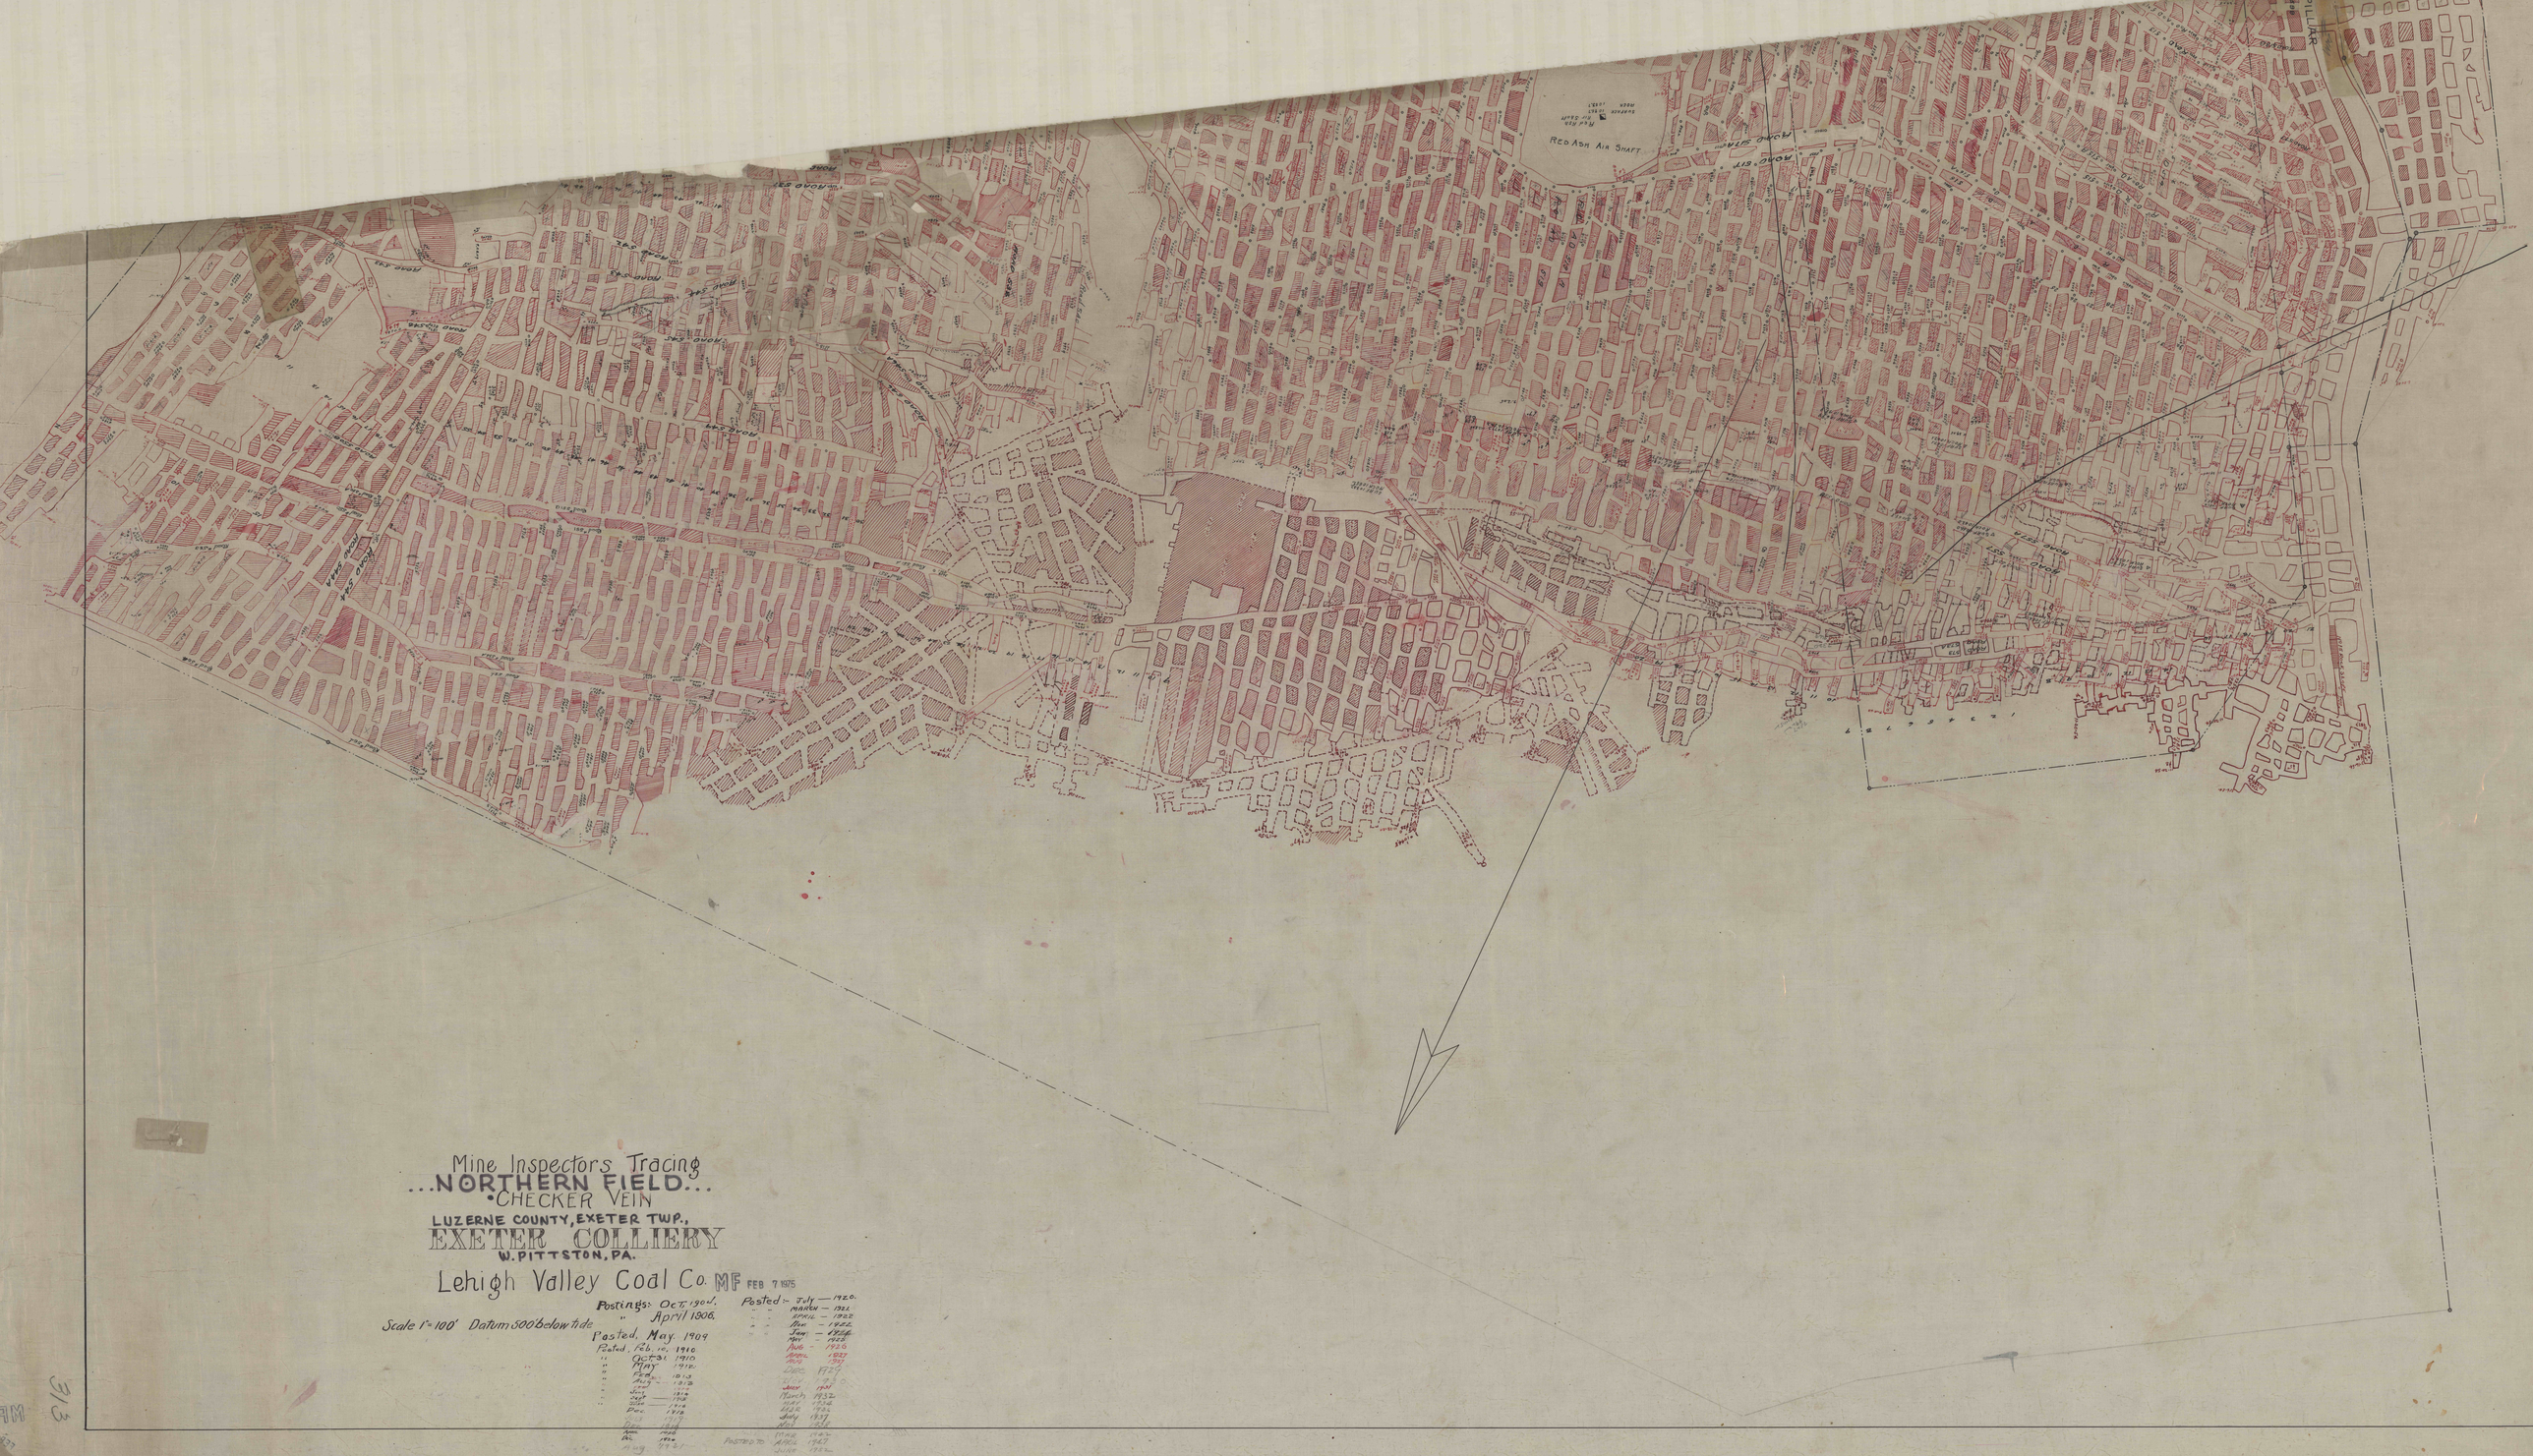

Mine Inspectors Tracing

...NORTHERN FIELD...

•CHECKER VEIN

LUZERNE COUNTY, EXETER TWP.,

EXETER COLLIERY

W. PITTSTON, PA.

Lehigh Valley Coal Co. MF FEB 7 1975

Scale 1"=100' Datum 500 below tide

Postings: Oct 1901.
" April 1906.
Posted, May 1909
Posted, Feb. 10, 1910
" Oct 31 1910
" May 1912.
" Feb 1913
" Aug 1913
" Jan 1914
" Sept 1918
" Mar 1919
" Dec 1919
Posted 1920
" 1921
" 1924
" 1925
" 1926
" 1927
" 1928
" 1929
" 1930
" 1931
" 1932
" 1933
" 1934
" 1935
" 1936
" 1937
" 1938
" 1939
" 1940
" 1941
" 1942
" 1943
"