


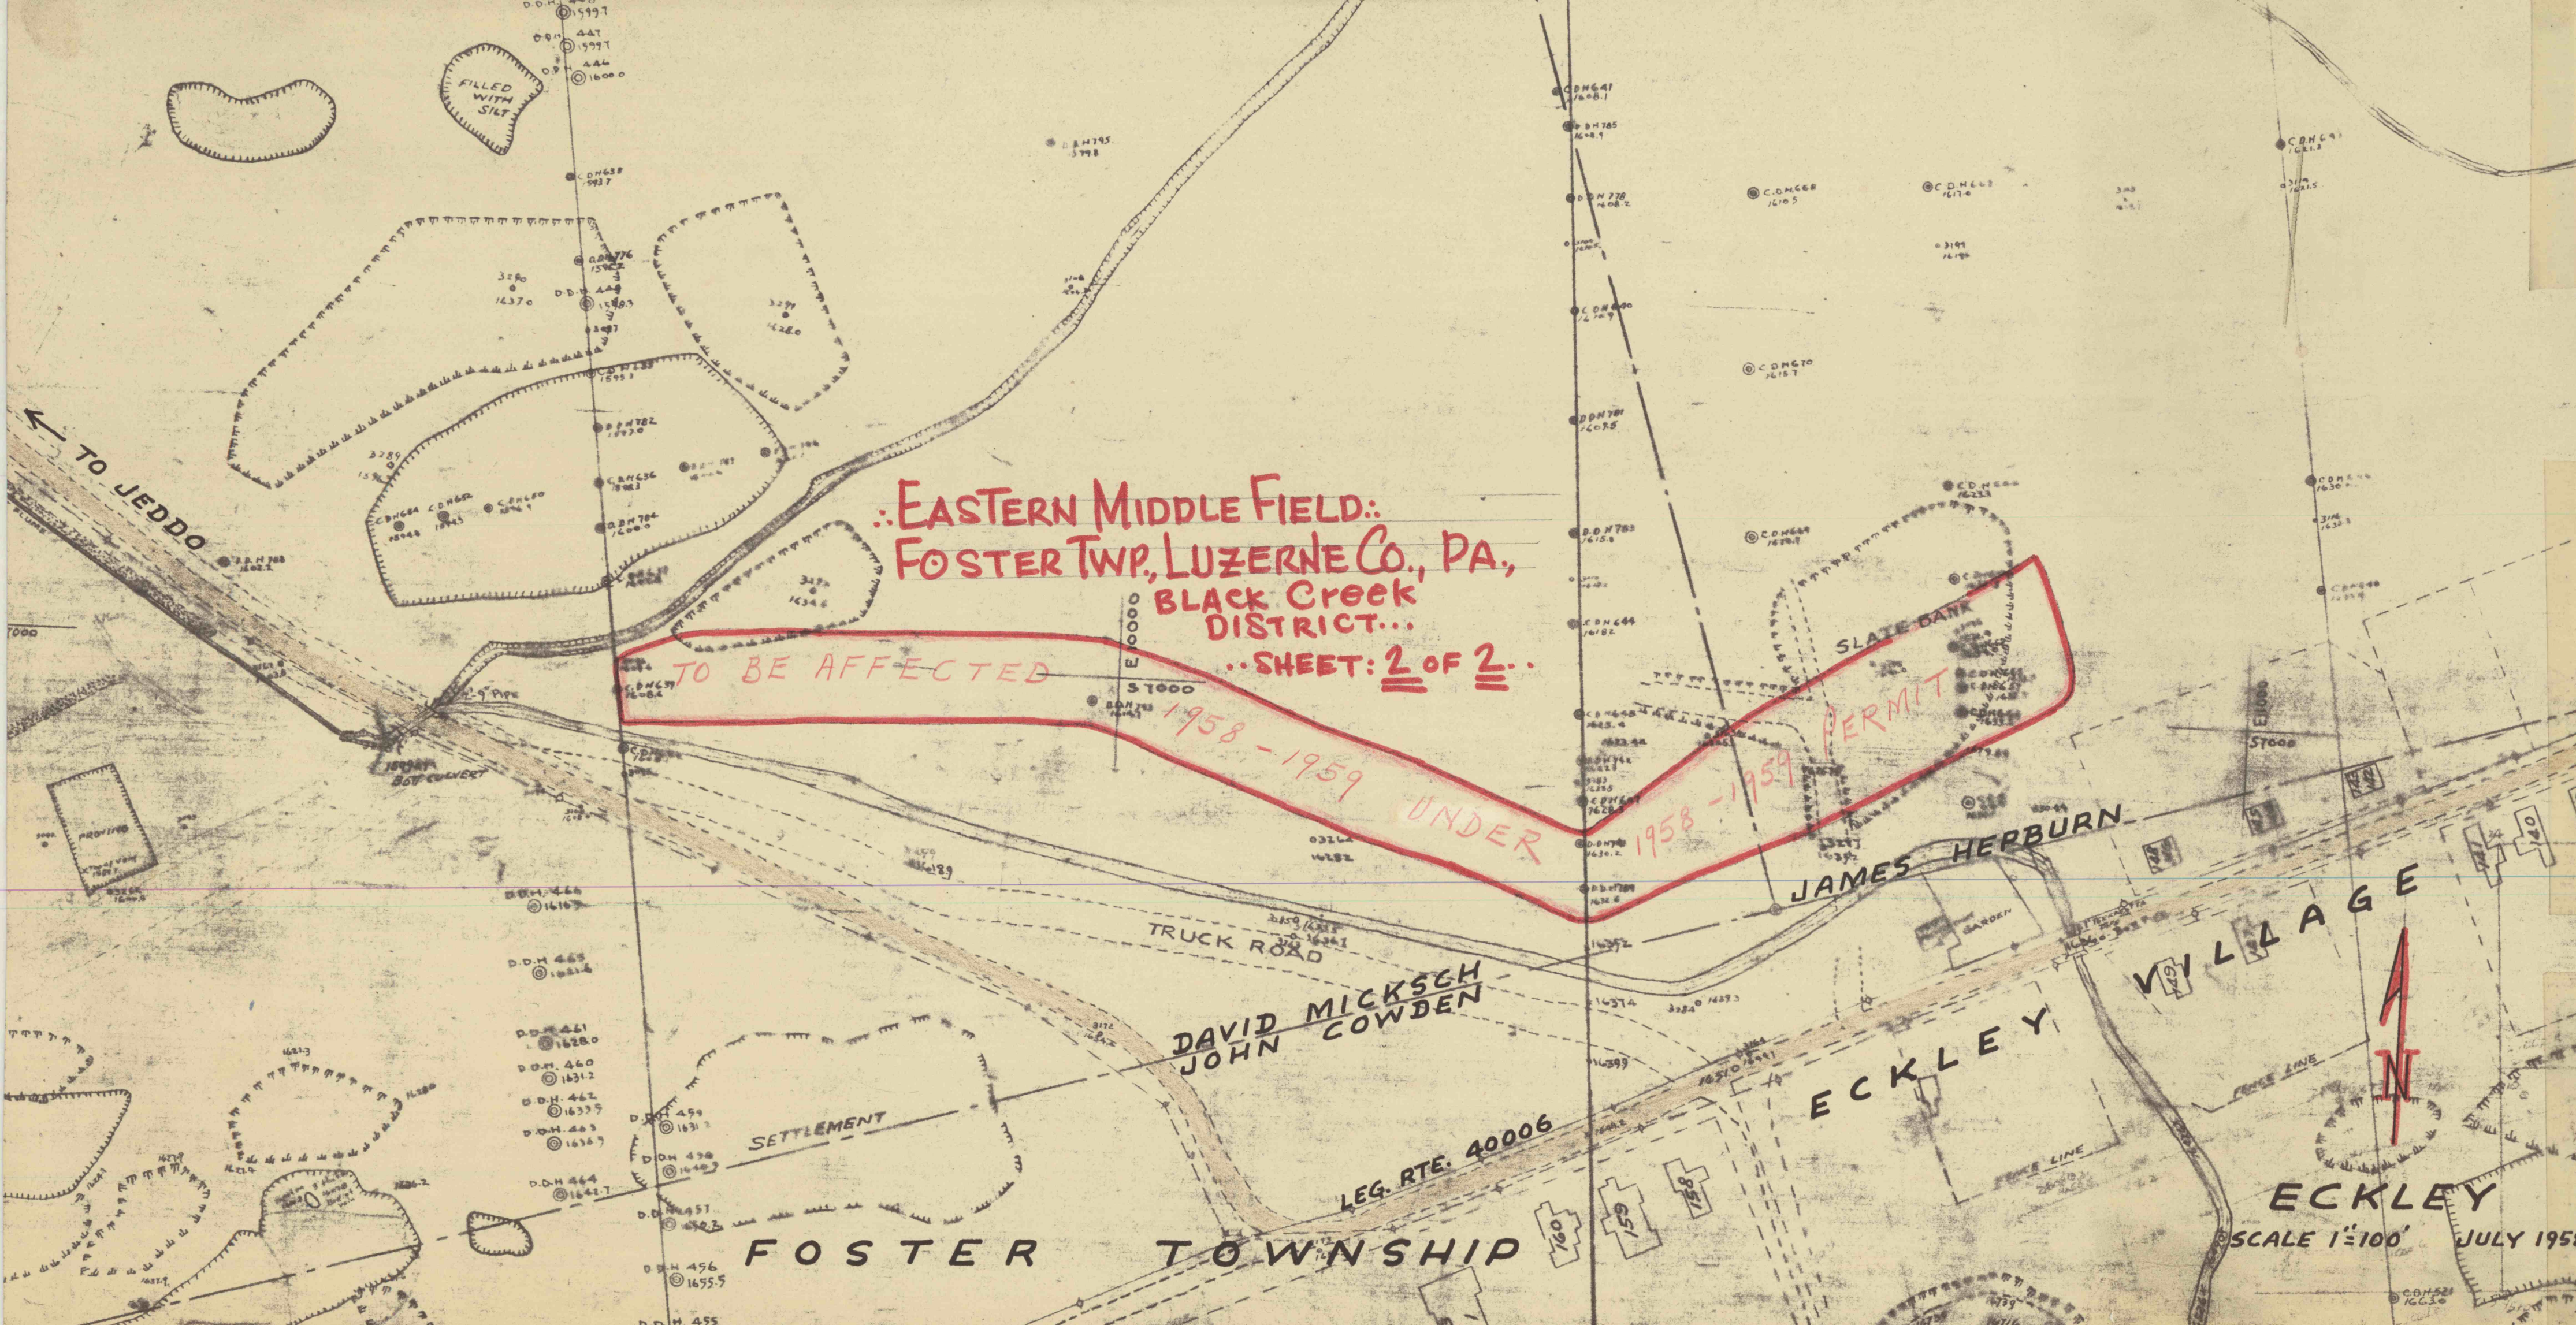

..EASTERN MIDDLE FIELD:
FOSTER TWP., LUZERNE CO., PA.,
BLACK CREEK
DISTRICT...
..SHEET: 2 OF 2..

TO BE AFFECTED

1958-1959 UNDER PERMIT

1958-1959

DAVID MICKSCH
JOHN COWDEN

LEG. RTE. 40006

FOSTER TOWNSHIP

ECKLEY

SCALE 1"=100' JULY 1958