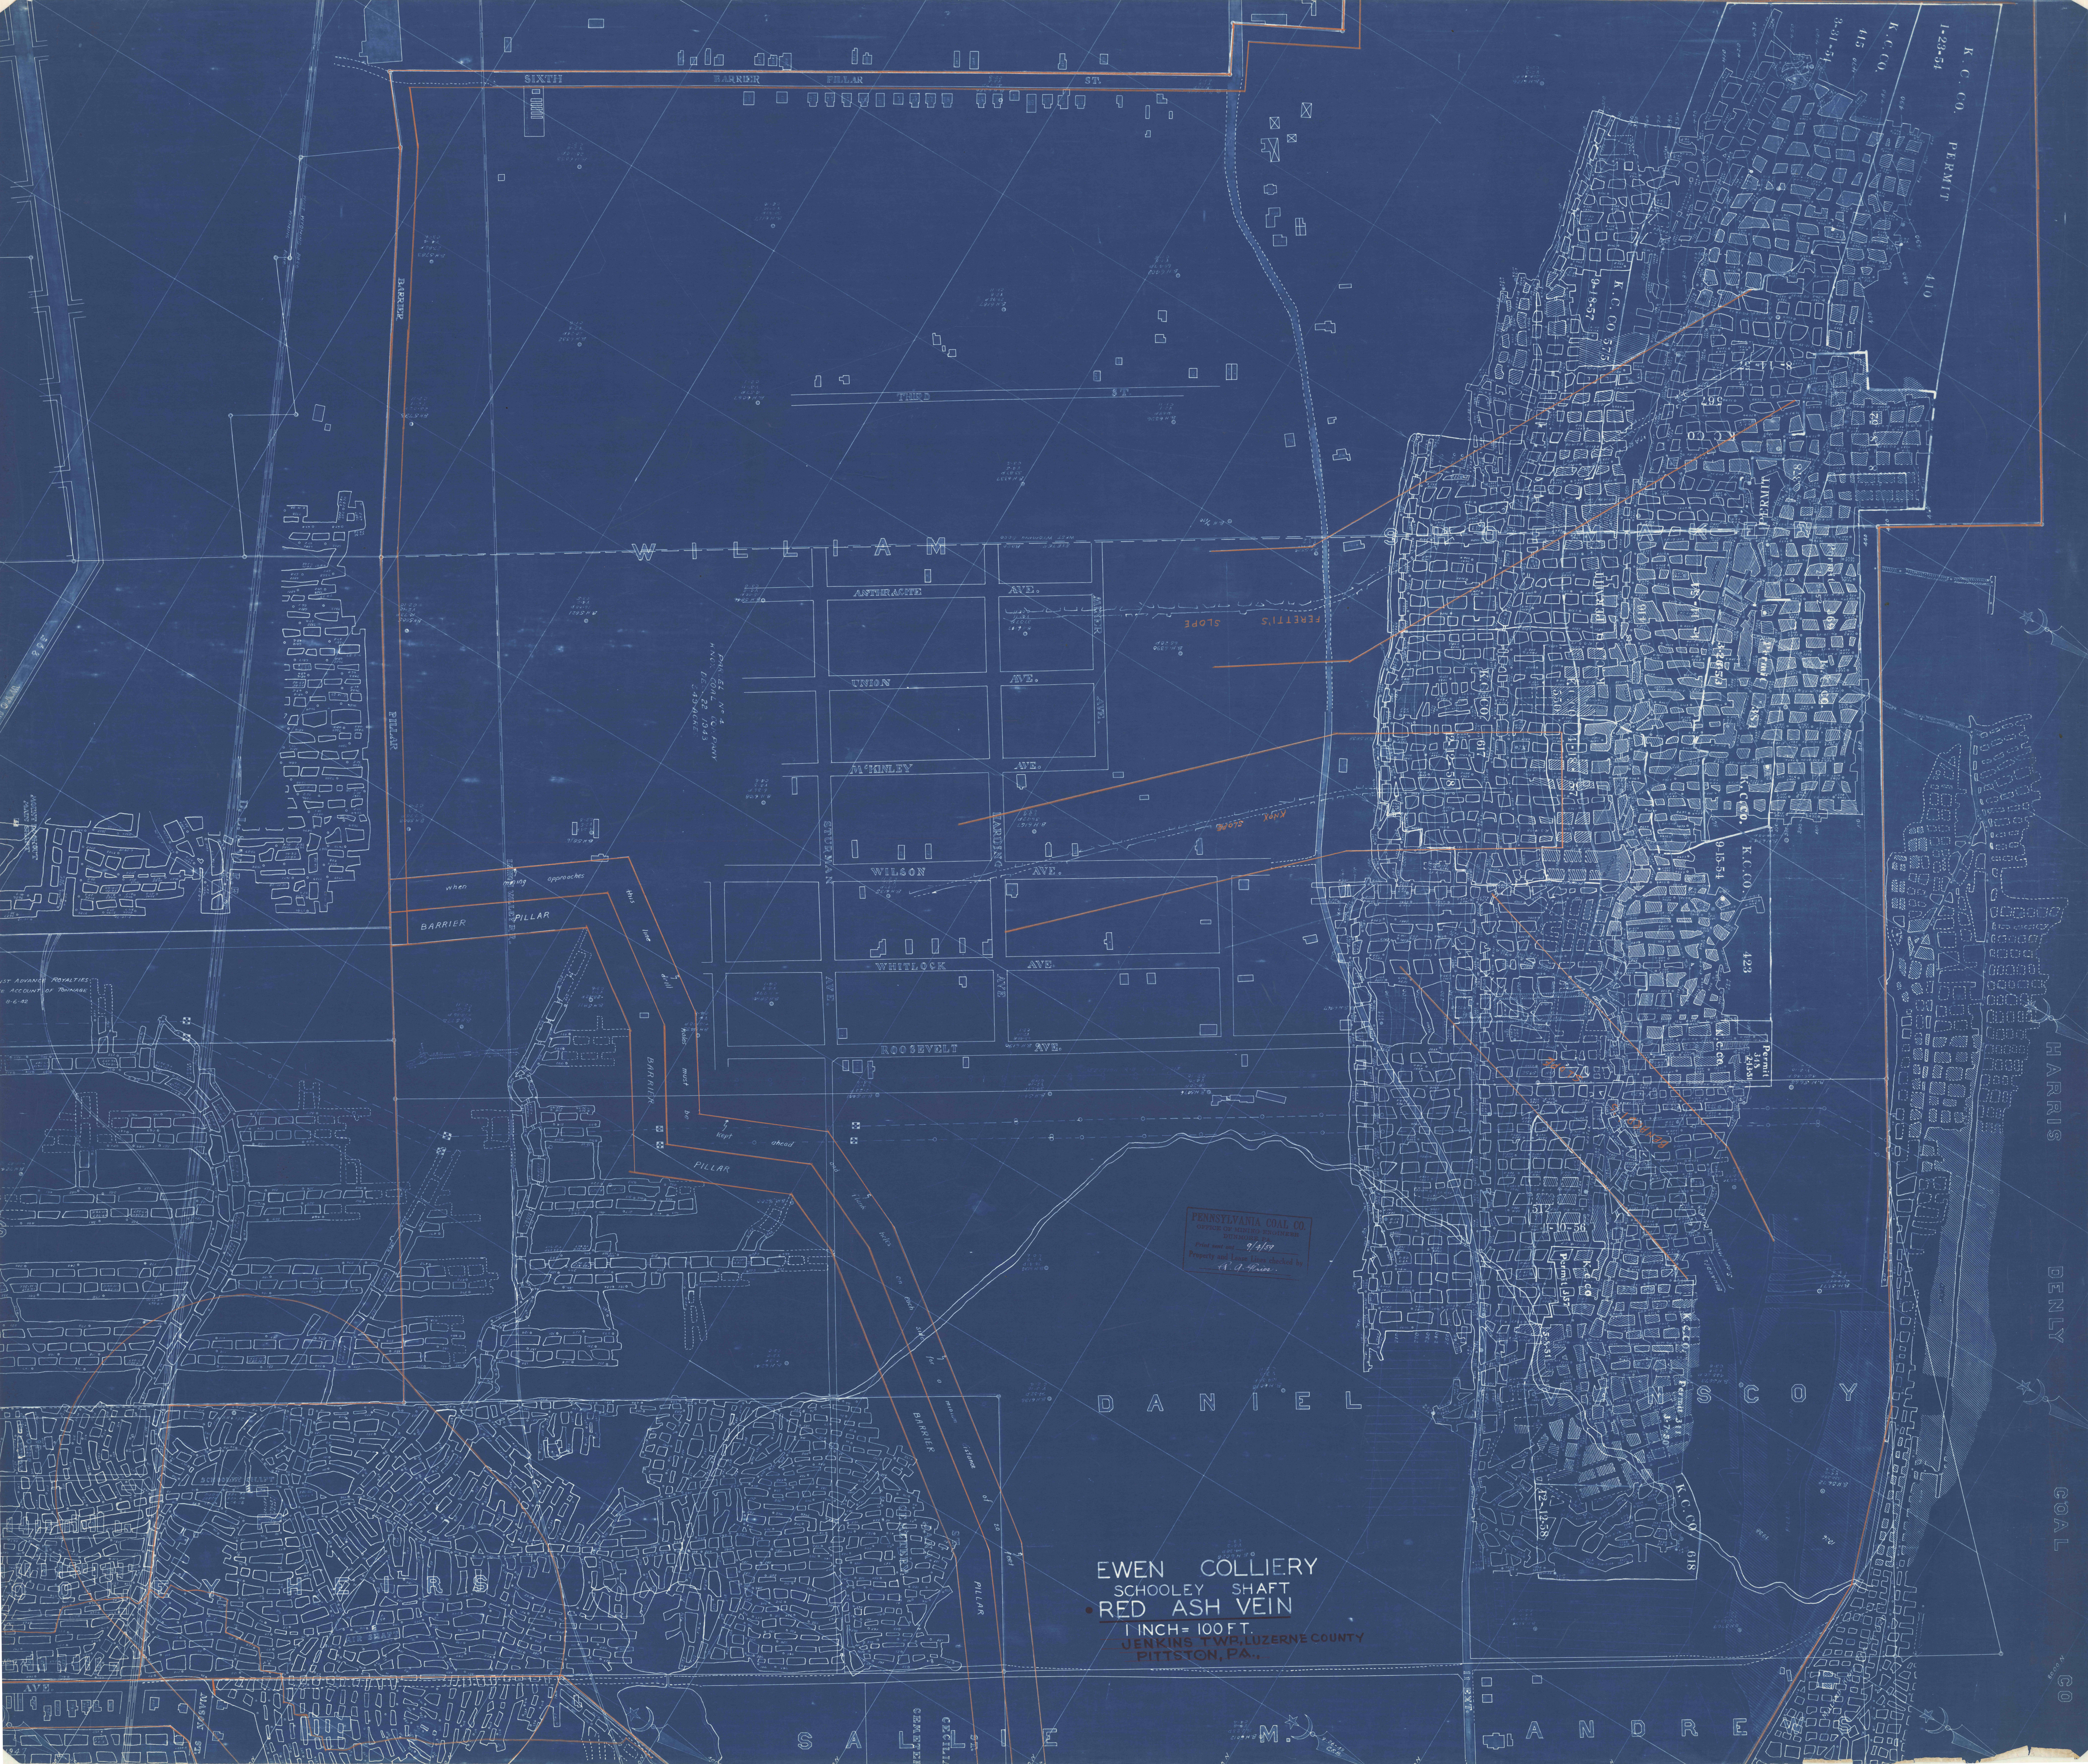
SIXTH BARRIER PILLAR ST.
THIRD ST.
WILLIAM
ANTHRACITE AVE.
UNION AVE.
McKINLEY AVE.
WILSON AVE.
WHITLOCK AVE.
ROOSEVELT AVE.
MINER AVE.
HARDING AVE.
STURMAN AVE.
FERETTI'S SLOPE
KNOX SLOPE
BENEDICT'S SLOPE
PARCEL No 4
KNOX COAL COMPANY
DEC. 22 1943
249 ACRES
BARRIER PILLAR
when mining approaches this line drill holes must be kept ahead
20 feet minimum distance of barrier for 0 side on each
PILLAR
LEHIGH VALLEY R.R.
D.L.&W. R.R.
MOUNT AIRY MAIN SHAFT
SCHOOLEY SHAFT
MAIN SHAFT
MASON ST.
AVE
CECILIA ST.
CEMETERY
ST. MARY'S CEMETERY
DANIEL
SALLIE
M.
ANDRE
SCOY
HARRIS DENLY COAL CO
EXETER BORO
WEST WYOMING BORO
WYOMING BORO
368 WYOMING
K.C.CO. PERMIT 410 1-23-54
K.C.CO. 415 3-31-54
K.C.CO 575 9-18-57
K.C.CO 567 8-14-57
K.C.CO. 9-15-54
K.C.CO 423
Permit 348 2-13-51
K.C.CO 617 12-12-58
K.C.CO 618 12-12-58
Permit 311 3-7-50
Permit 357 5-8-51
K.C.CO
517 1-10-56
PERMIT
Permit 383
3-26-53
MUST ADVANCE ROYALTIES ACCOUNT OF TONNAGE
8-6-42

EWEN COLLIERY

SCHOOLEY SHAFT

RED ASH VEIN

1 INCH = 100 FT.

JENKINS TWP., LUZERNE COUNTY
PITTSTON, PA.

PENNSYLVANIA COAL CO.
OFFICE OF MINING ENGINEER
DUNMORE, PA.
Print sent out 9/4/59
Property and Lease Lines checked by
A. A.