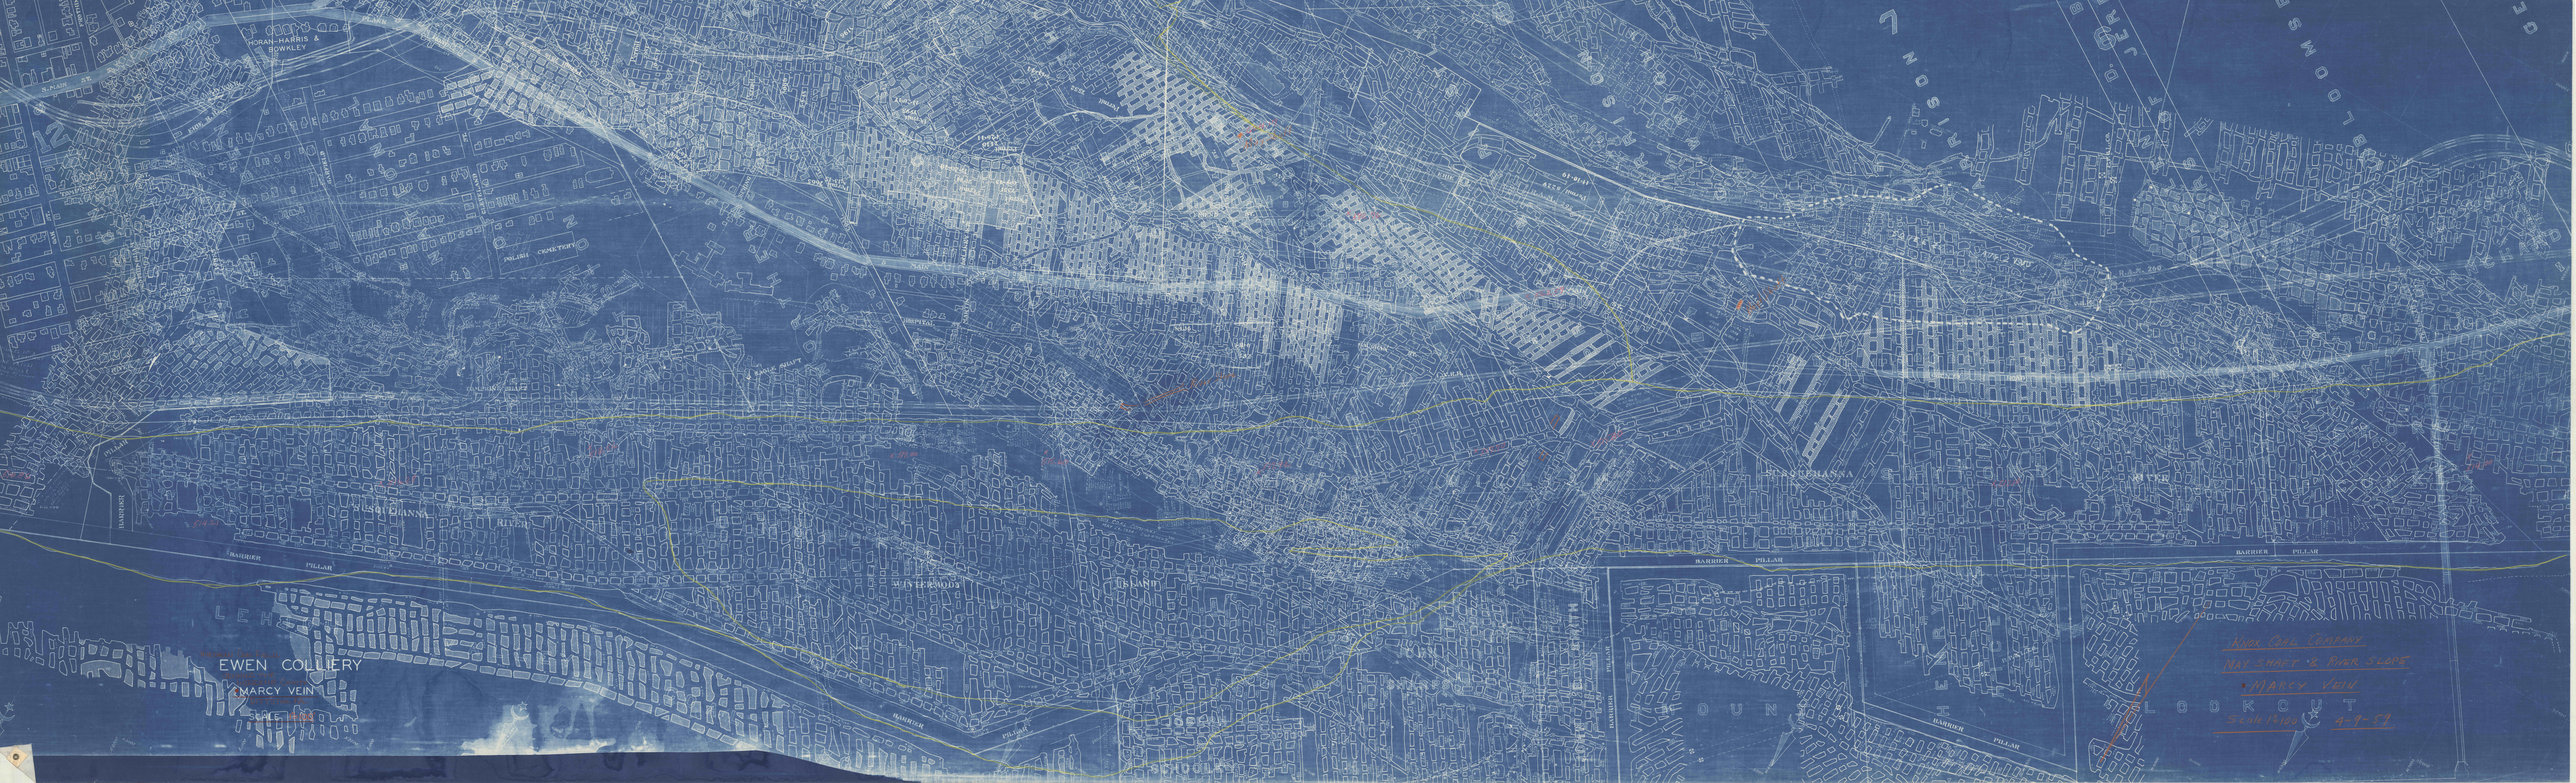

EWEN COLLIERY
MARCY VEIN
SCALE
SUSQUEHANNA RIVER
BARRIER
PILLAR
MAP & PROFILE OF MARCY VEIN
9-9-57