


KOHINOOR 34 N° 3

KOHINOOR 34 N° 4

KOHINOOR 34 N° 5

...WESTERN MIDDLE FIELD...
KOHINOOR Coll'y: MAMMOTH Vein; 1"=100'.
WEST MAHANOY TWP 11 DISTRICT, SCHUYLKILL CO. PA.
P. R. COAL & IRON CO.,
..SHEET; 3-OF-3..

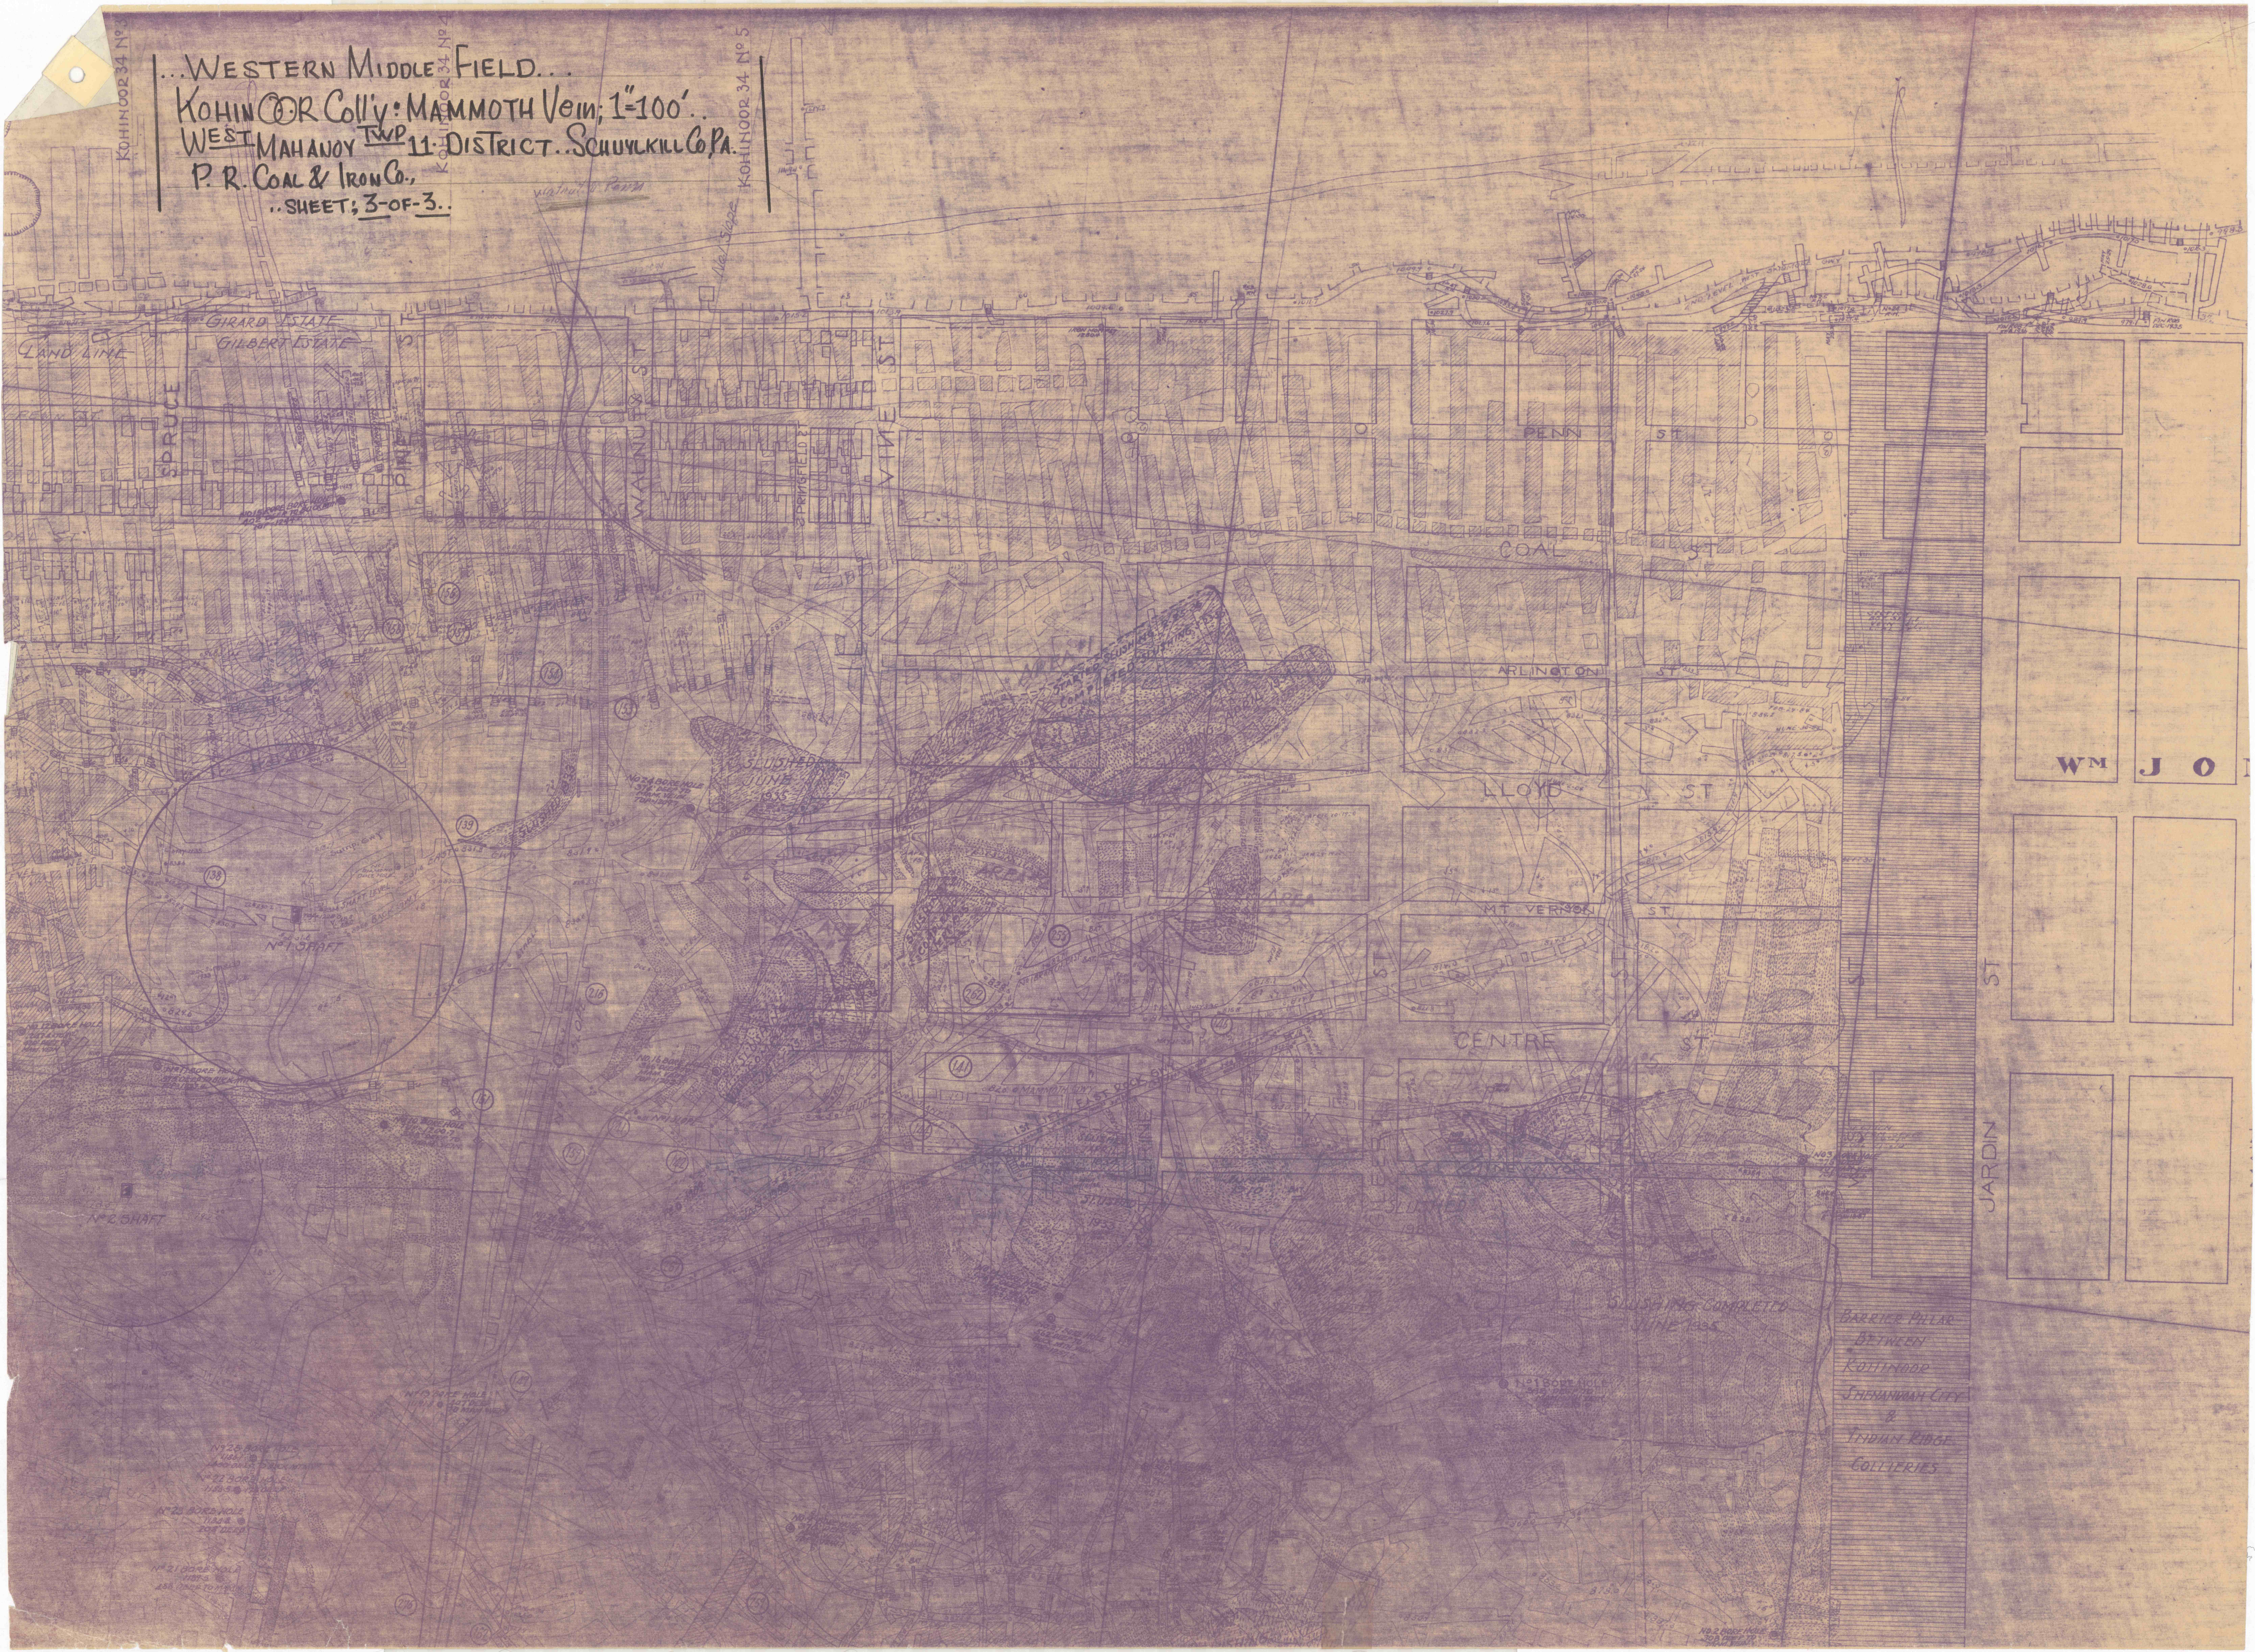

WM JO

JARDIN ST

BARRIER PILLAR
BETWEEN
KOHINOOR
SHENANDOAH CITY
&
INDIAN RIDGE
COLLIERIES