


Packer Colliery No. 3

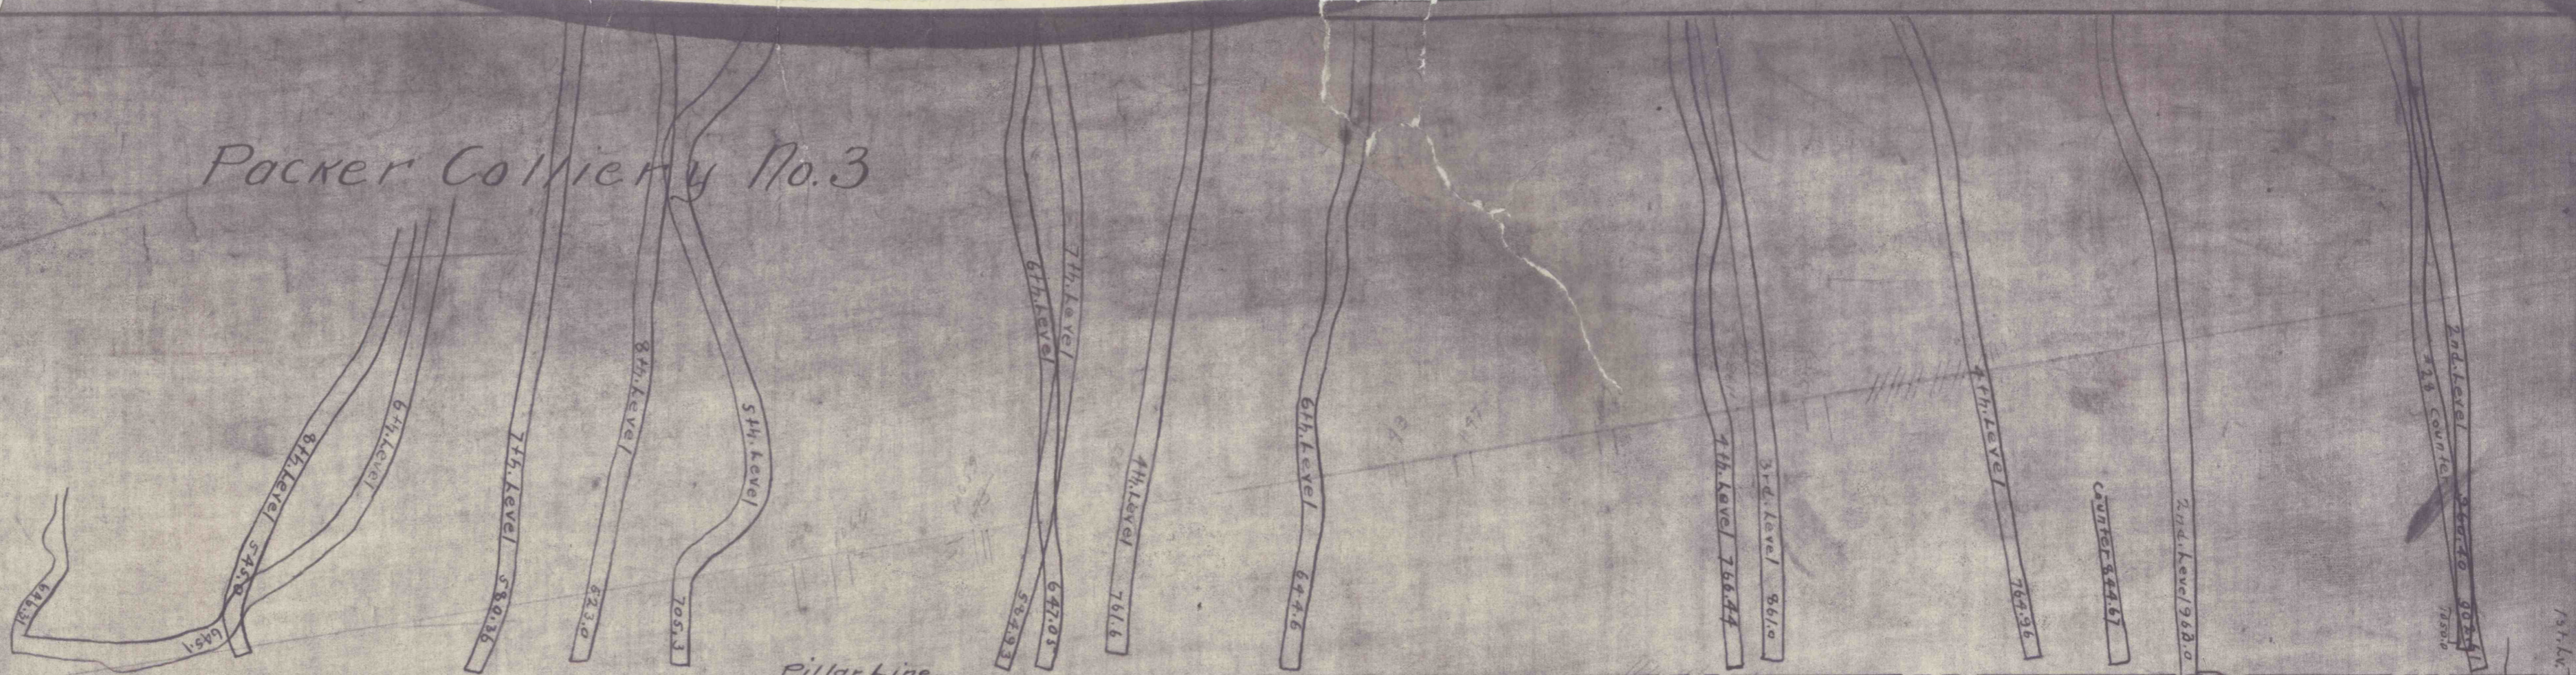

Division line

Pillar line

Kohinoor Colliery



Note: - No. 5 Slope and No. 7 Slope are directly over No. 1 Slope But are Here Shown to the side for convenience

Map Showing Gangways of  
Packer Colliery No. 3, V.C. Co. and  
Kohinoor Colliery, T.F.R.C. & L. Co. in  
Relation to Division Pillar  
Scale 100ft = 1in. March 1902. East Dept. L.C. Co.  
East Colliery, B.  
373

MF  
MAR 18 1915

MF  
MAR 18 1915