




CO. BY 14 E SCHUYL DISTRICT DODSON COAL
WORKINGS 1100 BLYTHE TWP SCHUYLKILL
SOUTHERN FIELD KASKA-WILLIAM COLLY.

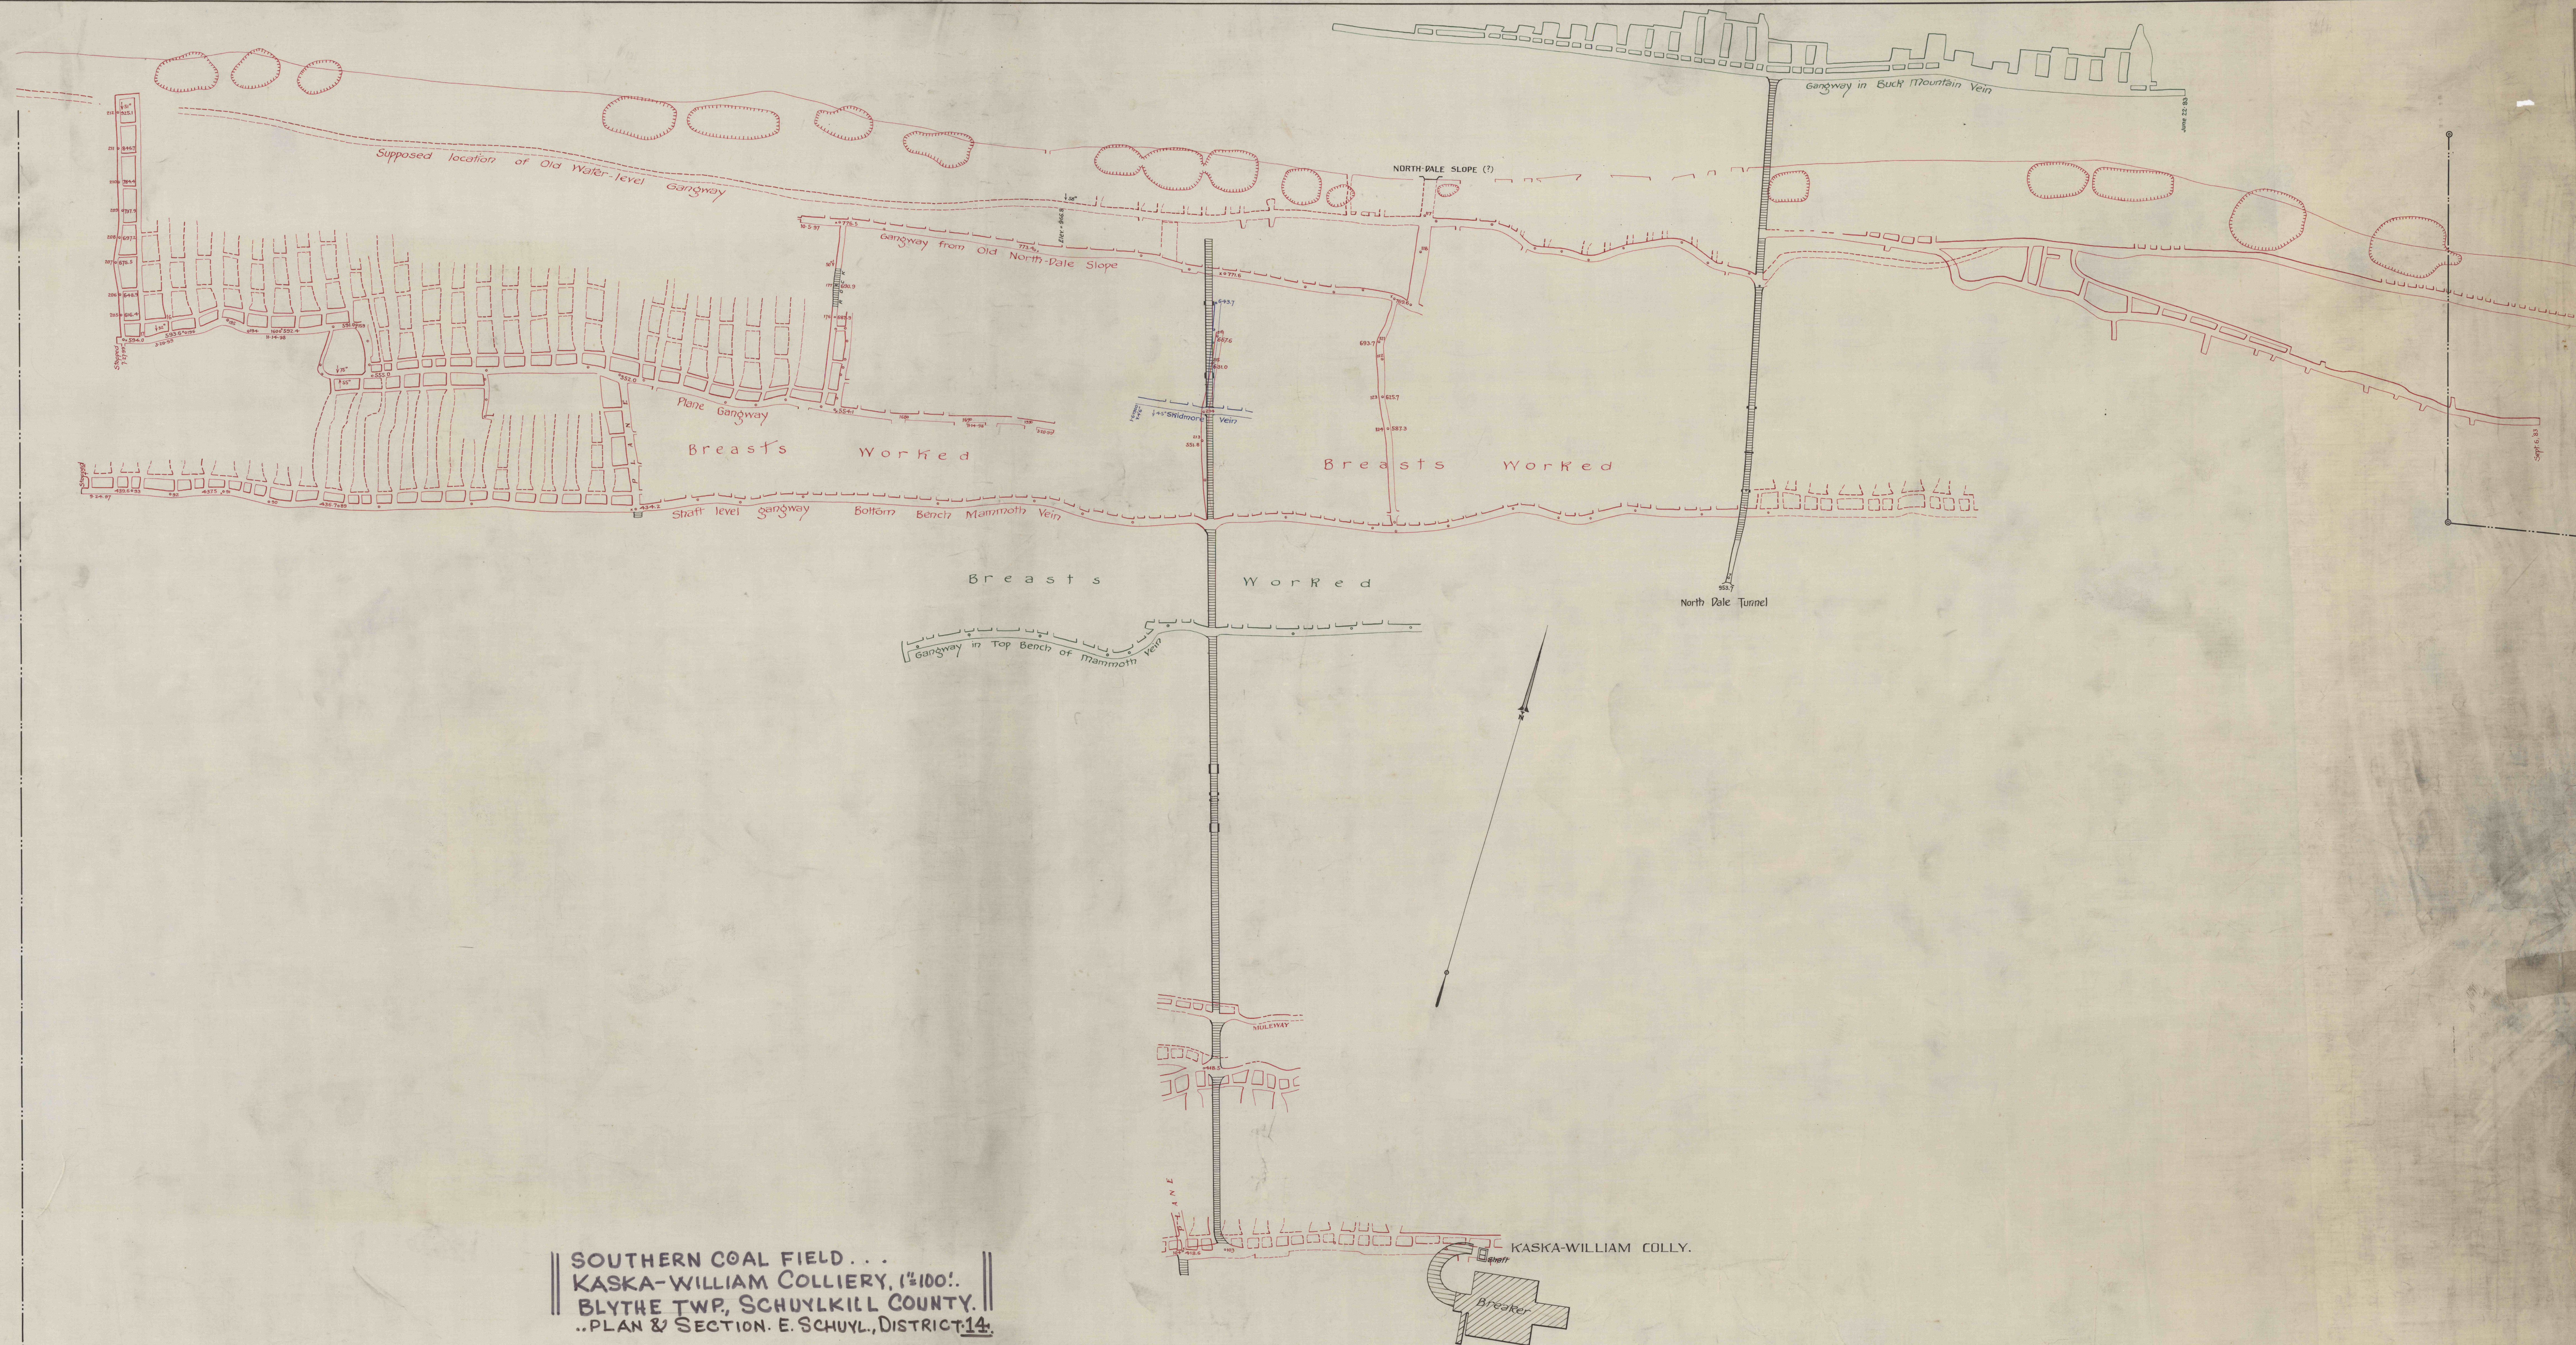

SOUTHERN COAL FIELD...
KASKA-WILLIAM COLLIERY, 1100'.
BLYTHE TWP, SCHUYLKILL COUNTY.
..PLAN & SECTION. E. SCHUYL., DISTRICT 14.