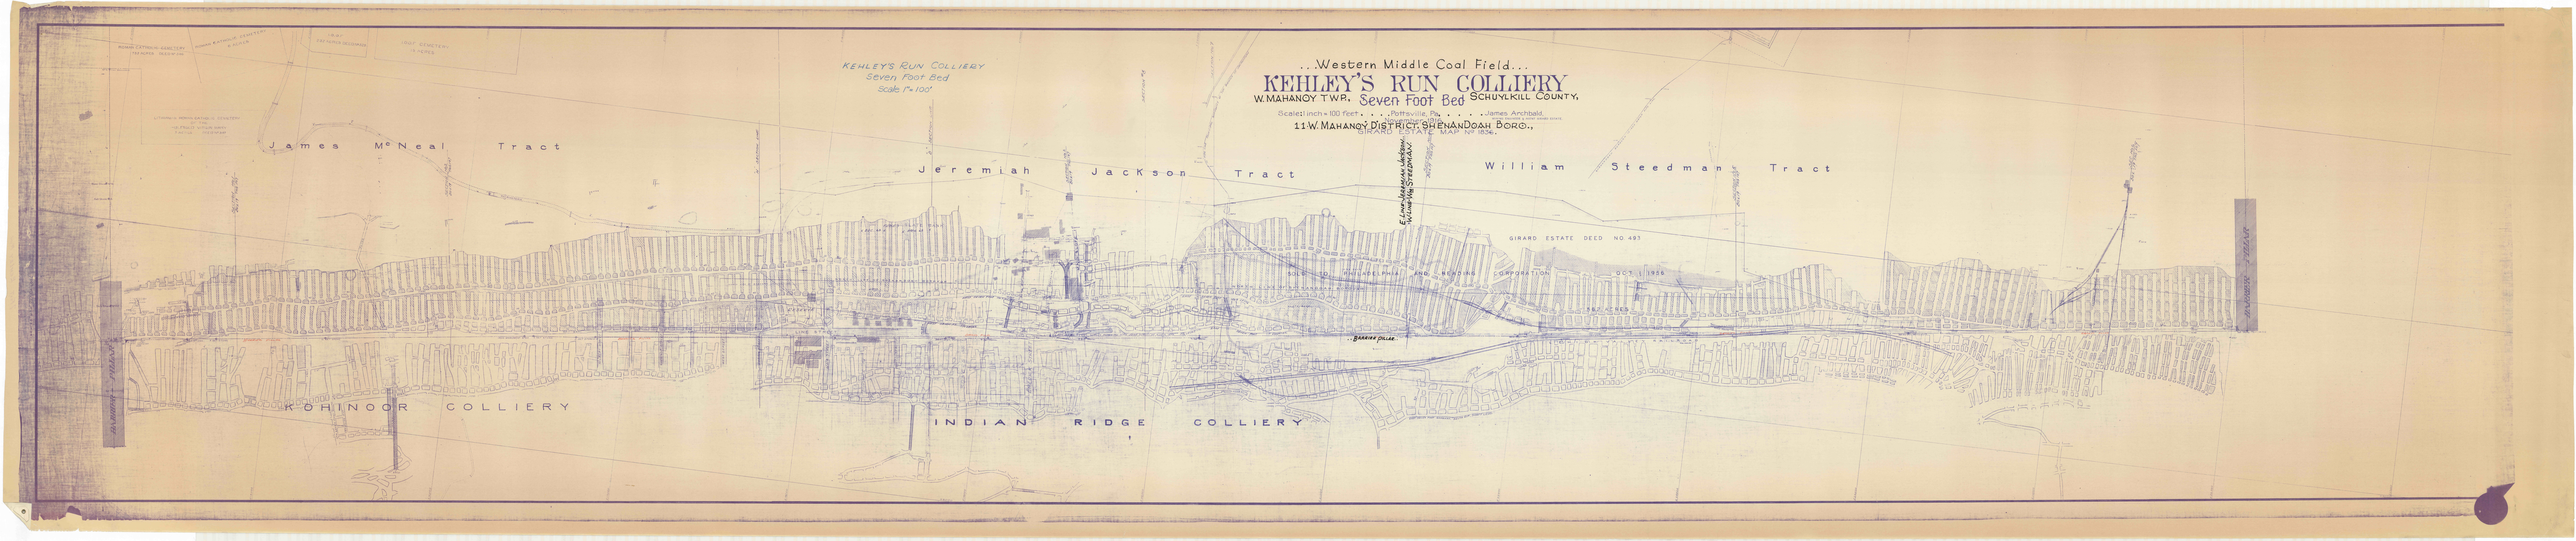
KEHLEY'S RUN COLLIERY
Seven Foot Bed
Scale 1"=100'
..Western Middle Coal Field...
KEHLEY'S RUN COLLIERY
W. MAHANOY TWP. Seven Foot Bed SCHUYLKILL COUNTY,
Scale 1 inch = 100 Feet . . . . Pottsville, Pa. . . . . James Archbald.
11 W. MAHANOY DISTRICT, SHENANDOAH BORO.,
James McNeal Tract
Jeremiah Jackson Tract
William Steedman Tract
GIRARD ESTATE DEED NO. 483
SOLD TO PHILADELPHIA AND READING CORPORATION OCT. 1, 1956
KOHINOOR COLLIERY
INDIAN RIDGE COLLIERY