


KEHLEY'S RUN COLLIERY
SEVEN FOOT VEIN
SCALE; 1"=100'

WESTERN MIDDLE FIELD.. KEHLEY'S RUN COLLIERY

W. MAHONEY TWP, SCHUYLKILL COUNTY, SHENANDOAH BORO.,
11 W. MAH., DISTRICT.

KE

Scale

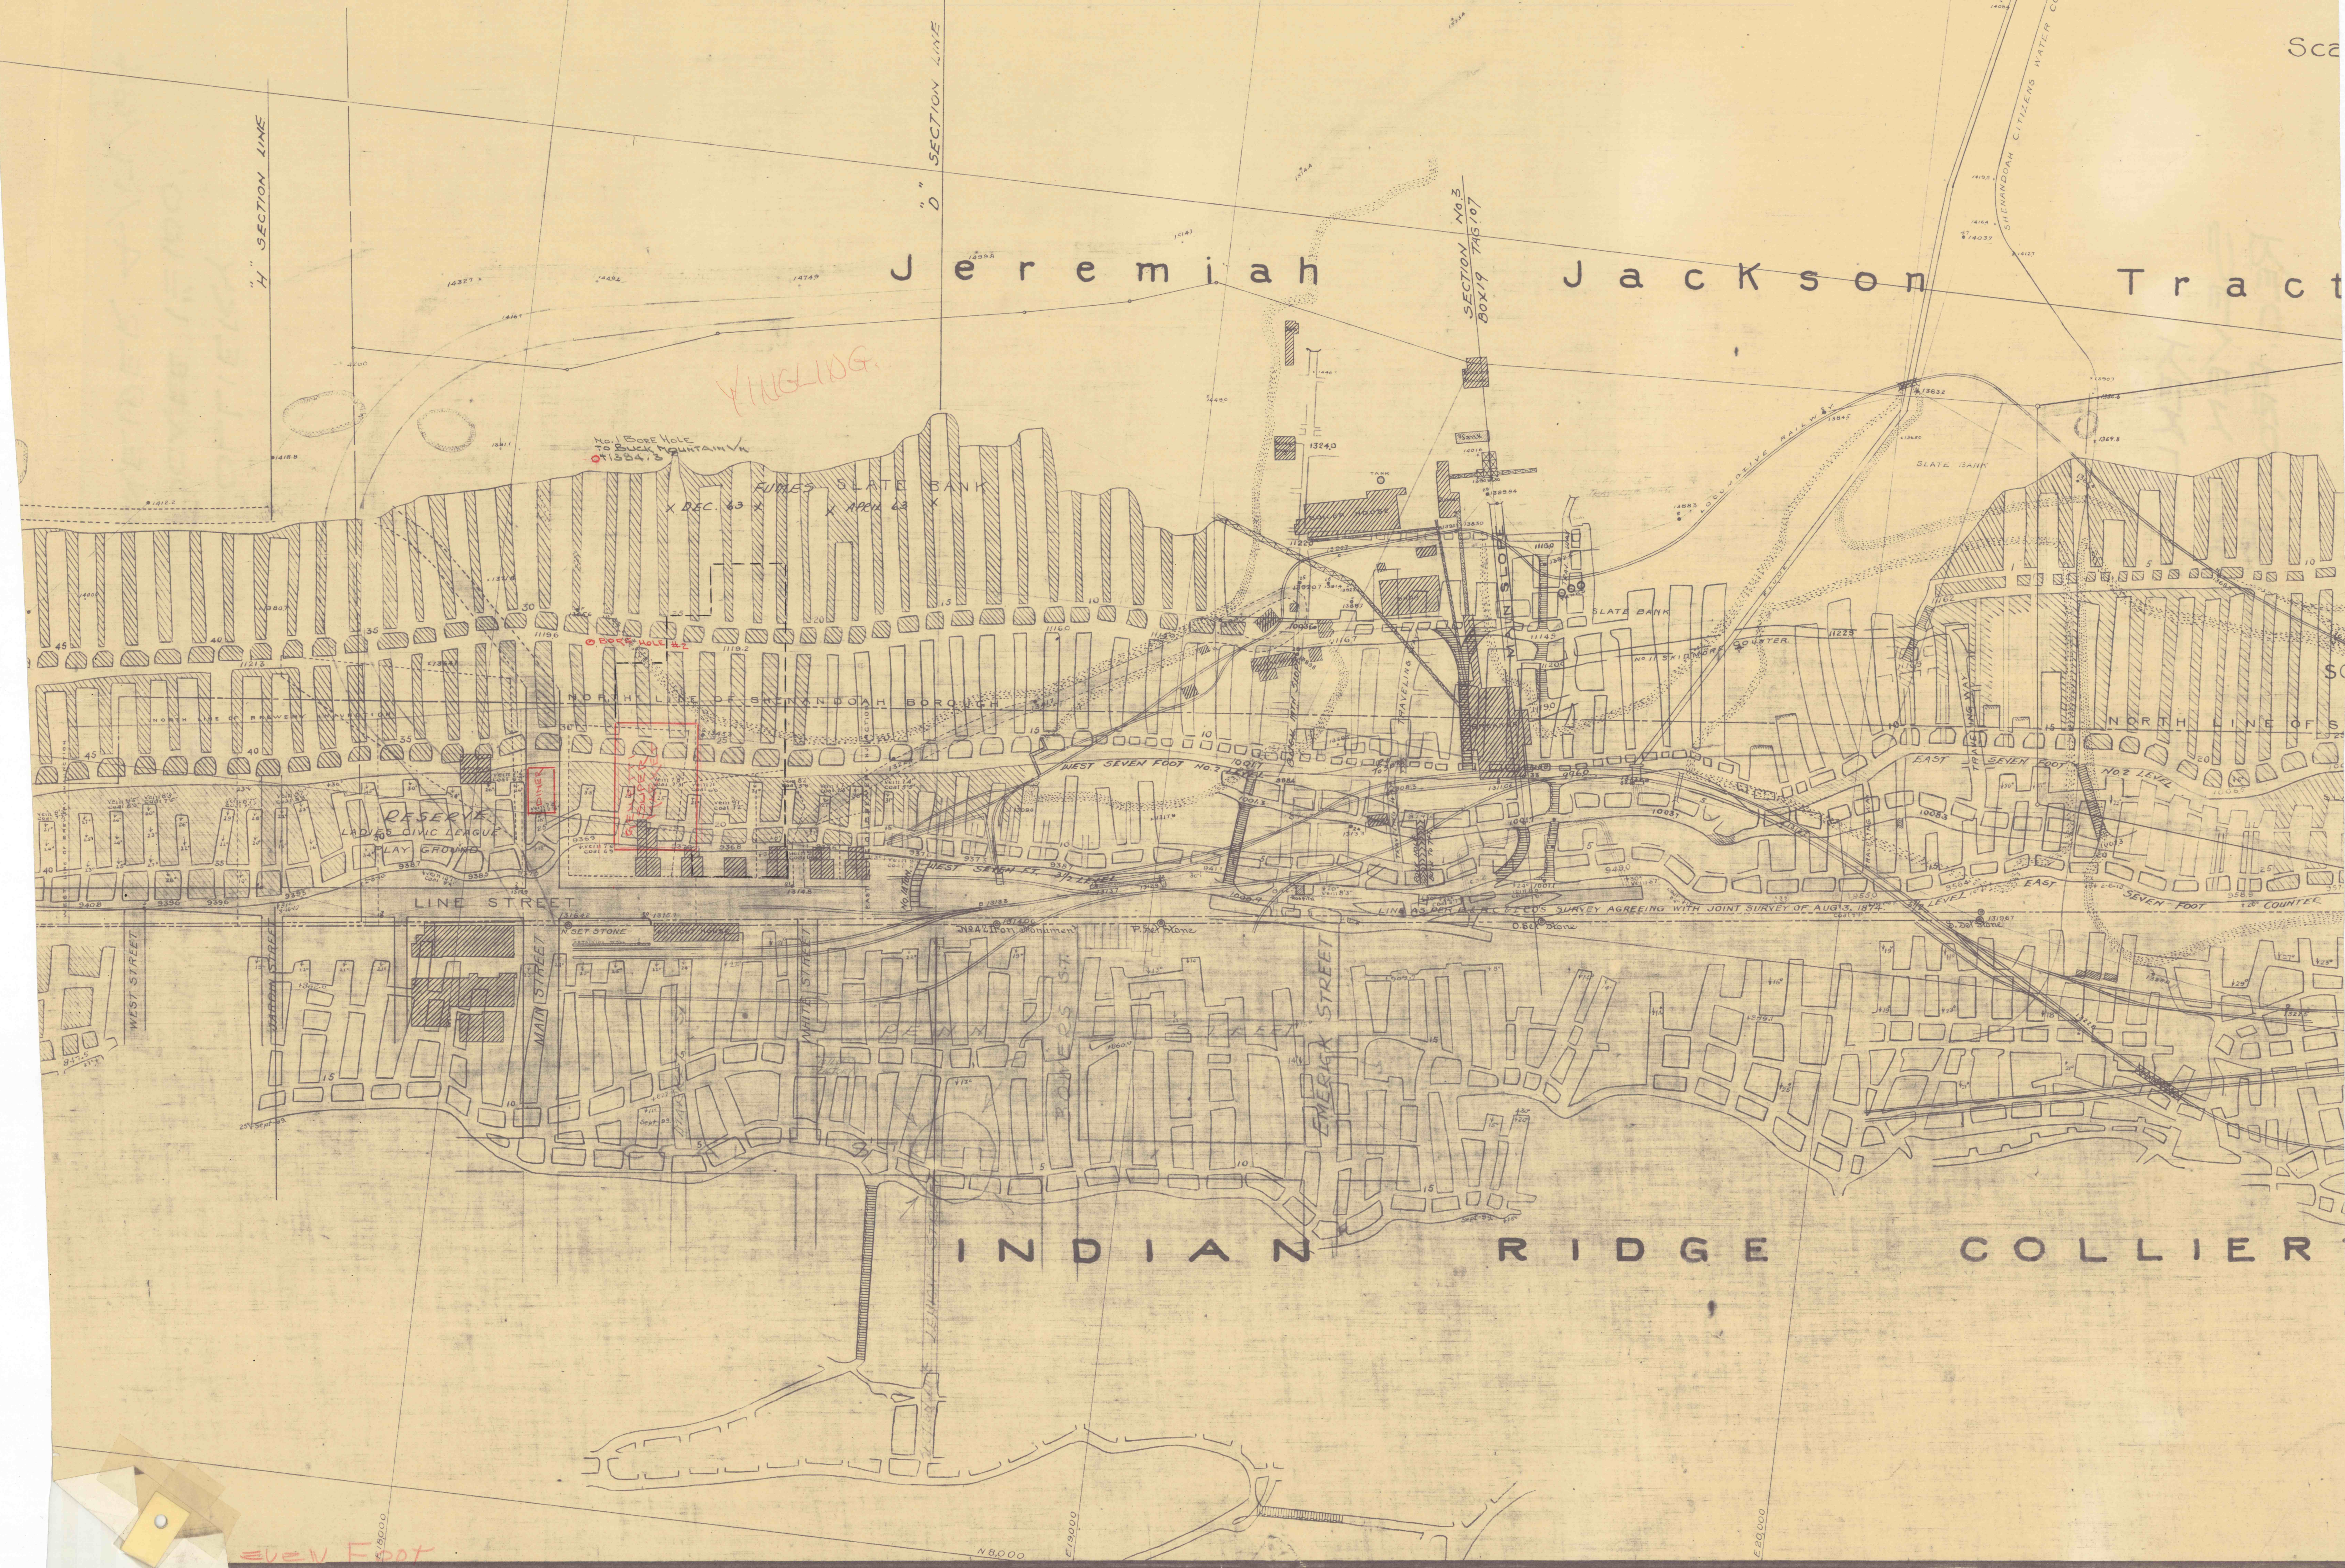

SEVEN FOOT