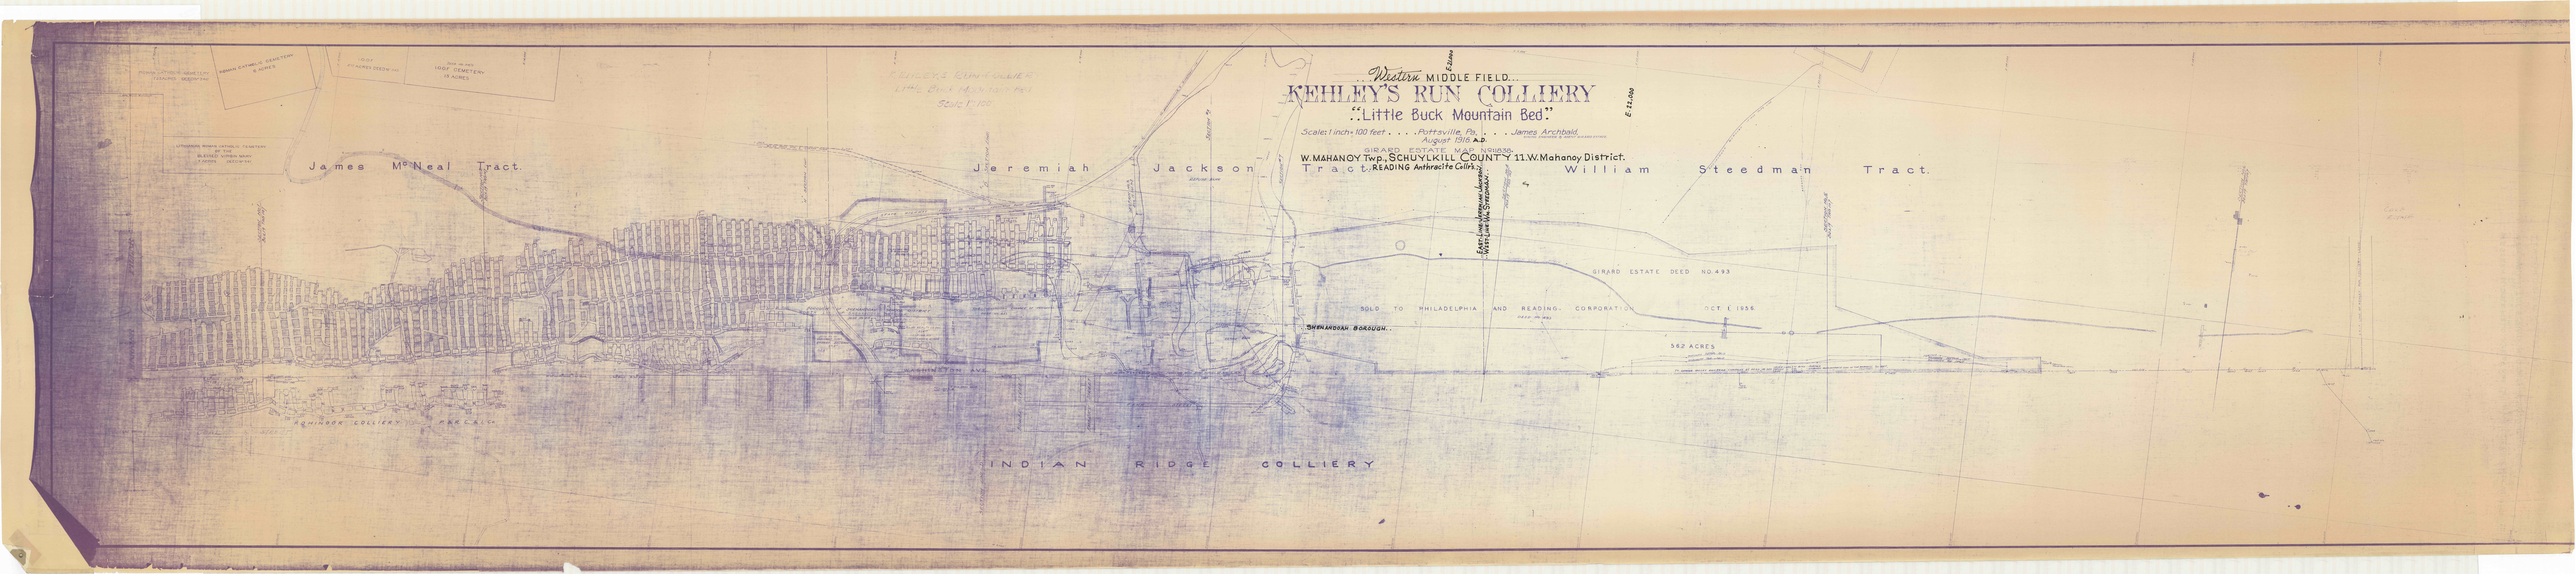

...Western MIDDLE FIELD...
KEHLEY'S RUN COLLIERY
"Little Buck Mountain Bed."
Scale: 1 inch = 100 feet . . . Pottsville, Pa. . . . James Archbald.
GIRARD ESTATE MAP NO1836.
W. MAHANOY Twp., SCHUYLKILL COUNTY 11.W.Mahanoy District.
Tract. READING Anthracite Coll's.
James McNeal Tract.
Jeremiah Jackson Tract.
William Steedman Tract.
E. Line Jeremiah Jackson
West Line Wm Steedman
GIRARD ESTATE DEED NO.493
SOLD TO PHILADELPHIA AND READING CORPORATION OCT. 1 1956
SHENANDOAH BOROUGH.
562 ACRES
INDIAN RIDGE COLLIERY