


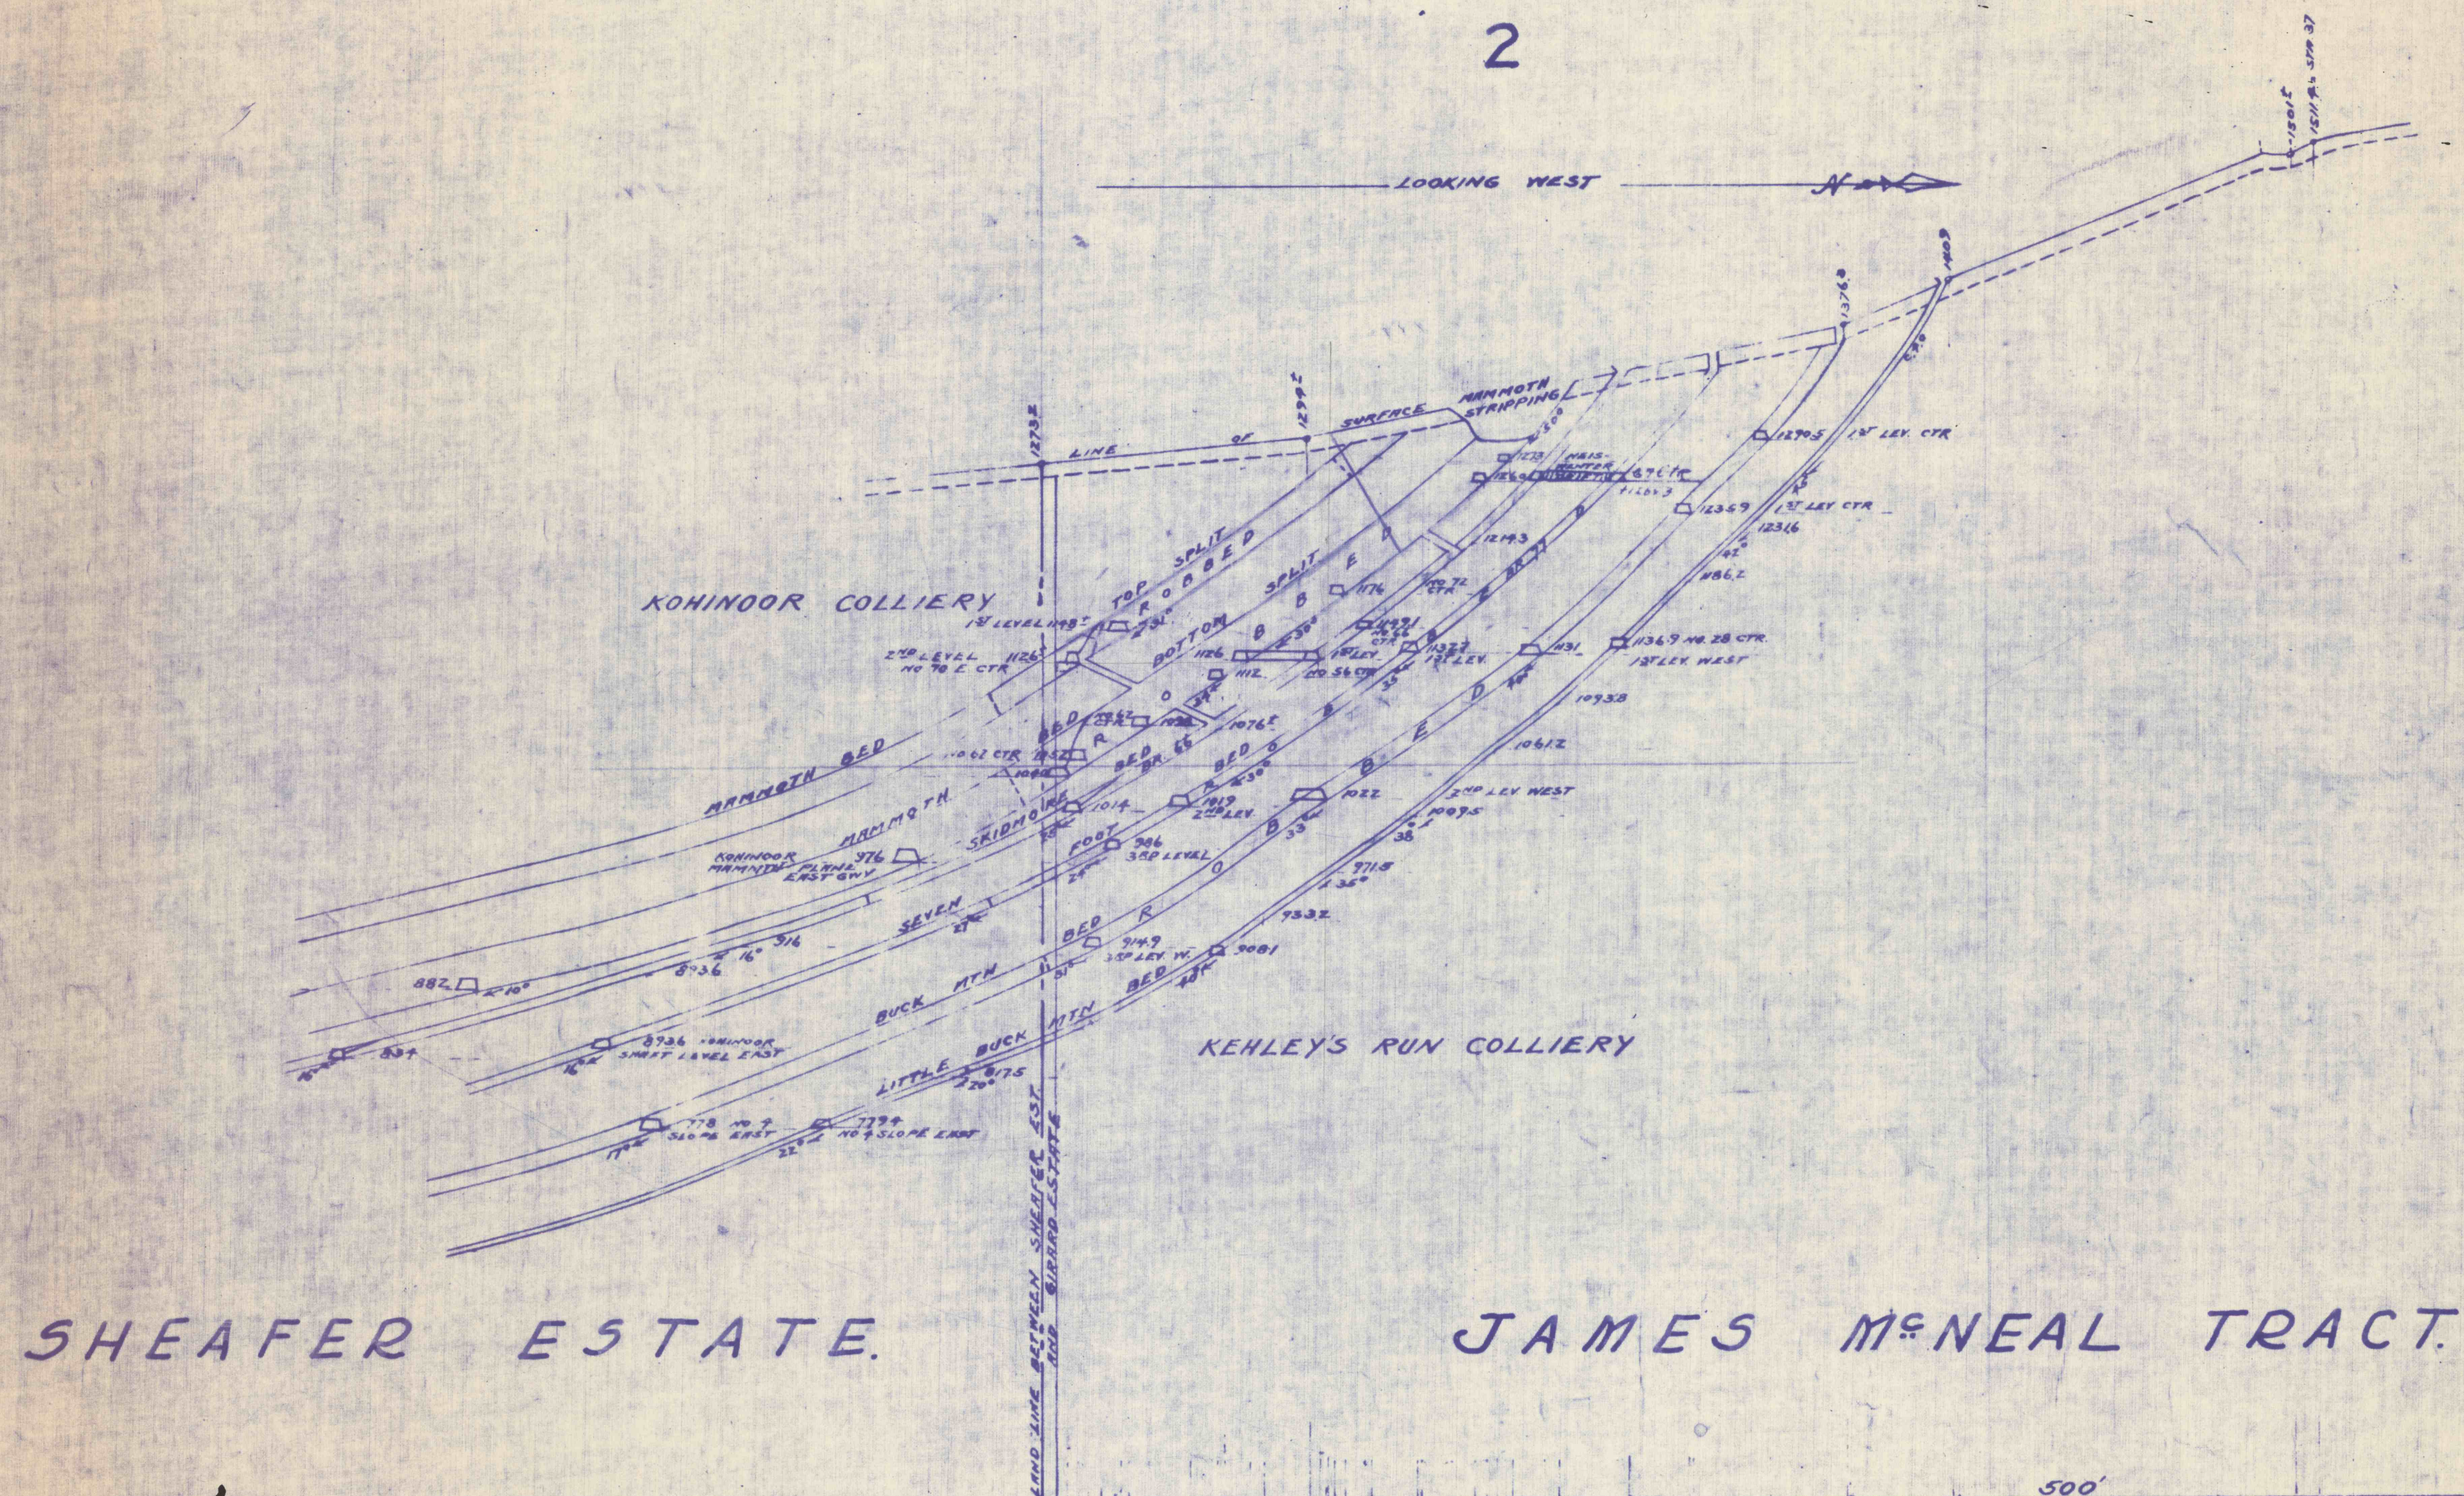

..Western Middle Field.. KEHLEYS RUN COLLIERY.
 .. CROSS SECTION ON LINE OF NO. 28 BREAST ON 3RD LEVEL WEST LITTLE BUCK GWY."

SCALE: 1" = 100'.
 FRACKVILLE, PENNA. THOMAS COLLIERY COMPANY, JUN 4-1917, A.D.
 SHENANDOAH, PENNA.

W. MAHANOEY TWP, SCHUYLKILL COUNTY, SHENANDOAH BORO, PA.,
 II W. MAH., DISTRICT.. Madeira Hill Coal Company.