



KEHLEY'S RUN COLLIERY

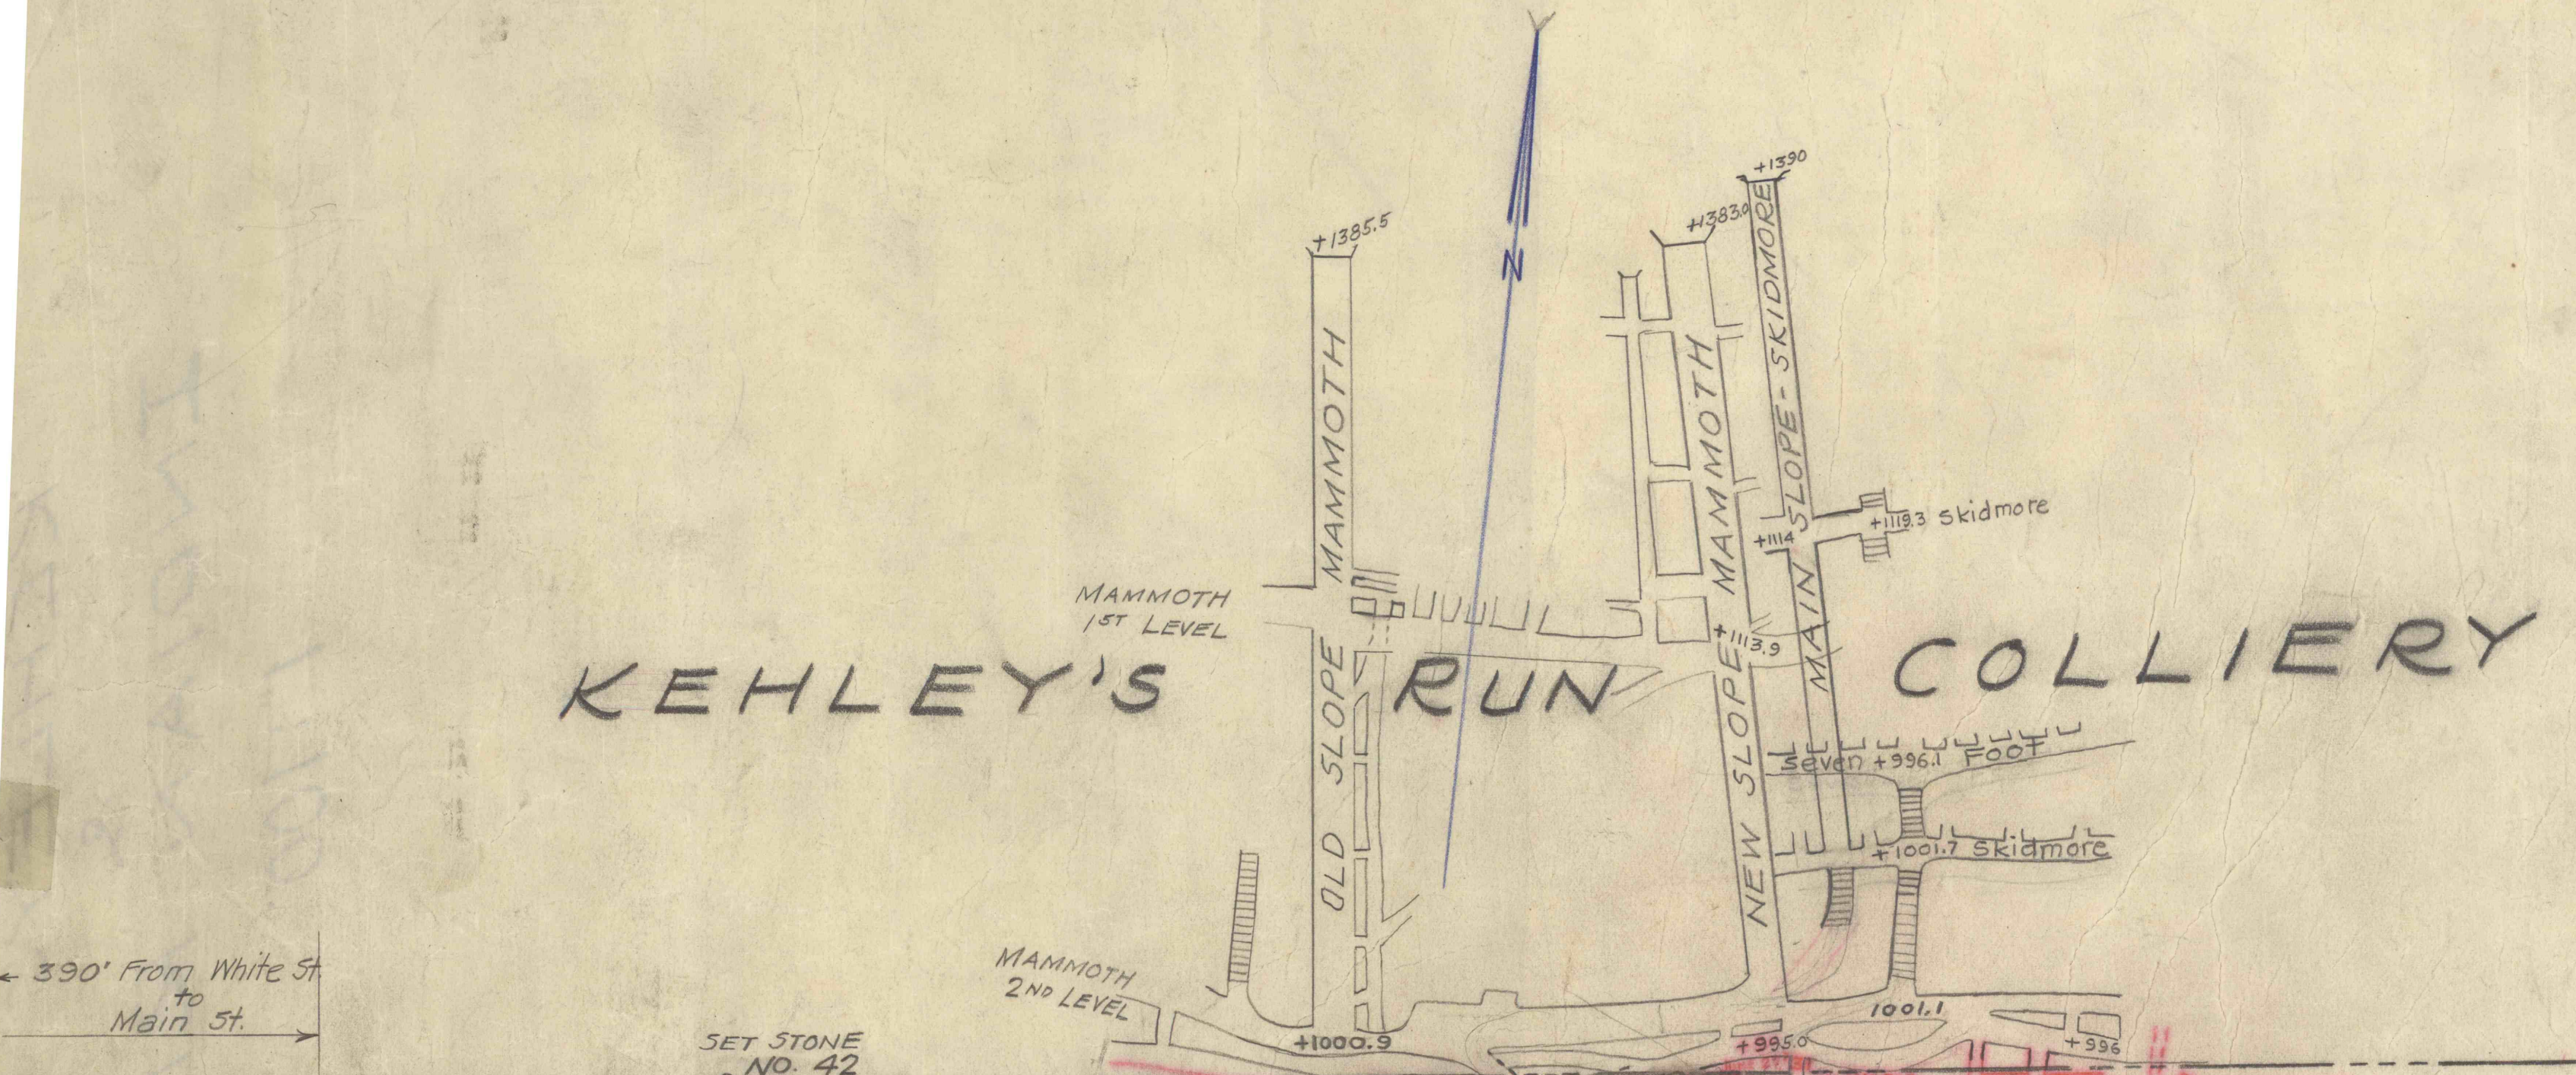

← 390' From White St. to Main St. →

SOUTH LINE GIRARD ESTATE

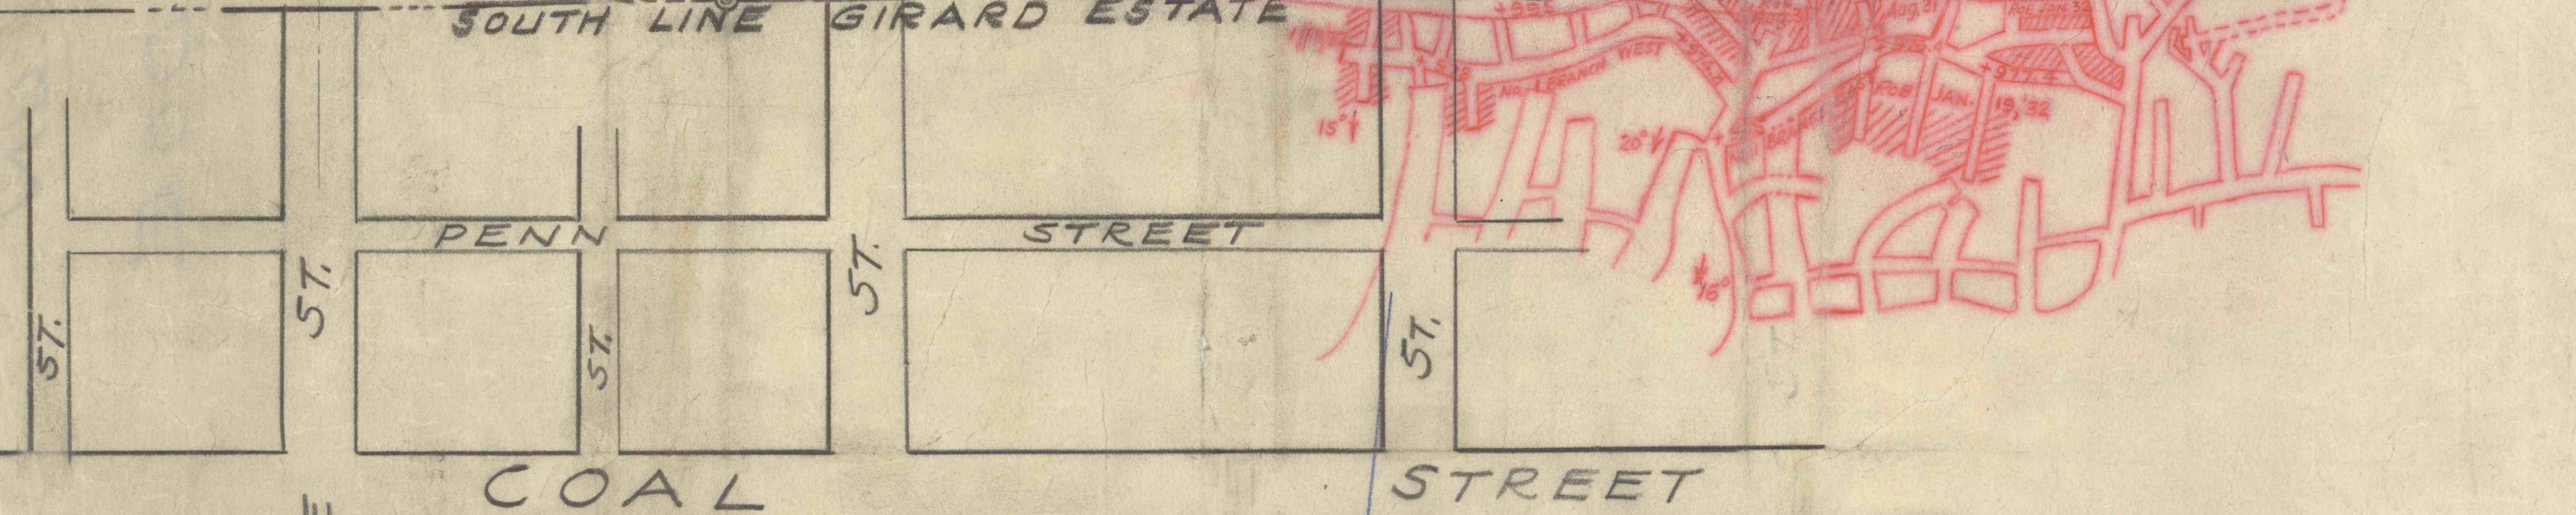

INDIAN RIDGE COLLIERY

Scale 1" = 100'

KEHLEY'S RUN COLLIERY
INDIAN RIDGE COLLIERY
181