


WESTERN MIDDLE FIELD:
 KNICKERBOCKER COLLIERY. X-SECTION 1117. 1"=100'.
 MAHANŌY Twp., EAST MAHANŌY DISTRICT #10.
 SCHUYLKILL COUNTY, PA., READING ANTHRACITE COLL'YS.

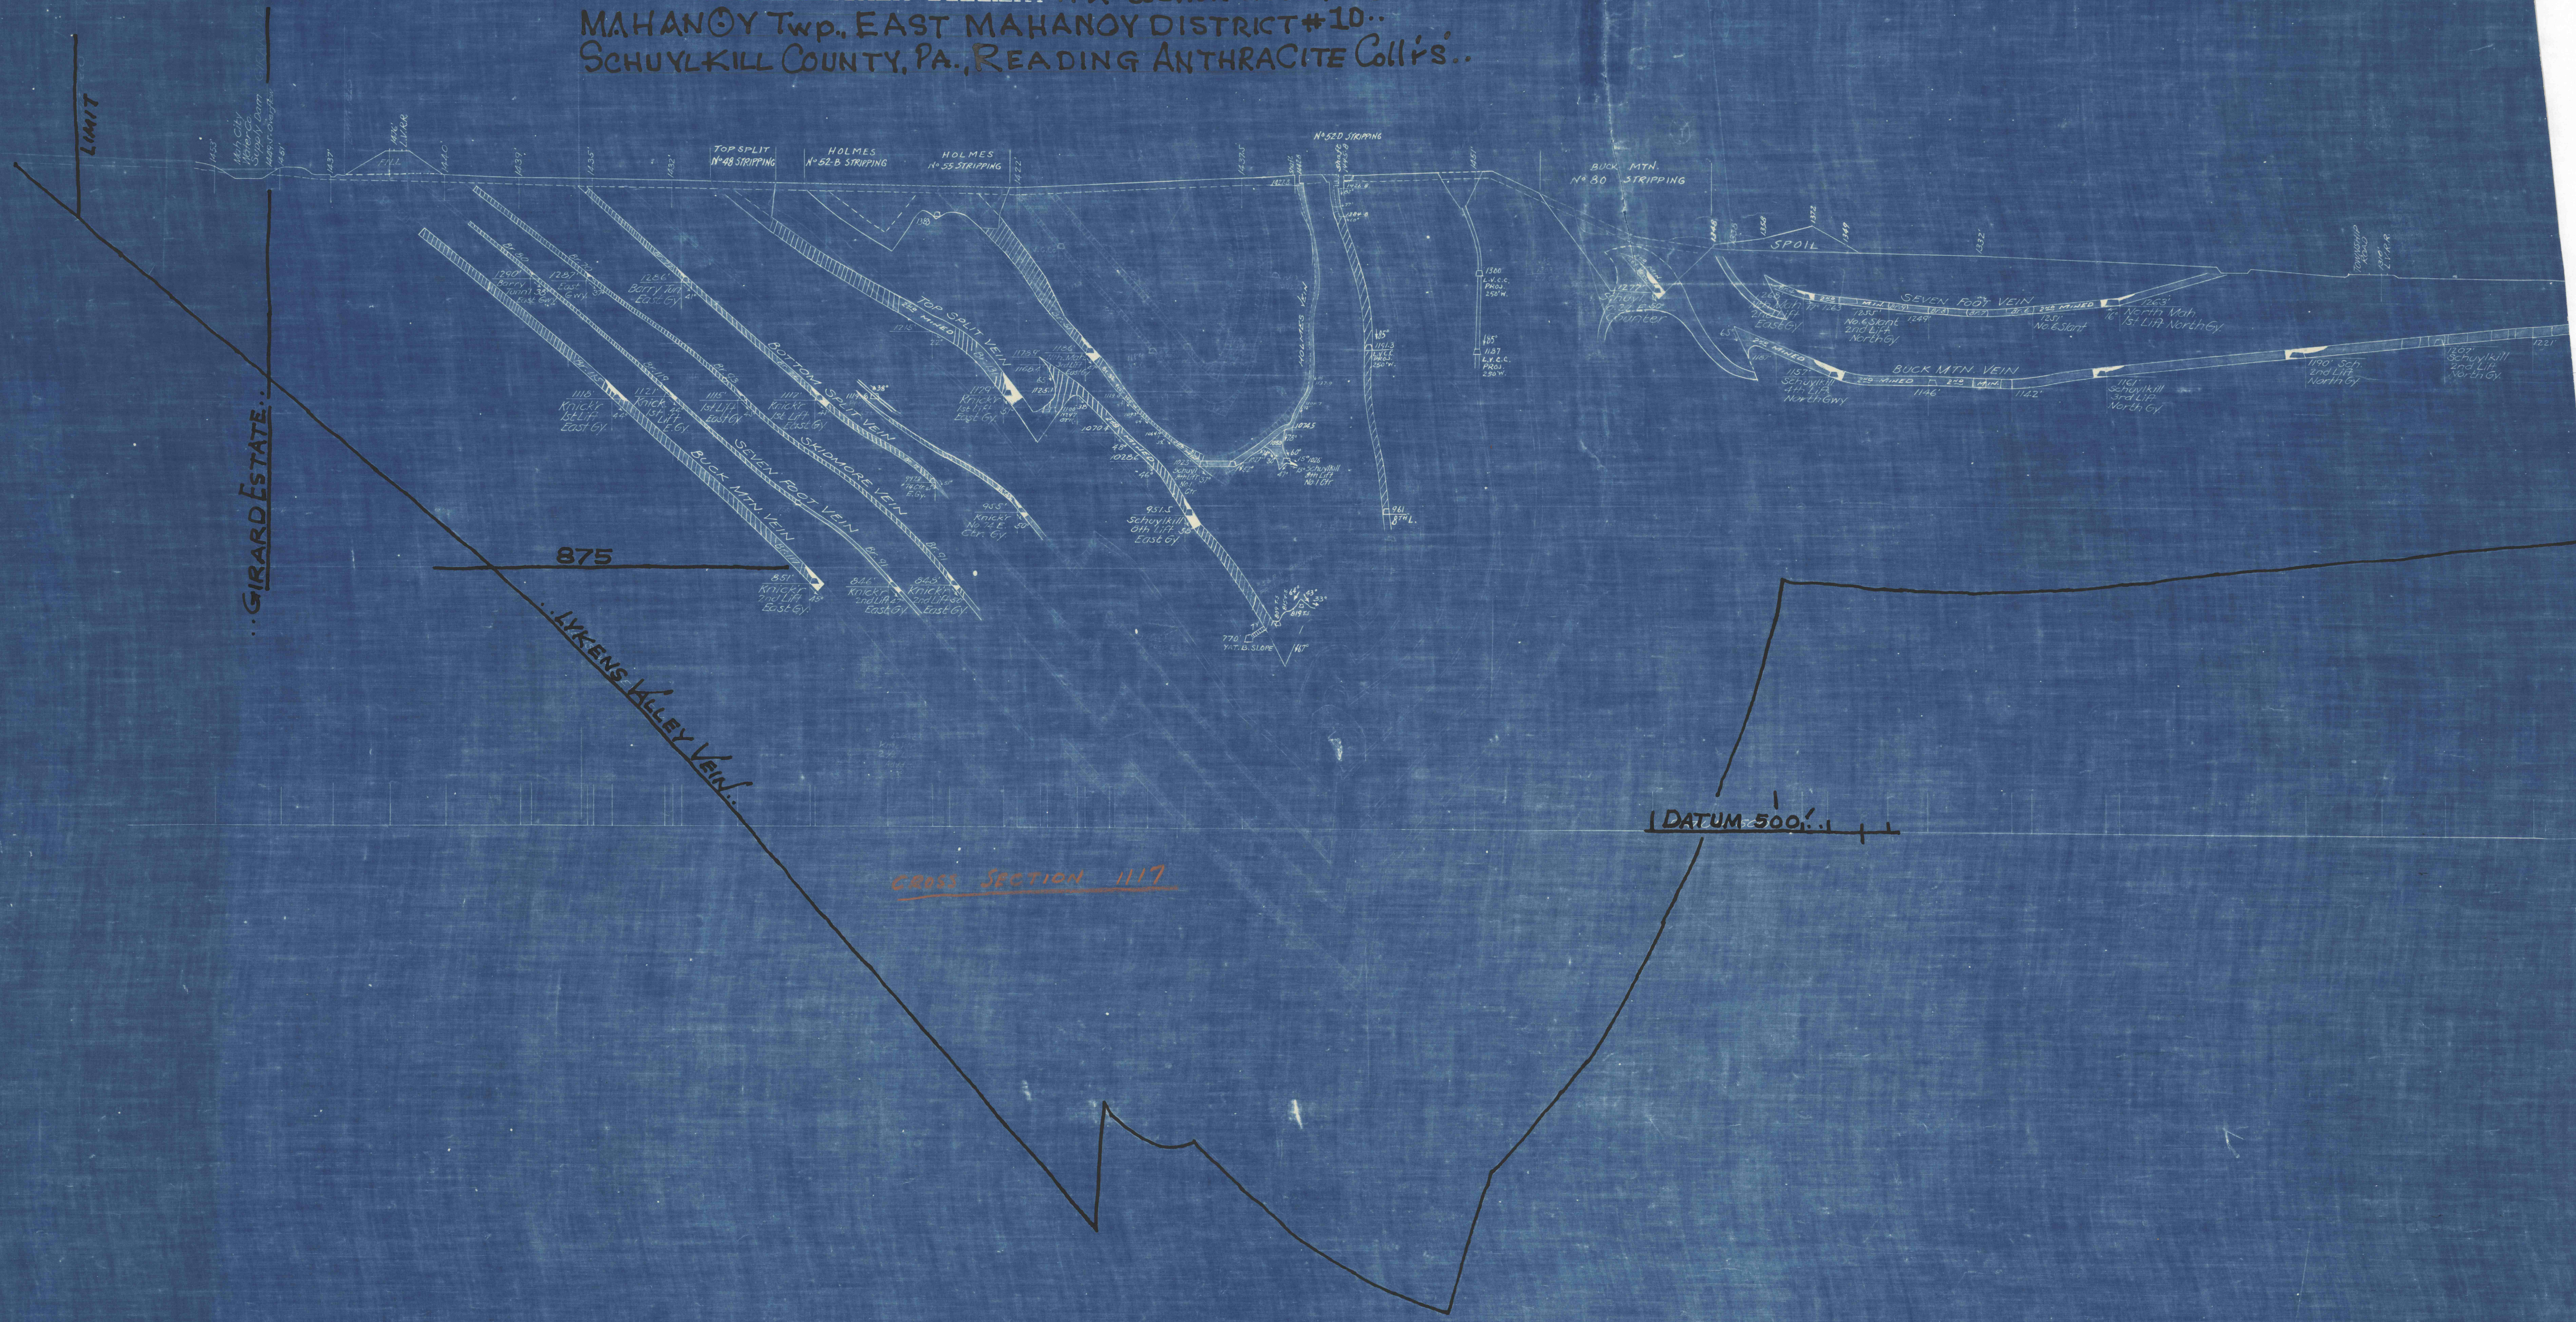

CROSS SECTION 1117