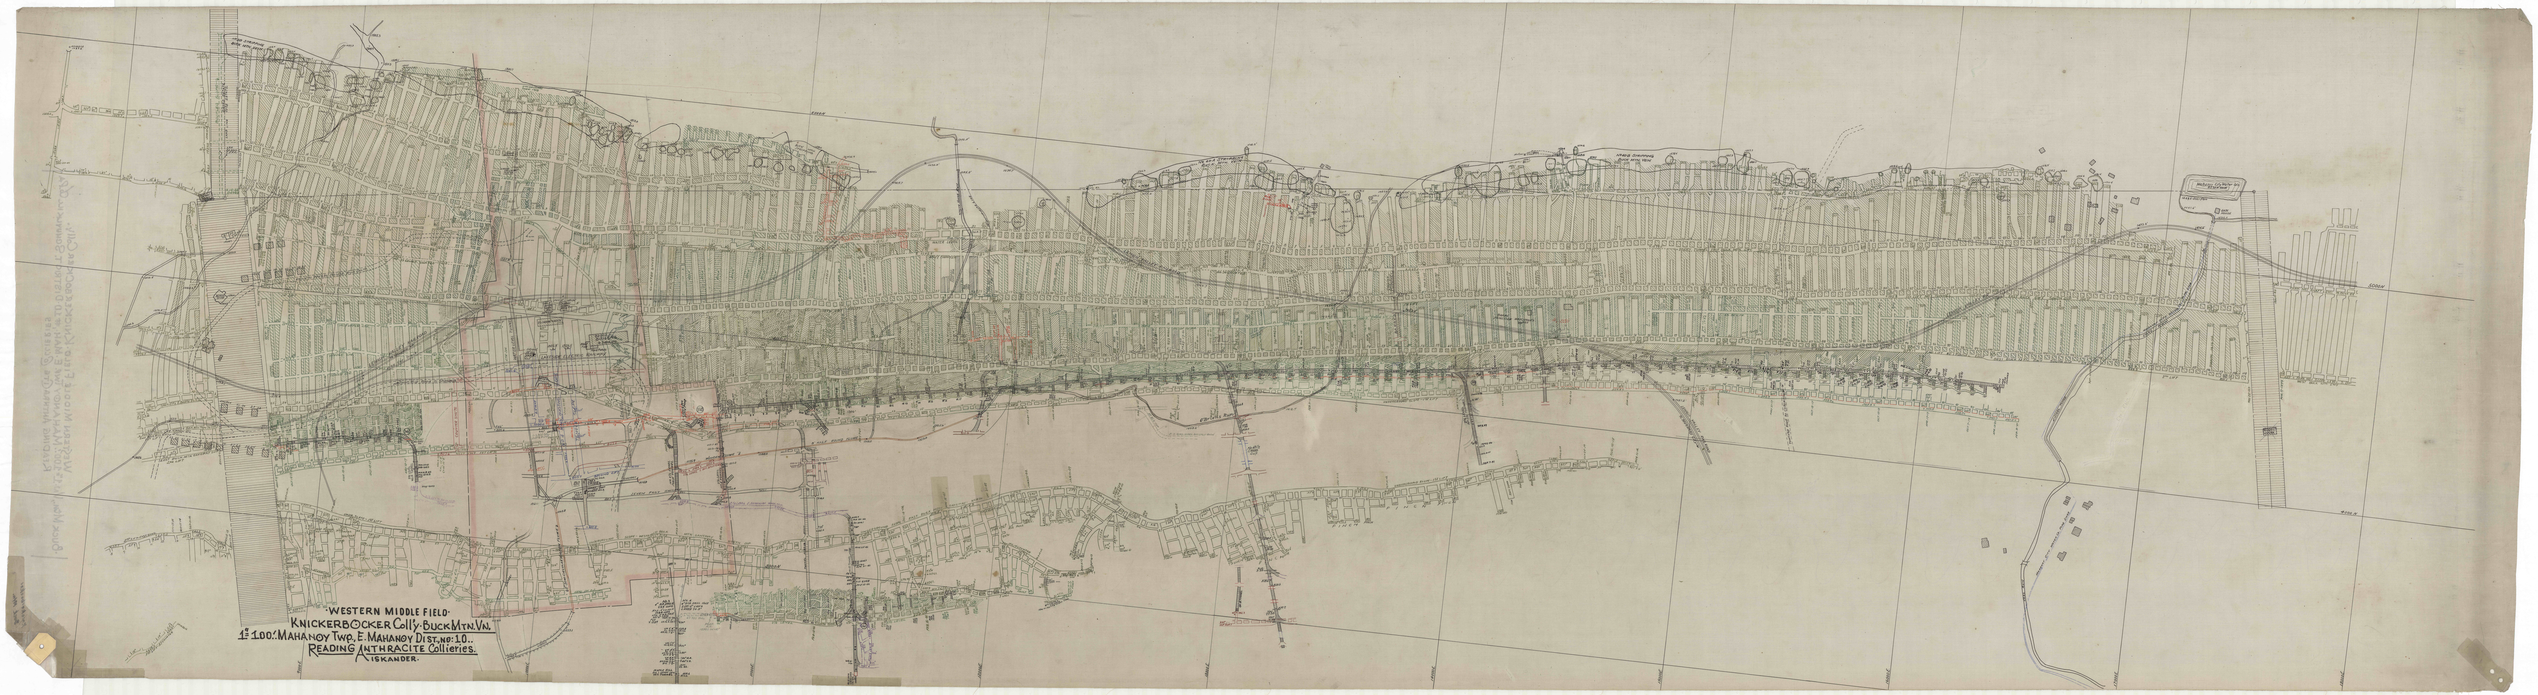

WESTERN MIDDLE FIELD.
KNICKERBOCKER Coll'y. BUCK MTN. VN.
1 in 100 ft. MAHANOY Twp. E. MAHANOY DIST. No: 10.
READING ANTHRACITE Collieries.
MISKANDER.