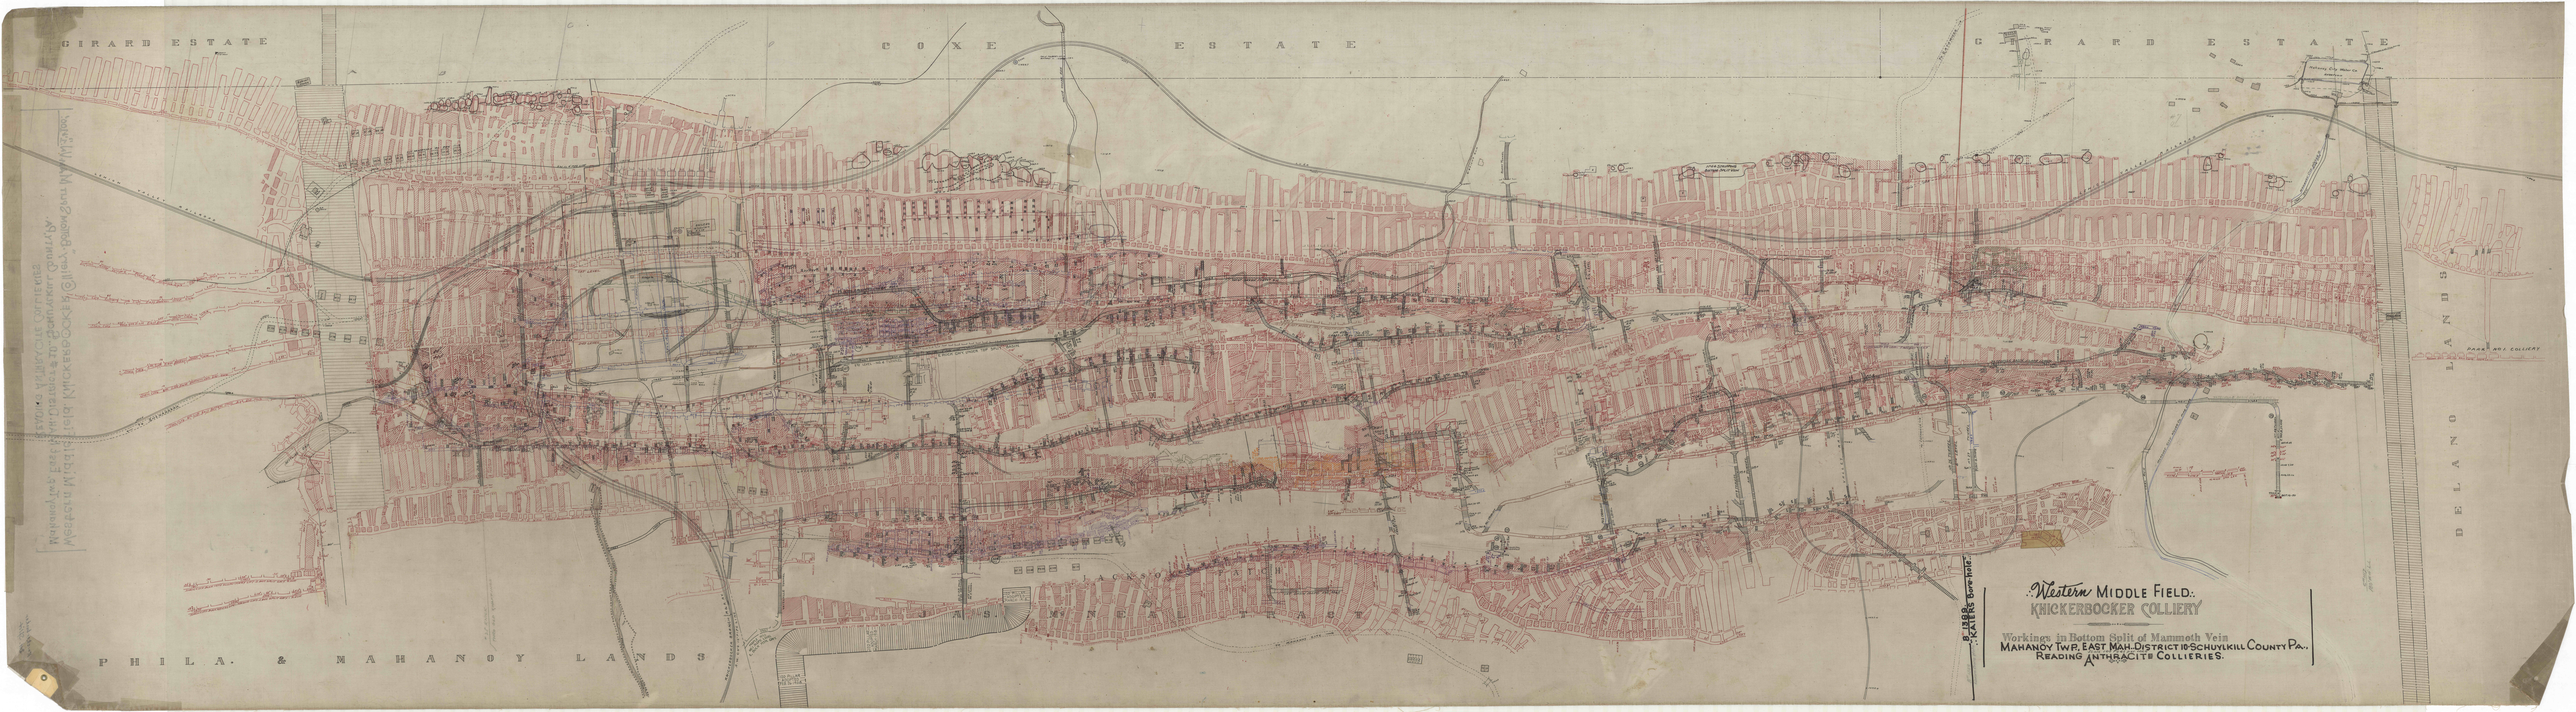
GIRARD ESTATE
COXE ESTATE
GIRARD ESTATE
PHILA. & MAHANOY LANDS
DELANO LANDS
Western MIDDLE FIELD:
KNICKERBOCKER COLLIERY
Workings in Bottom Split of Mammoth Vein
MAHANOY TWP. EAST MAH. DISTRICT IN SCHUYLKILL COUNTY PA.,
READING ANTHRACITE COLLIERIES.