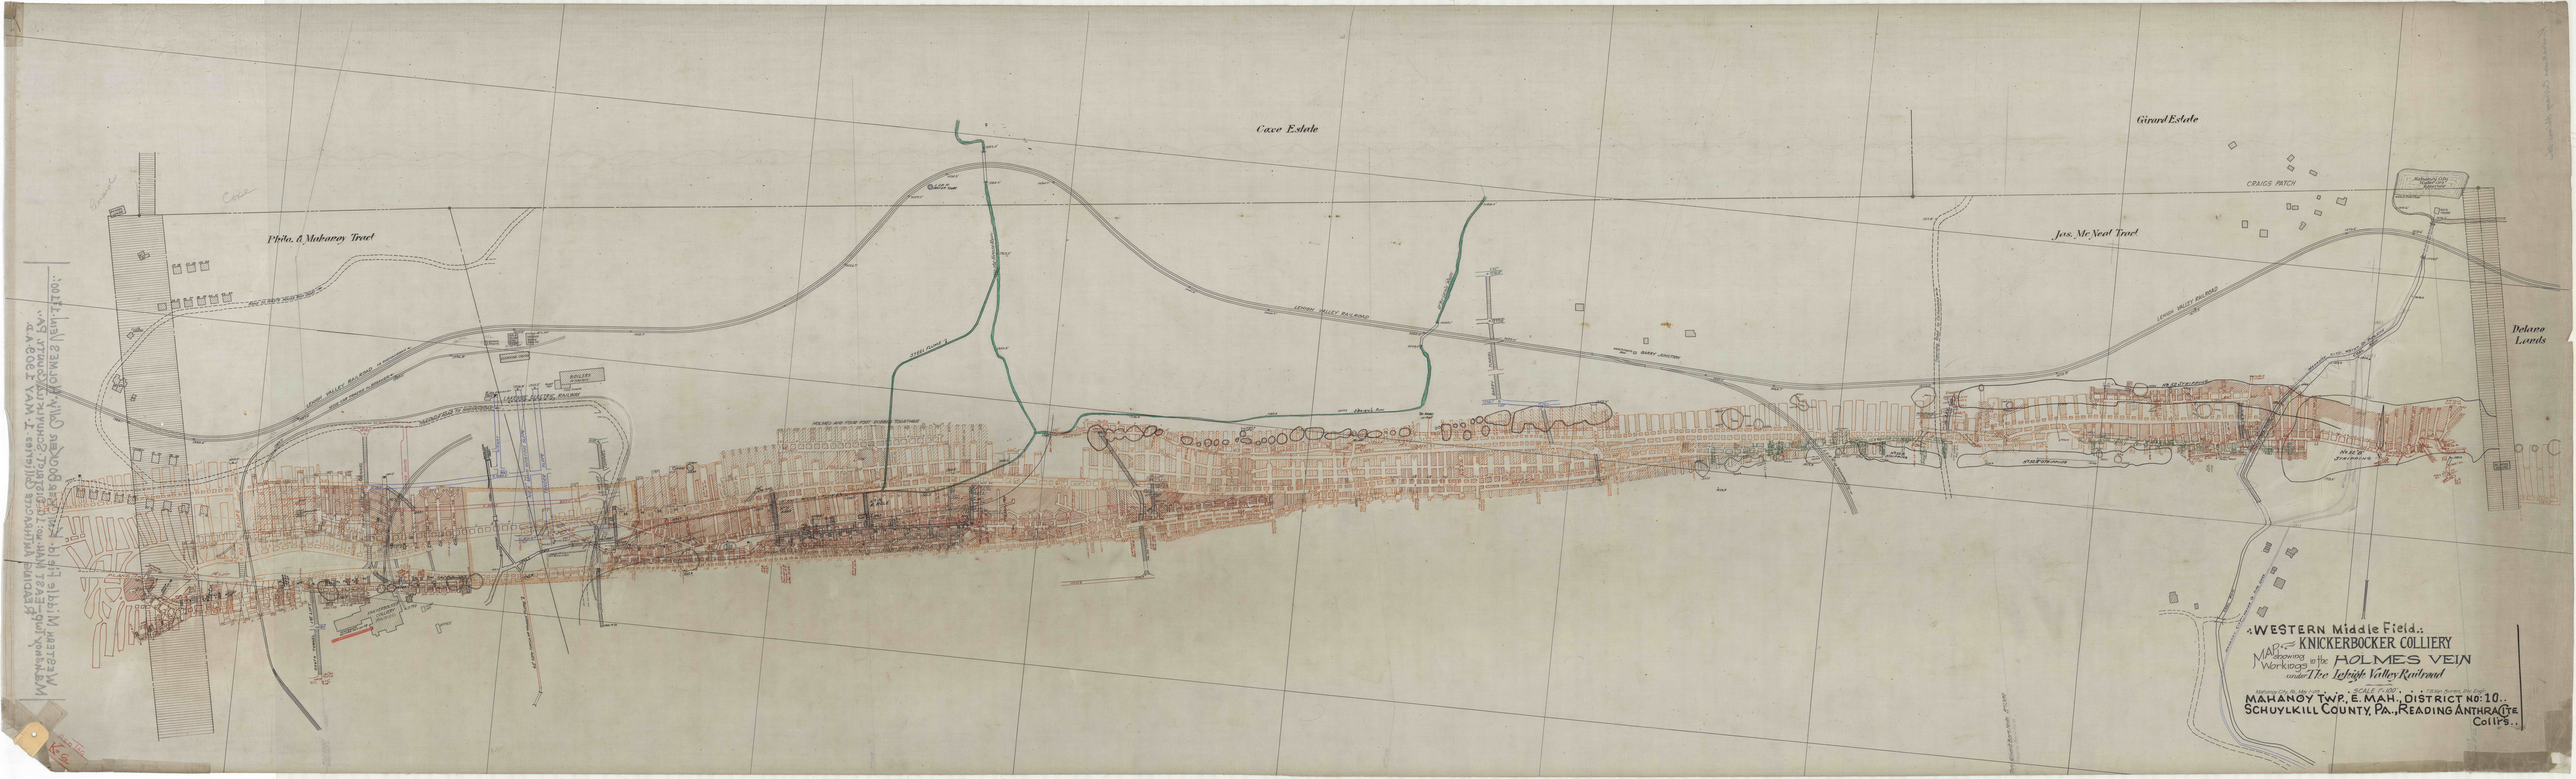
Phila. & Mahanoy Tract
Coxe Estate
Girard Estate
Jess. McNeal Tract
Delano Lands
CRAIGS PATCH
LEHIGH VALLEY RAILROAD
ROLLED AND FOUR FOOT DOUBLE TRACK
WESTERN Middle Field.
MAP of KNICKERBOCKER COLLIERY
showing Workings in the HOLMES VEIN
under The Lehigh Valley Railroad
MAHANOY TWP., E. MAH. DISTRICT NO: 10.,
SCHUYLKILL COUNTY, PA., READING ANTHRACITE Coll'g.