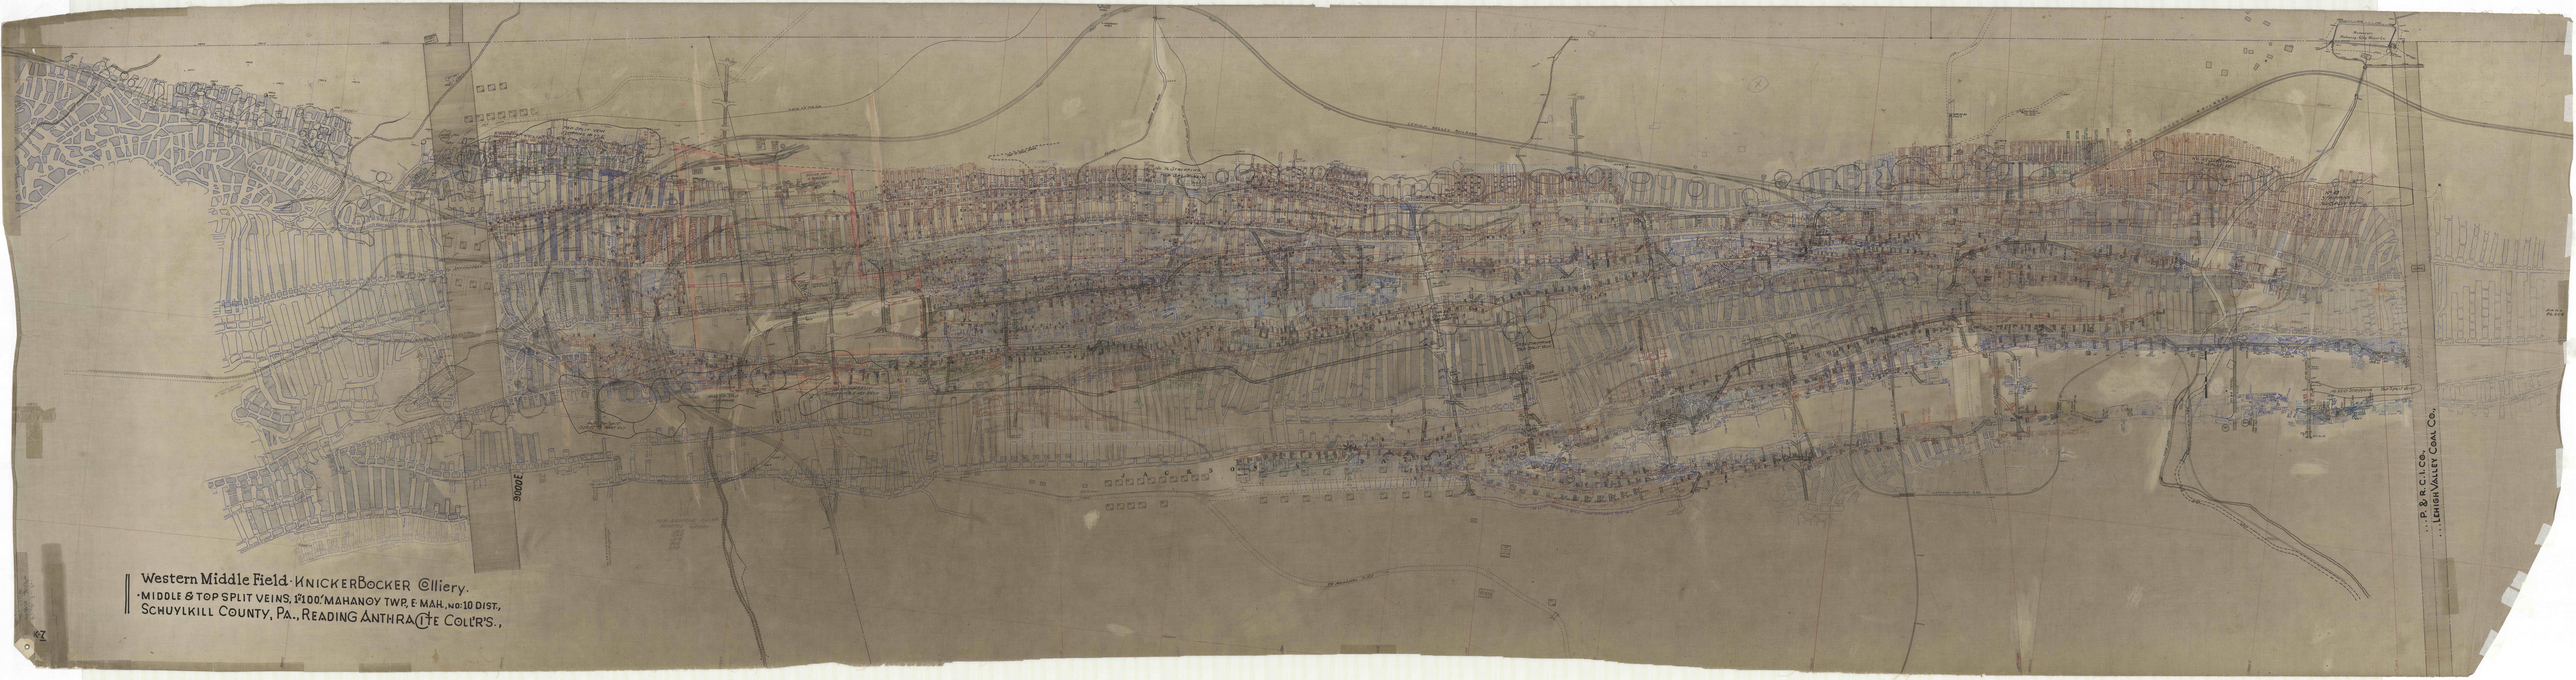

Western Middle Field · KNICKERBOCKER Colliery.
· MIDDLE & TOP SPLIT VEINS, 1" = 100' MAHANOY TWP, E. MAH., NO: 10 DIST.,
SCHUYLKILL COUNTY, PA., READING ANTHRACITE COL'R'S.,
P. & R. C. I. Co.
LEHIGH VALLEY COAL CO.