


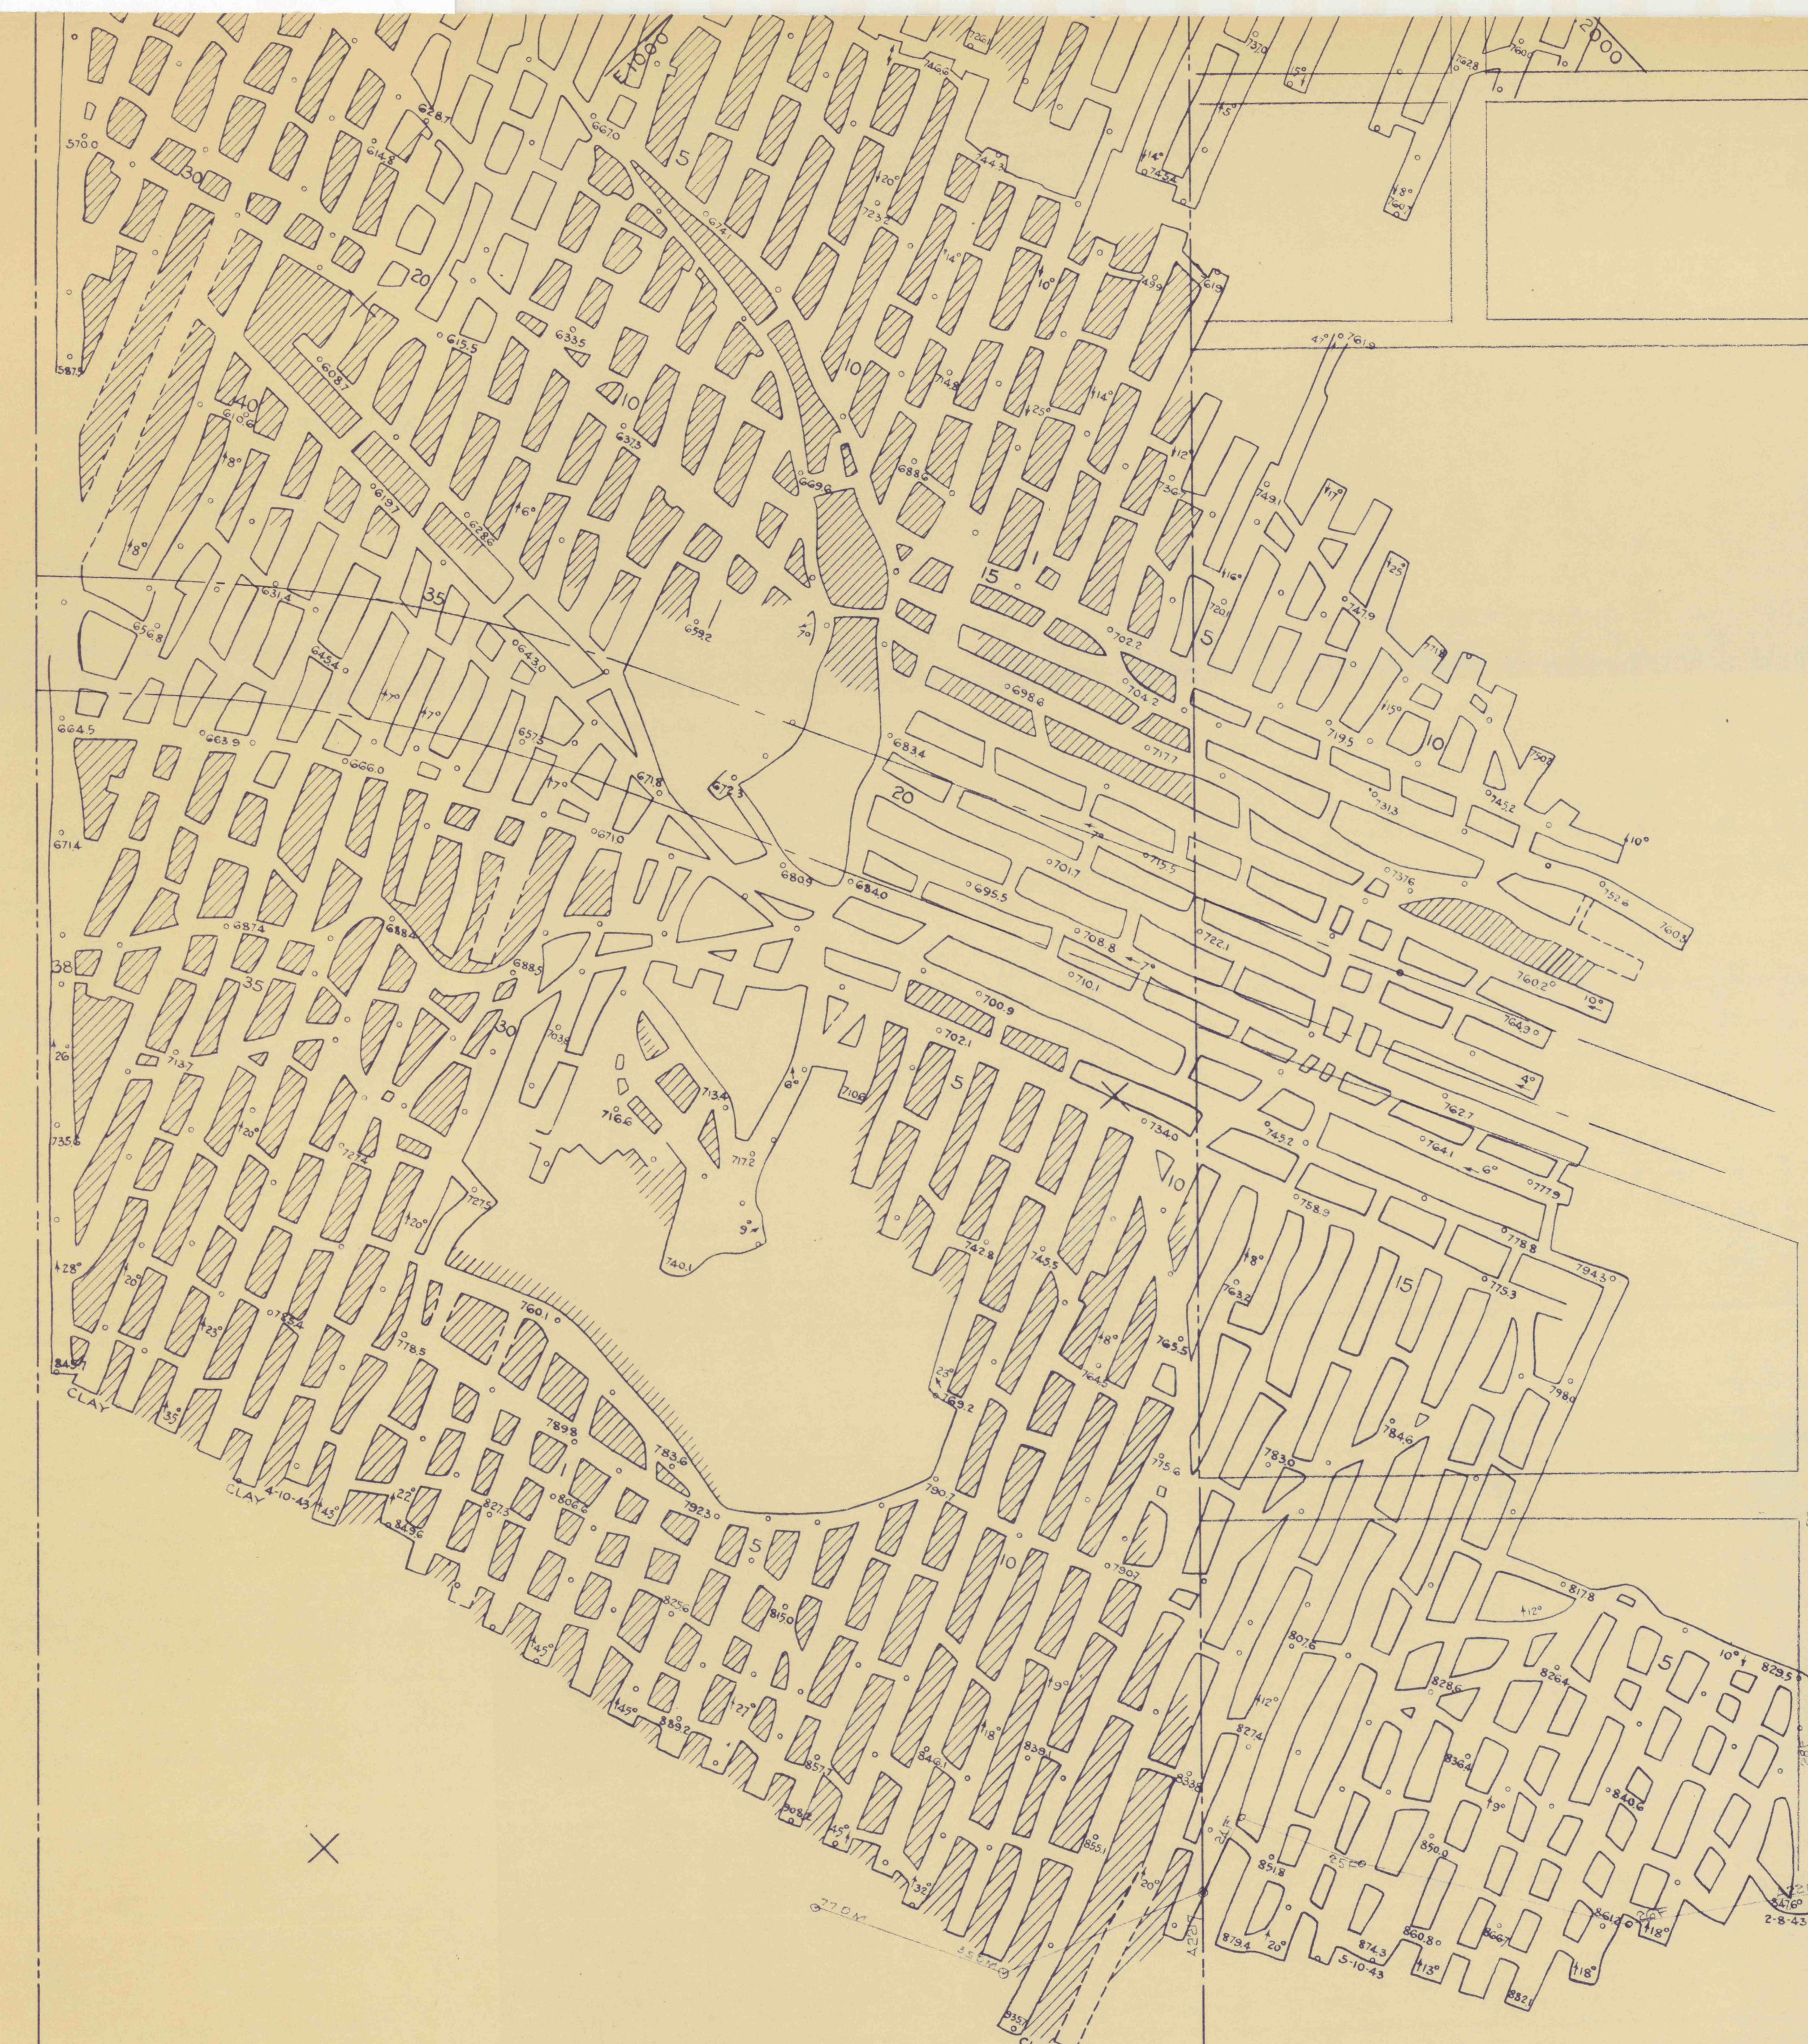

LEHIGH VALLEY COAL CO.
GLEN ALDEN COAL CO.

AUDENRIED

DANA

METCALF

STURDEVANT

CONSOLIDATED

RANDOLPH

KIDDER

HOLLENBACK

TOP ROSS BED
..2 of 5..