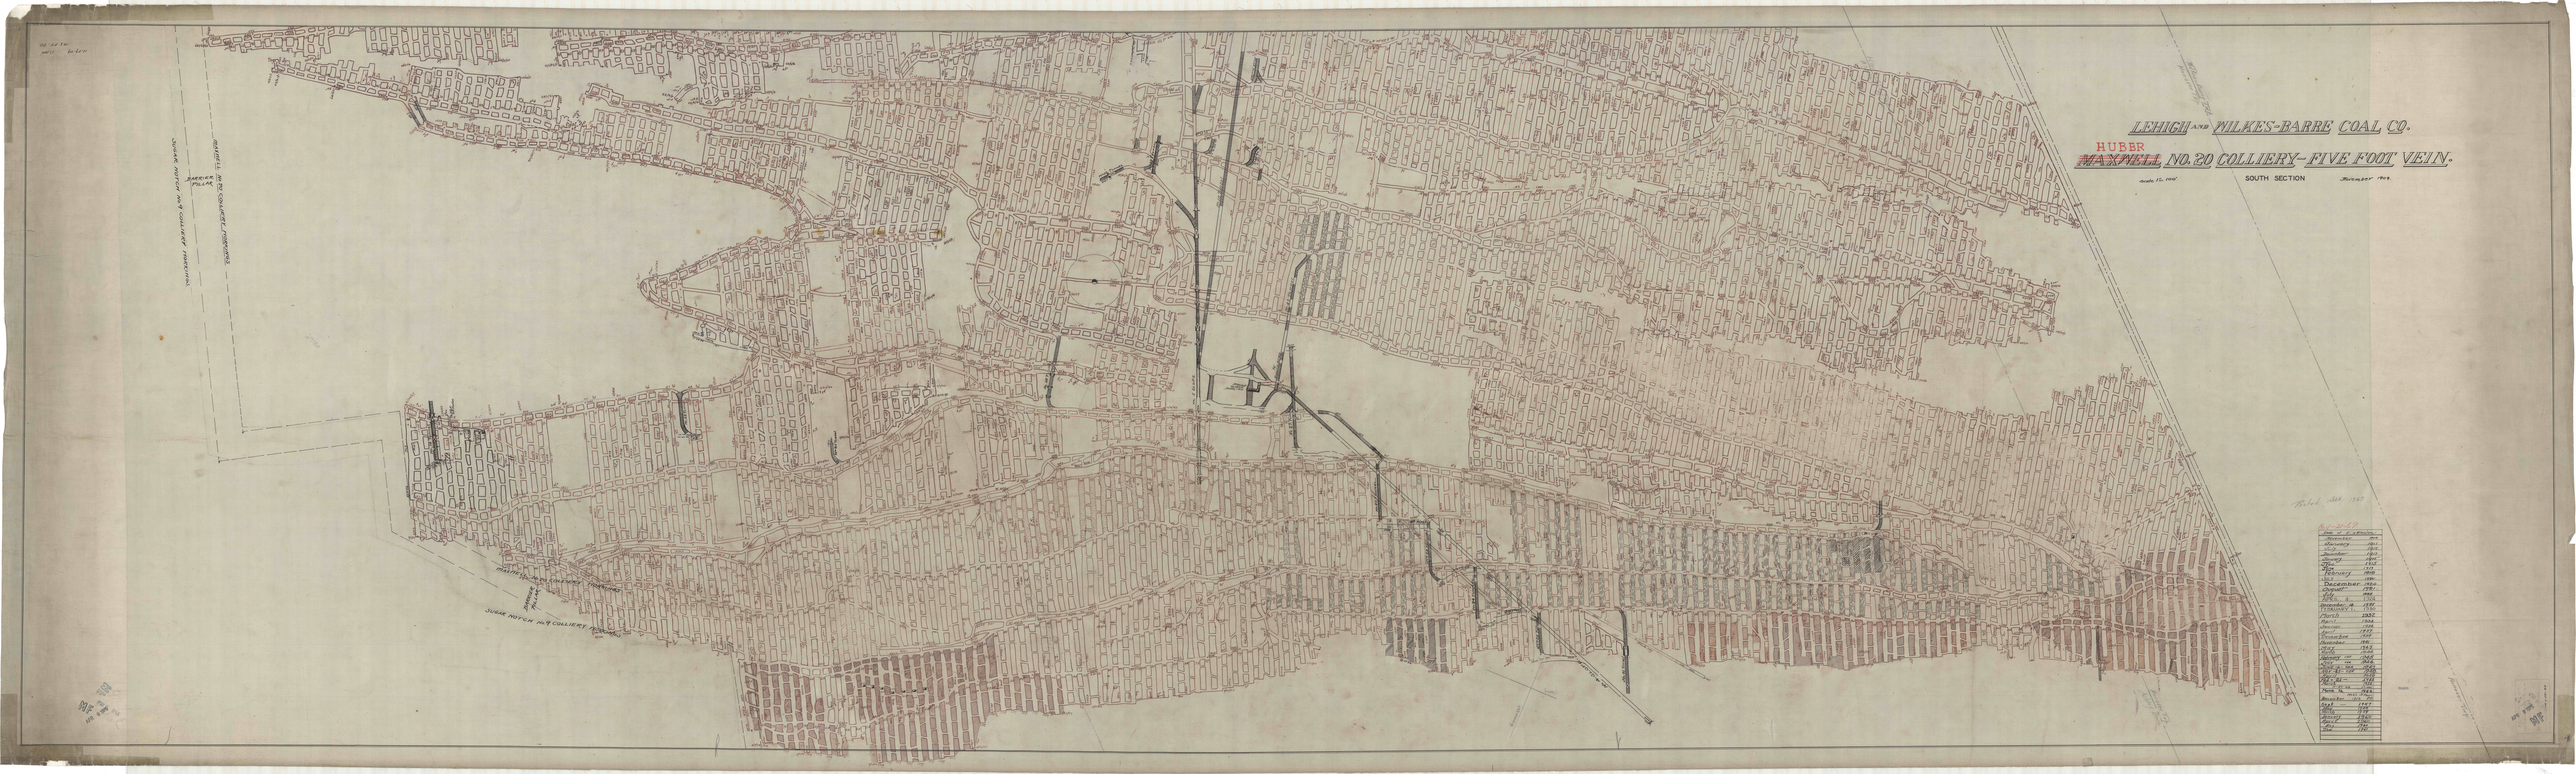

LEHIGH AND WILKES-BARRE COAL CO.
HUBER
MAXWELL NO. 20 COLLIERY-FIVE FOOT VEIN.
SOUTH SECTION
SUGAR NOTCH NO 9 COLLIERY (WORKING)
BARRIER PILLAR
MAXWELL NO. 20 COLLIERY (WORKINGS)
SUGAR NOTCH NO 9 COLLIERY (WORKINGS)