


MF
APR 9 1975
APR 9 1975

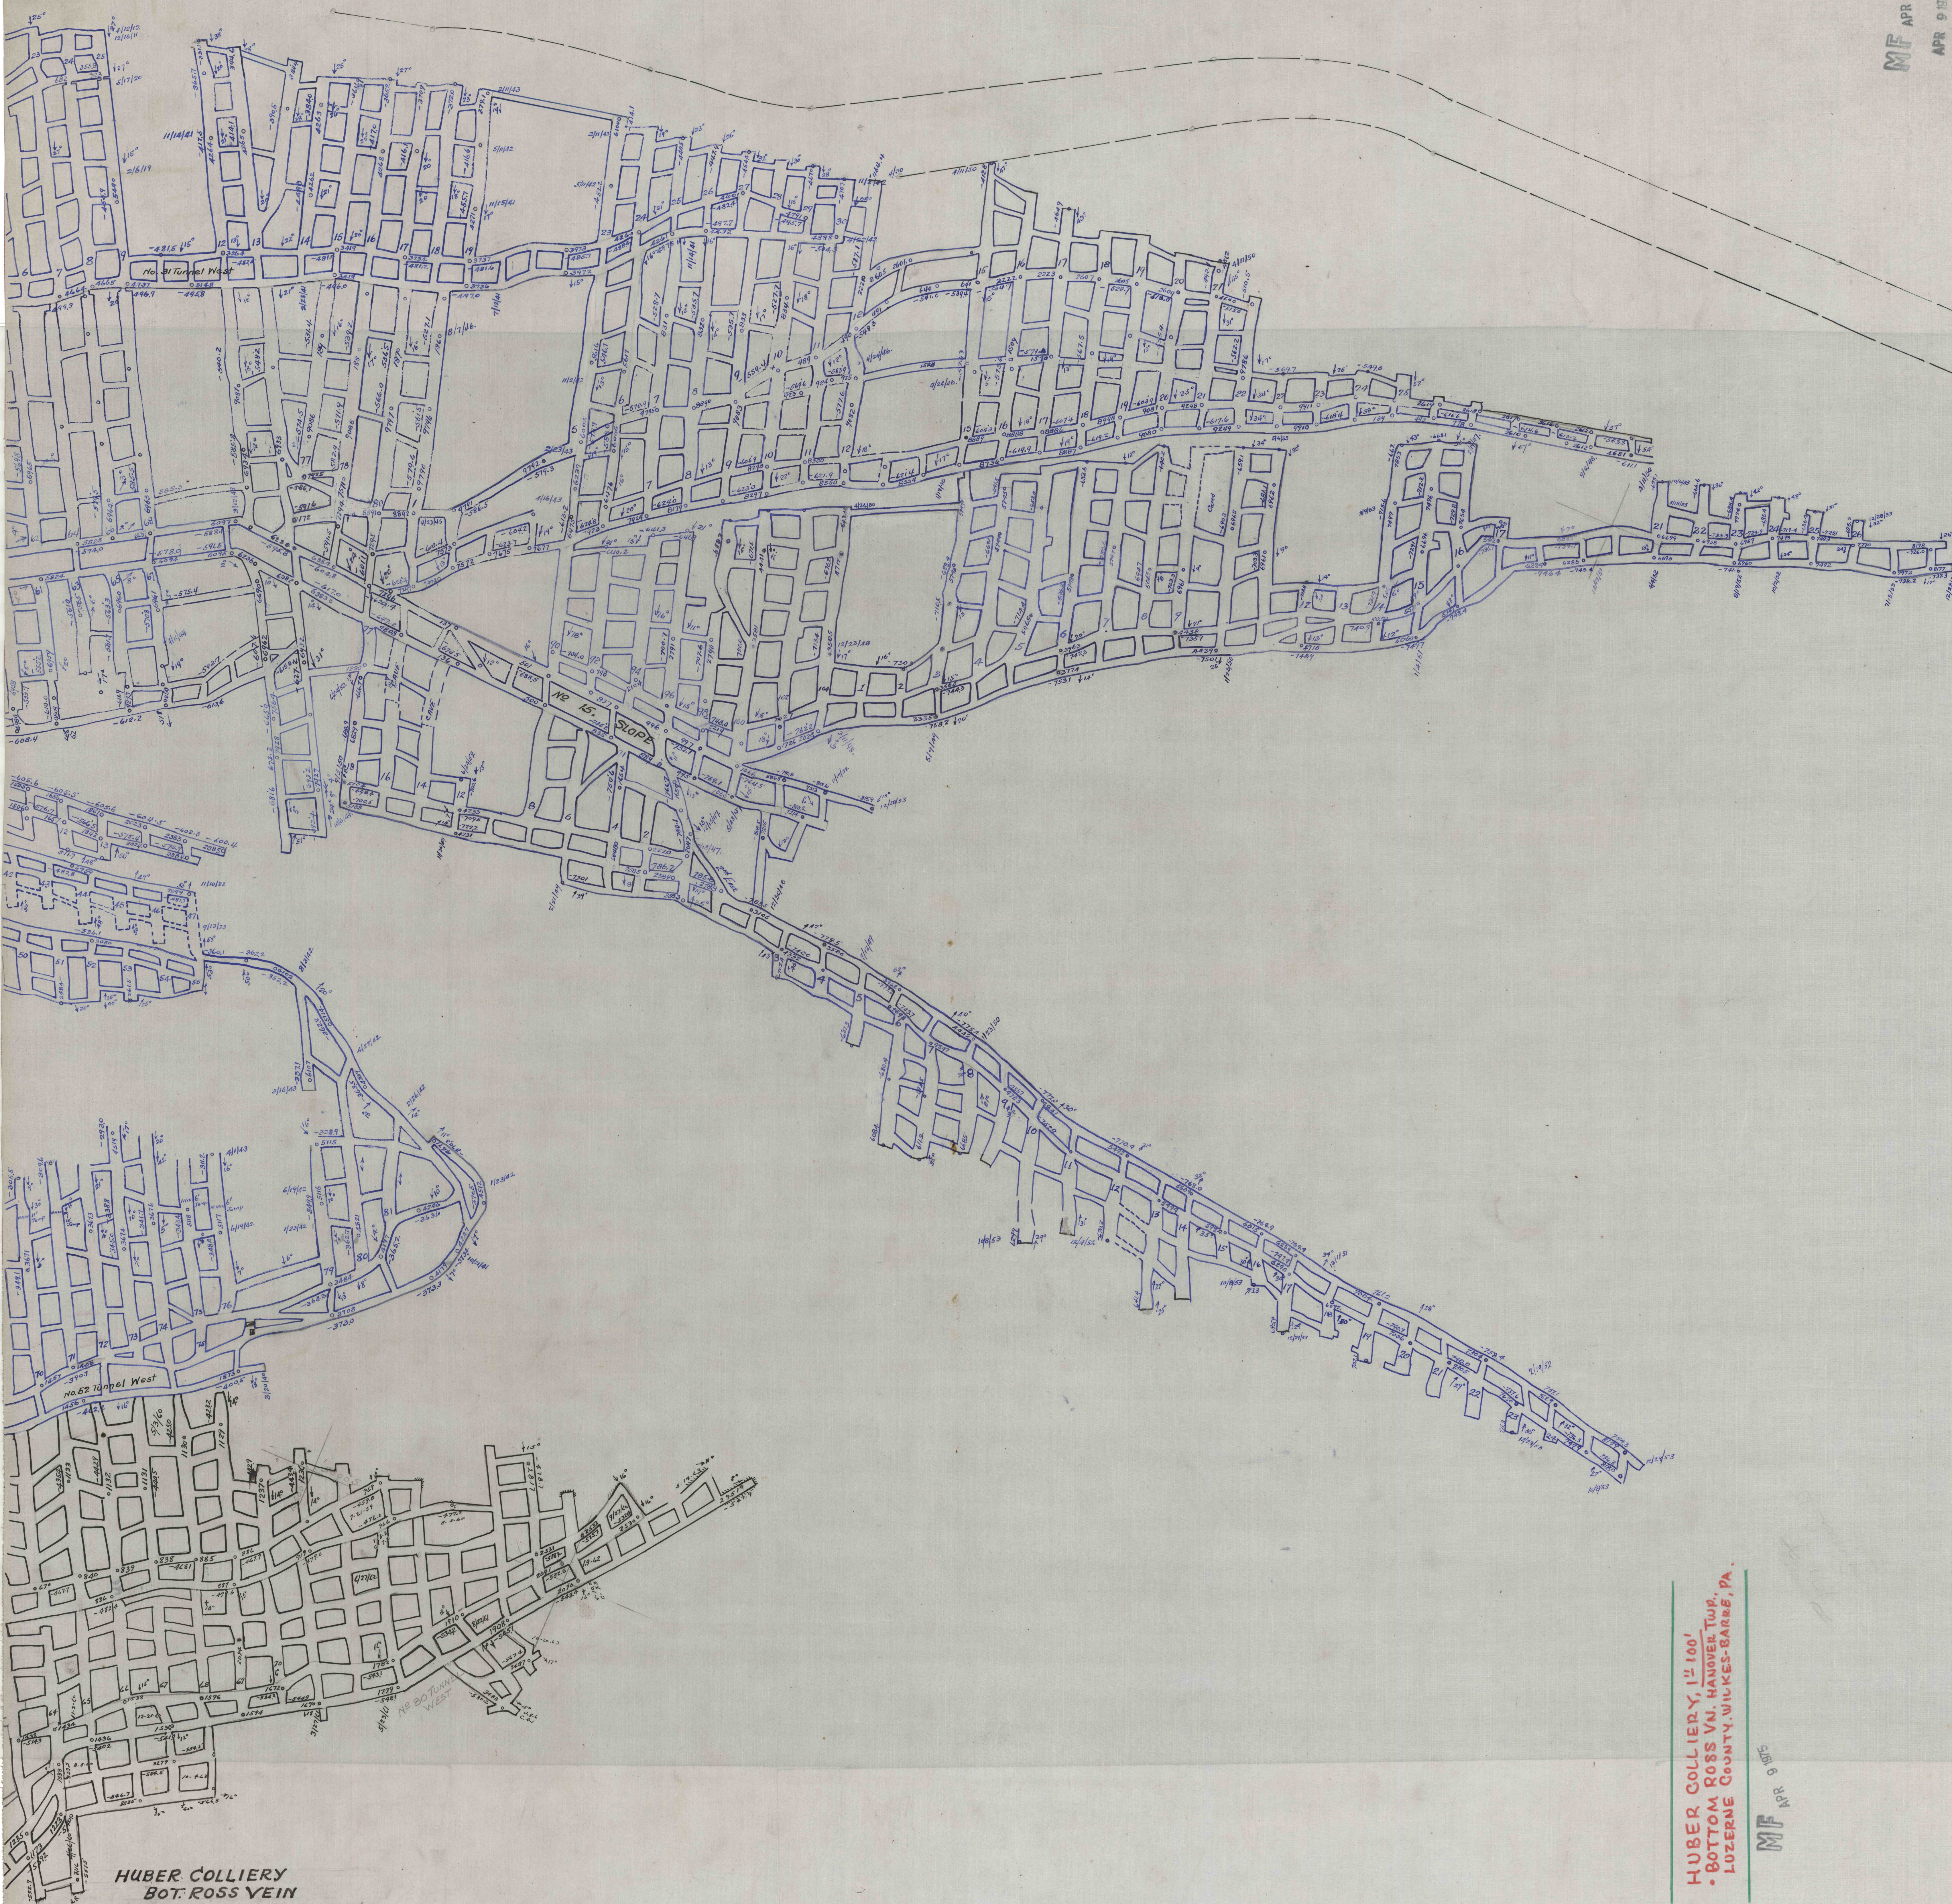

HUBER COLLIERY
BOT. ROSS VEIN

DATE EXTENDED	
December	1941
April	1942
March	1943
March	1945
July	1946
June	1947
Nov-30	1948
April	1949
February	1951
March	1952
March	1953
Dec	1954
Sept	1957
May	1958
March	1959
July	1960
April	1961
Jan	1962
April	1963
August	1964
November	1965
July	1966

Posted JAN - 1967
MAY - 1967
Nov-21-67

APR 9 1975
APR 9 1975
MF

HUBER COLLIERY, 11' 100'
- BOTTOM ROSS VN. HANOVER TWP.
- LUZERNE COUNTY, WILKES-BARRE, PA.

MF
APR 9 1975

No. 204

MINING ENGINEERING DEPT.
GLEN ALDEN COAL CO.
SOUTHERN DIVISION
WILKES-BARRE, PA.
1"=100'
V.A.U.L.T. NO. M.T. ROSS 20

APR 9 1975
APR 9 1975
MF