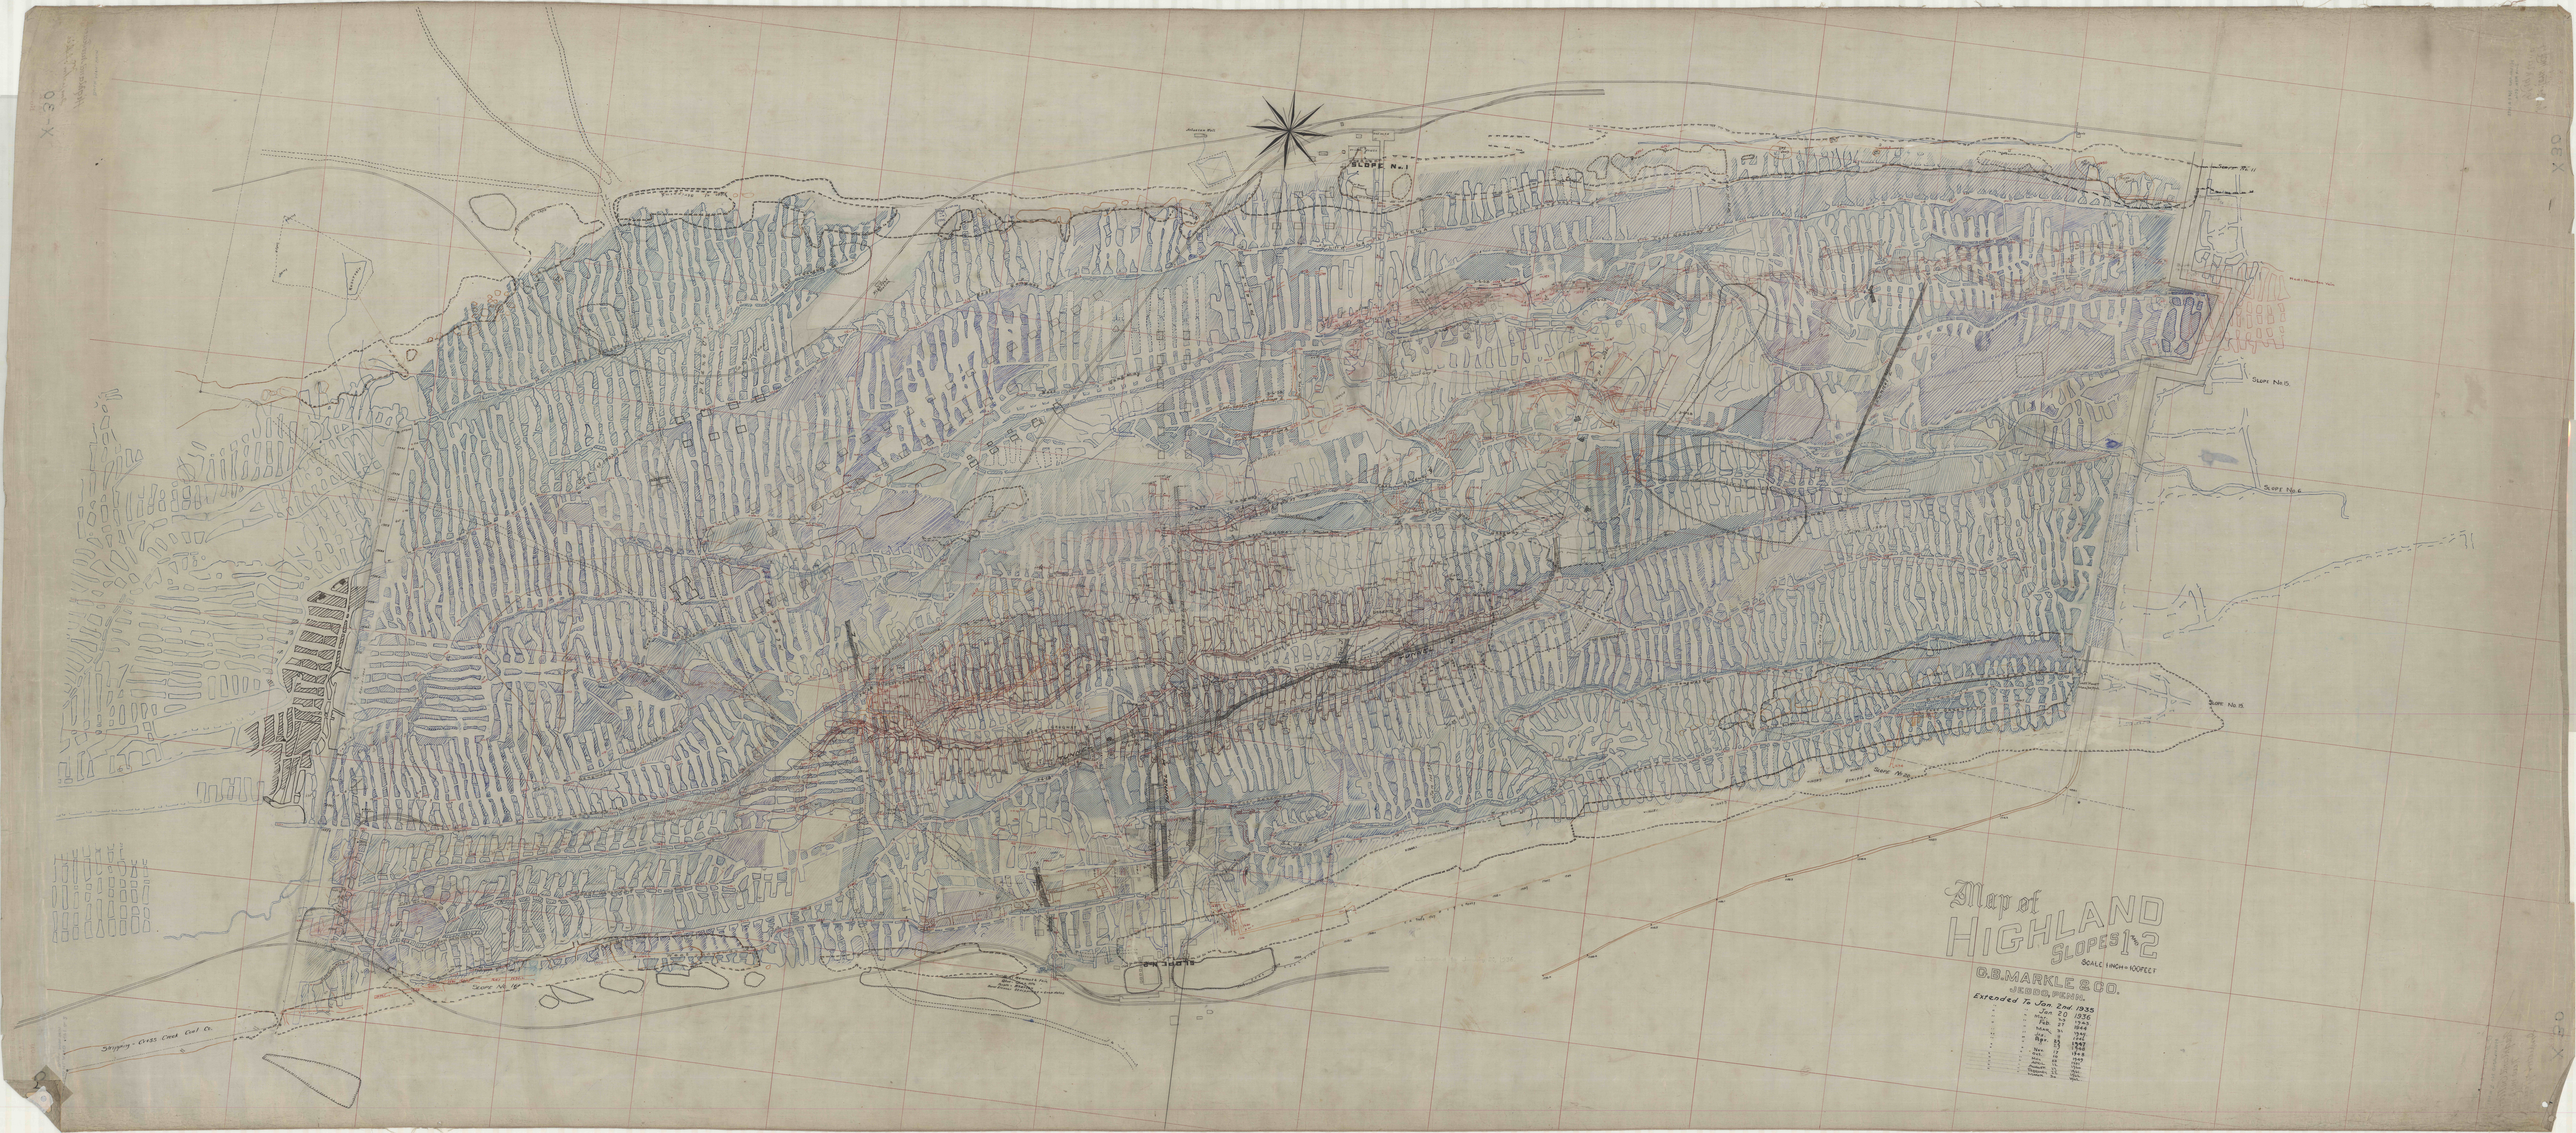
SLOPE No.1
Slope No. 11
Slope No.15
Slope No.6
Slope No.15
Slope No.16
Slope No.16
Stripping - Cross Cut Cal Co.
Map of
HIGHLAND
SLOPES 1 & 2
SCALE 1 INCH = 100 FEET
O.B. MARKLE & CO.
JEROME PARK.
Extended To Jan 2nd 1935
Jan 20 1936
Feb 27 1943
1944
1945
1946
1947
1948
1949
1950
1951
1952
1953
1954
1955
1956
1957