


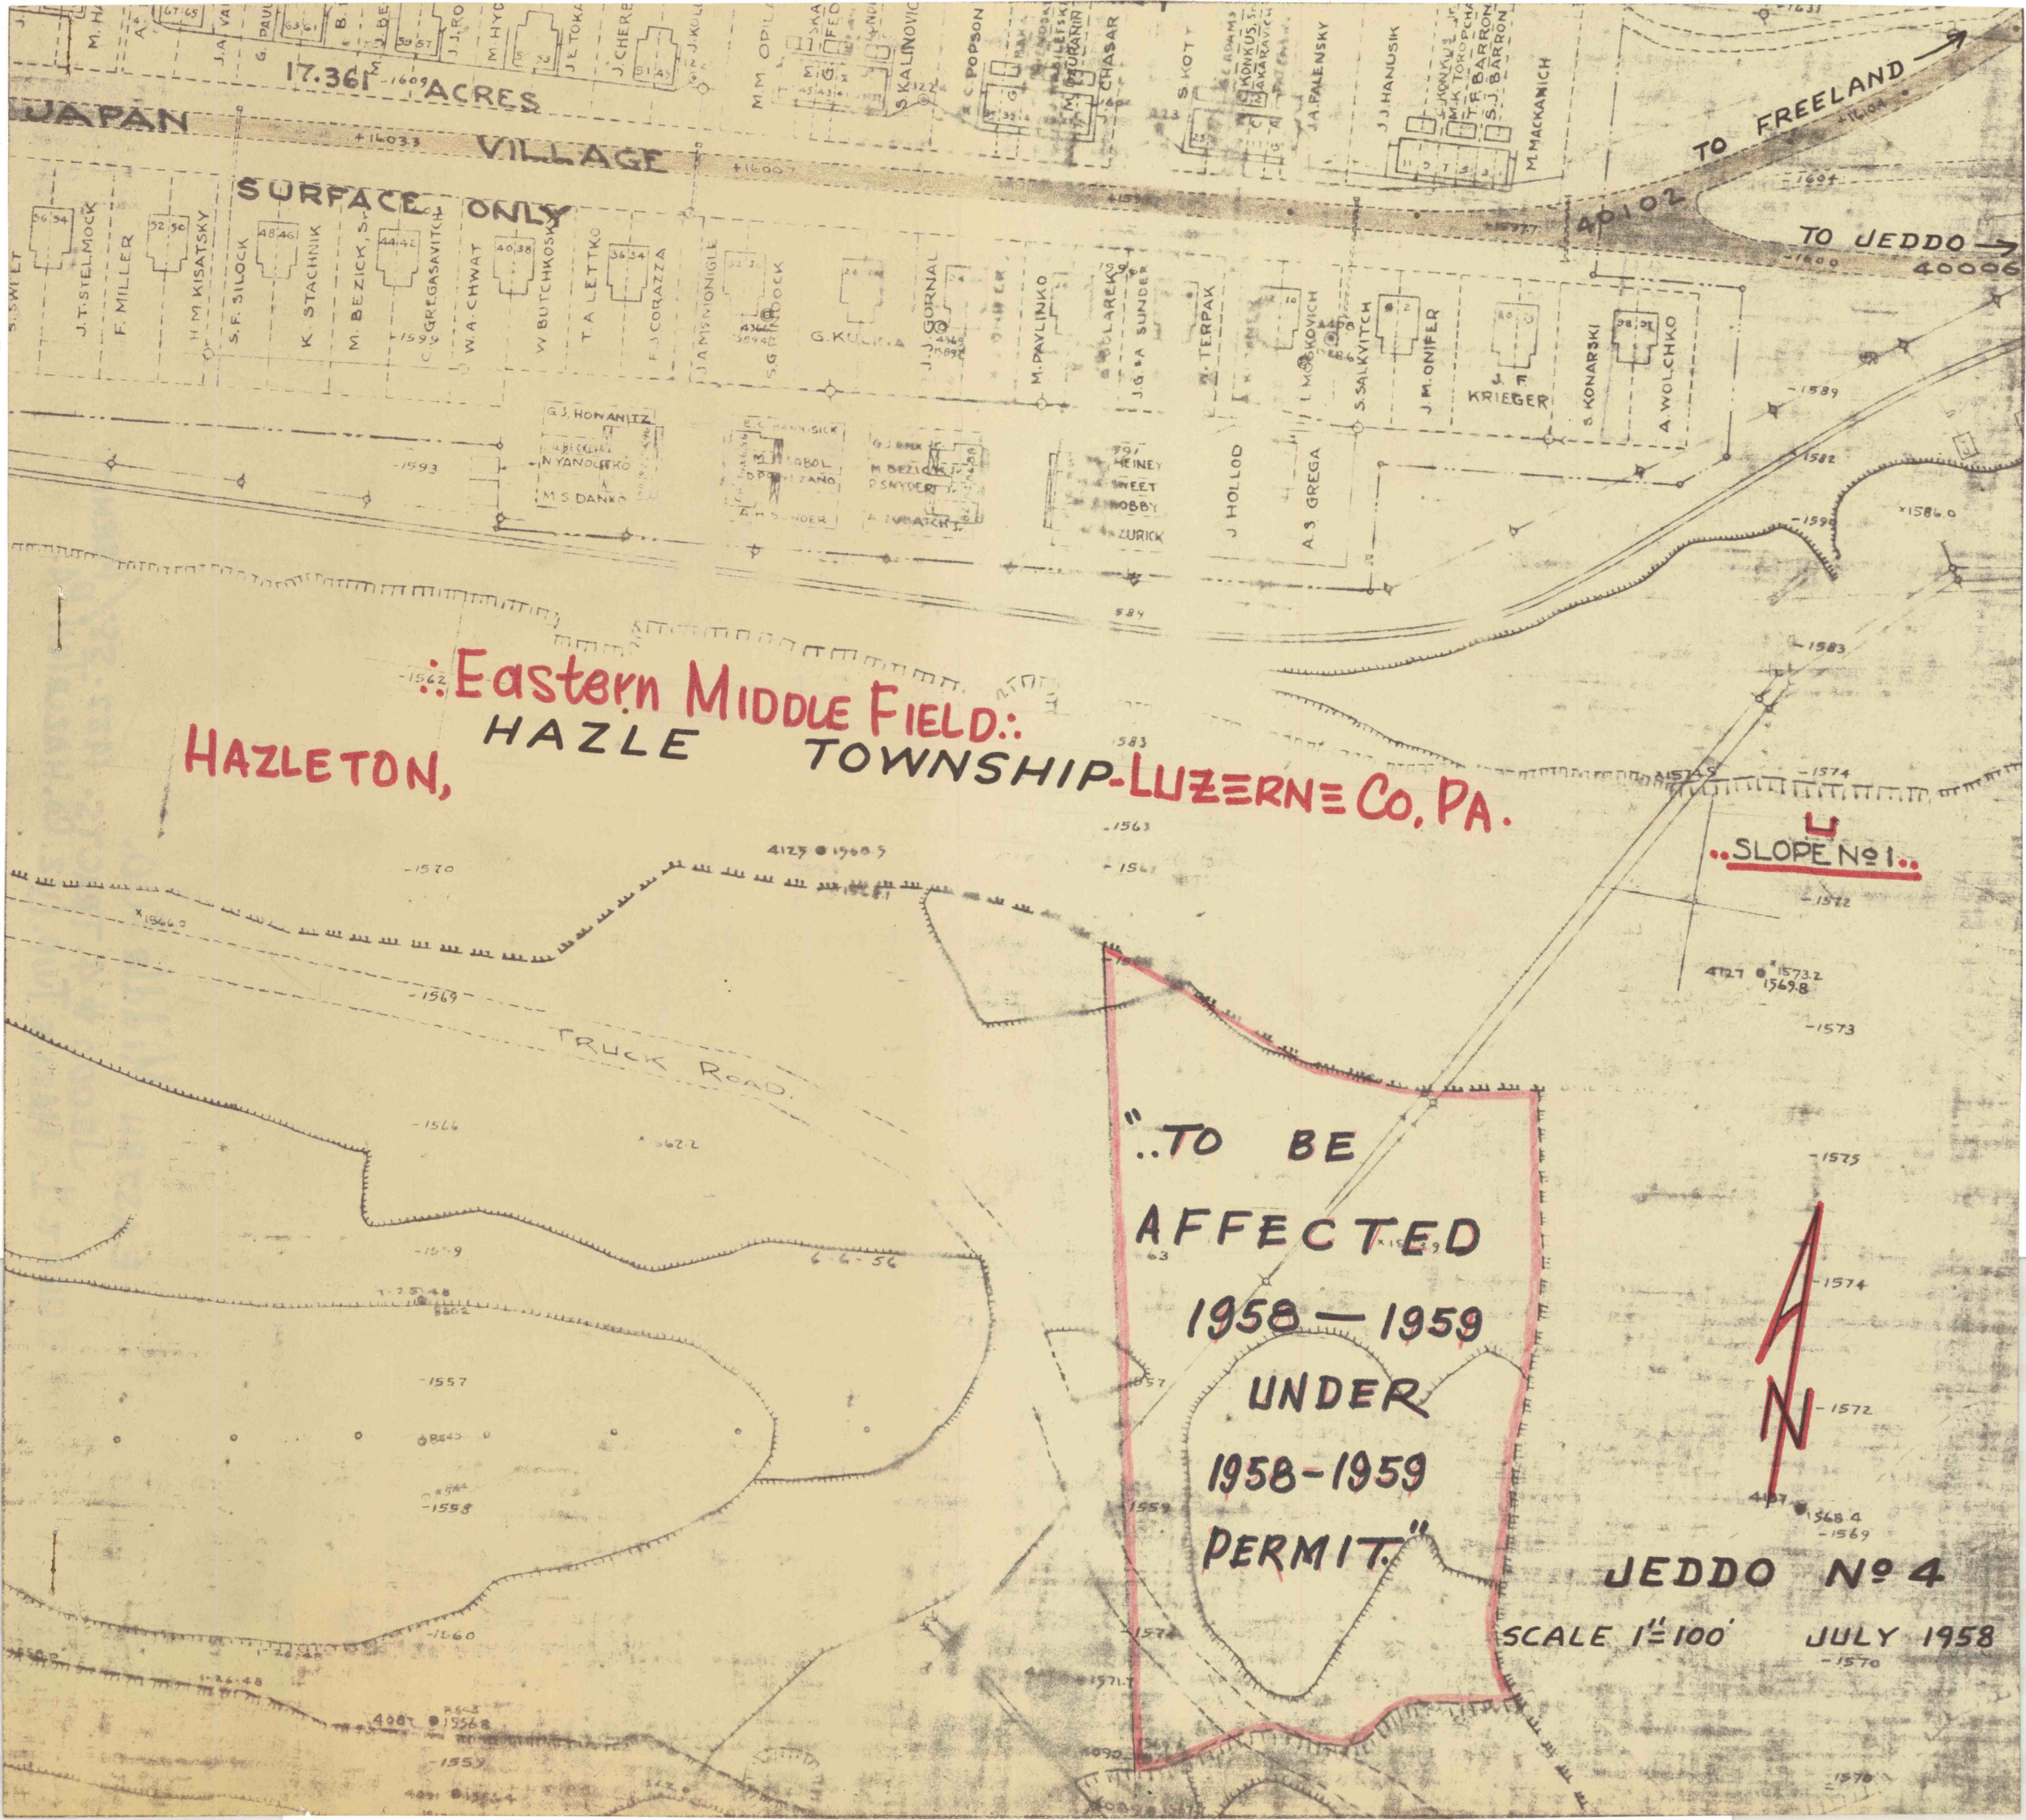

17.361 ACRES

JAPAN VILLAGE

SURFACE ONLY

TO FREELAND
TO JEDDO

HAZLETON, PA.
Eastern Middle Field:
HAZLE TOWNSHIP - LUZERNE CO., PA.

SLOPE No 1

TO BE
AFFECTED
1958 - 1959
UNDER
1958-1959
PERMIT.

JEDDO No 4
SCALE 1"=100'
JULY 1958