


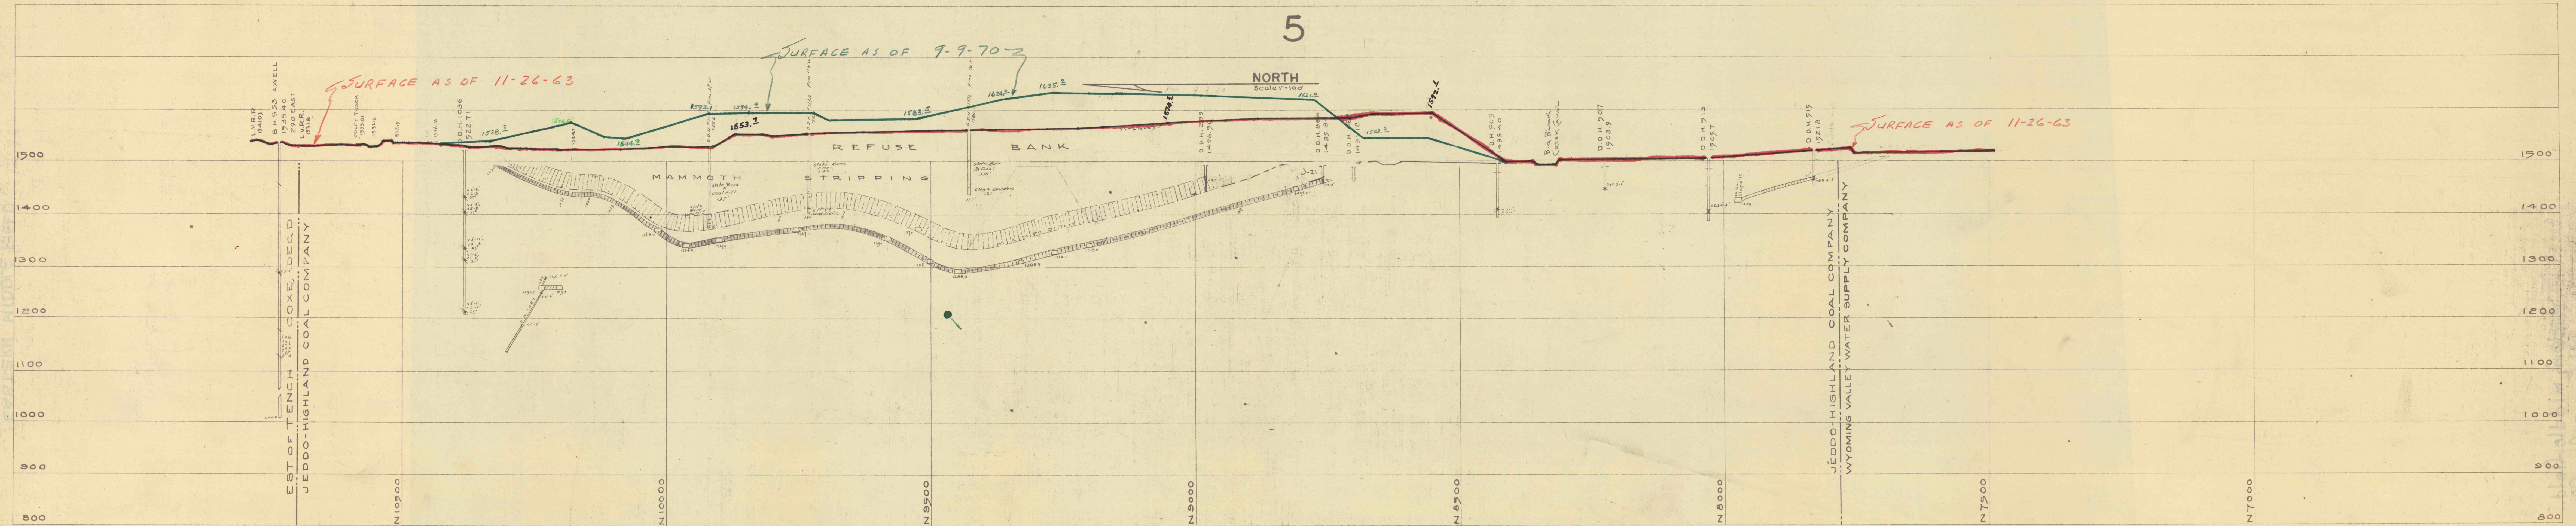

EASTERN MIDDLE FIELD.. 1"=100'. JEDDO-HIGHLAND COAL CO.
"X"=SECTIONS NO'S 5 & 6= LUZERNE COUNTY, PA. BLACK CREEK District.

..2 of 2..

HARLEIGH