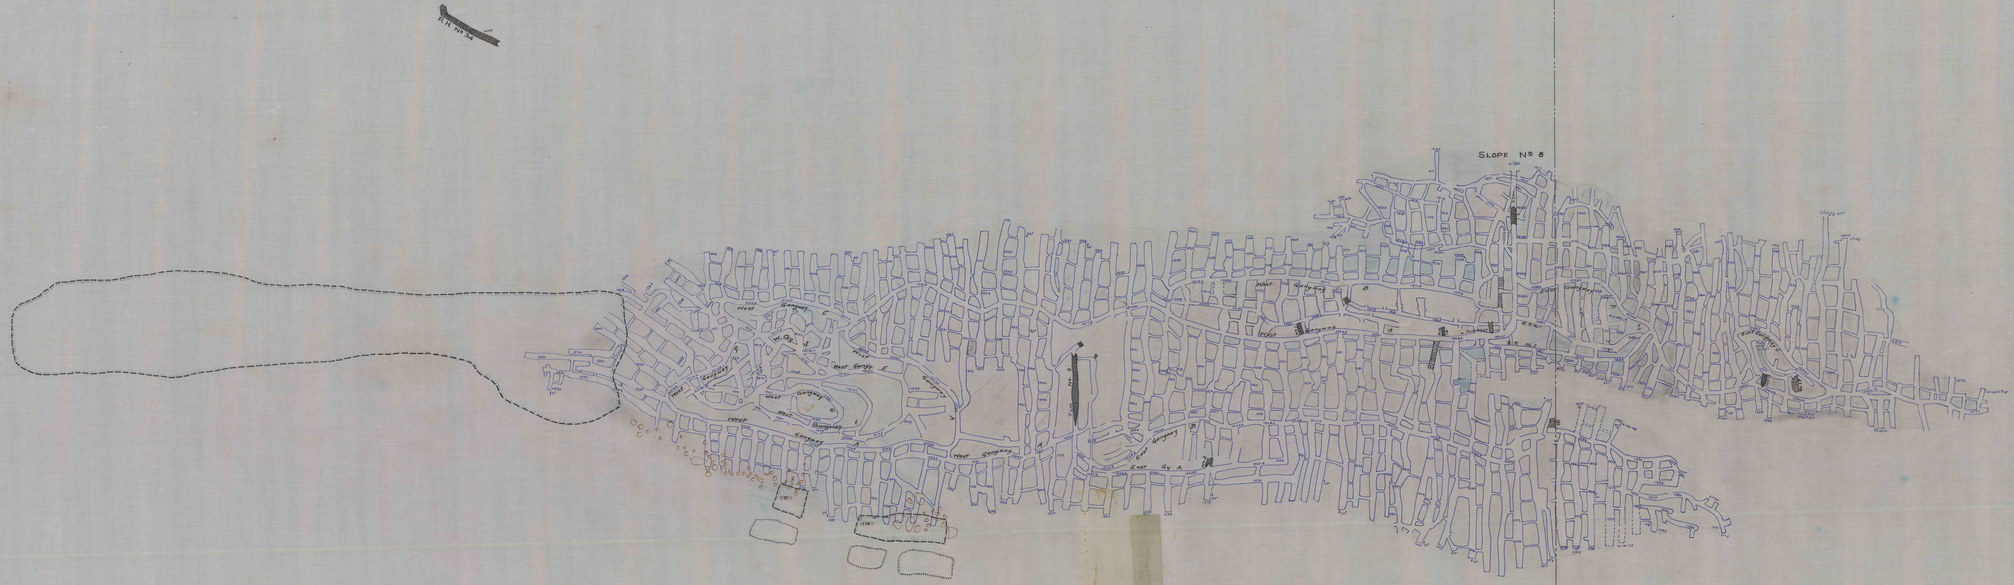

Extended To Jan. 2nd. 1935
" " Jan. 20 1936
" " " 11 1938
" " June 12 1940

Extended To April 22 1947
" " " 23 1948
" " Nov. 17 1948
" " Oct. 10 1949
" " May 28 1951

Map of No. 8 Vein

HIGHLAND No. 5 COLLIERY.

JEDDO-HIGHLAND COAL CO.

Scale 1" = 100'