


Wine Inspection Office
 Rock Hole No. 14 Wharton Vein
 70000-110000-0001 00

Rock Hole No. 14
 Wharton Vein

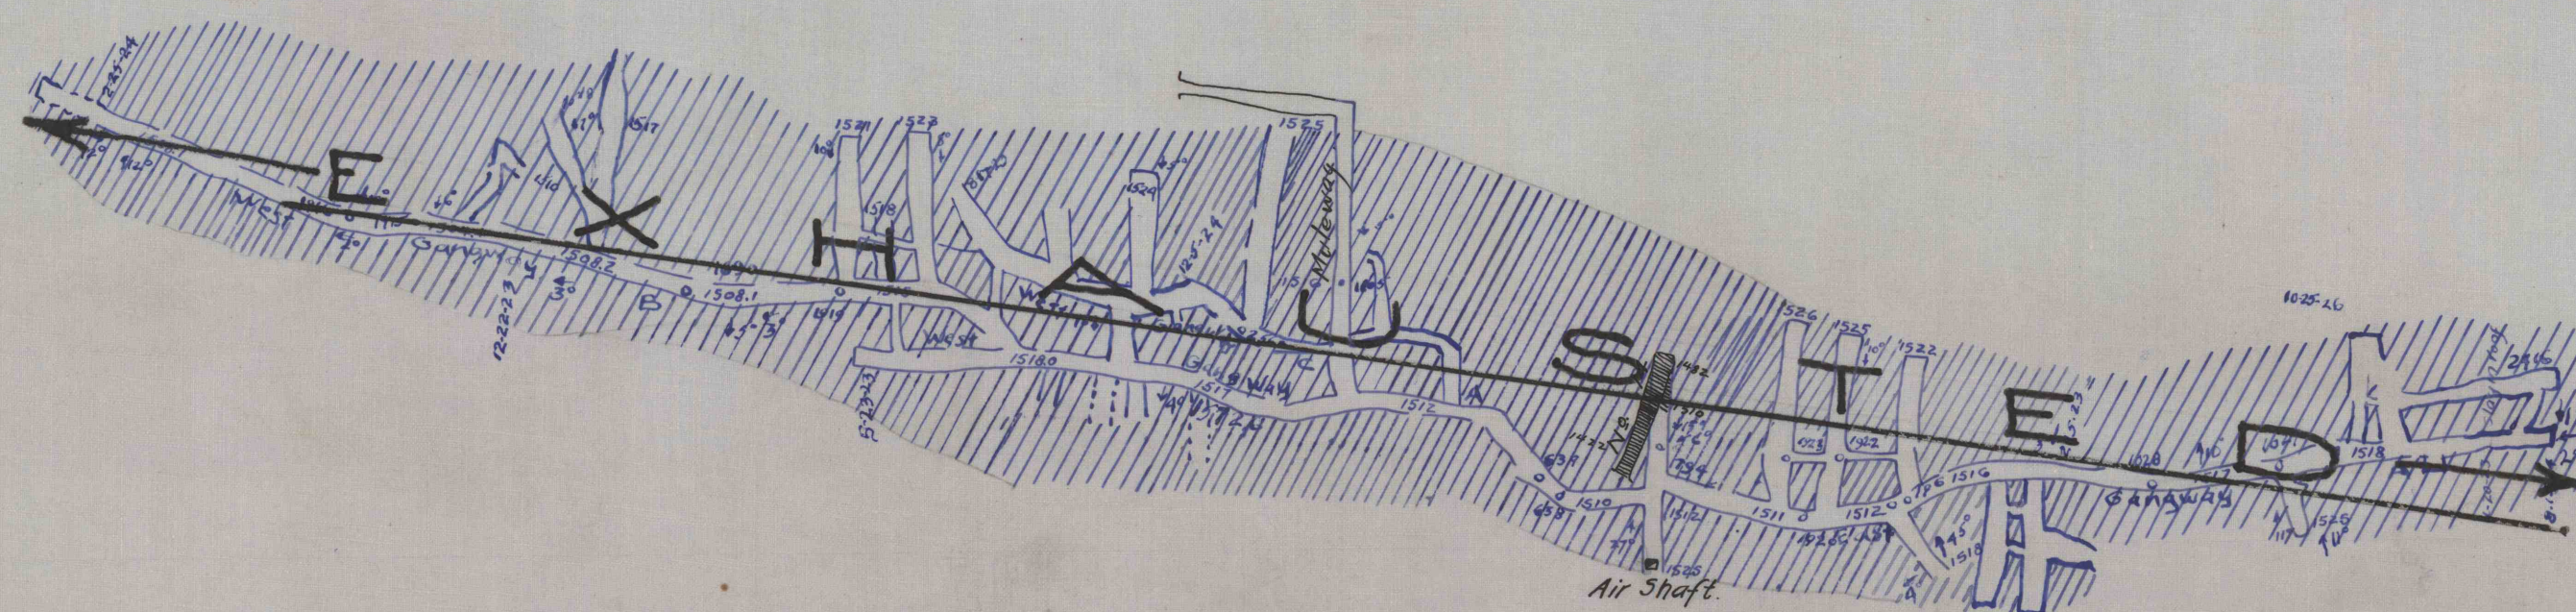

Extended To	Jan. 2nd. 1935
"	" Jan. 20 1936
"	" " 11 1938
"	" JUNE 12 1940.
Extended To	EXHAUSTED April 27 1947
"	" " 23 1948
"	" Nov. 17 1948
"	" Oct. 10 1949
"	" May 28 1951

ROCK HOLE N° 14
 WHARTON VEIN
 Scale 1"=100'

Rock Hole No. 14
 Wharton Vein