


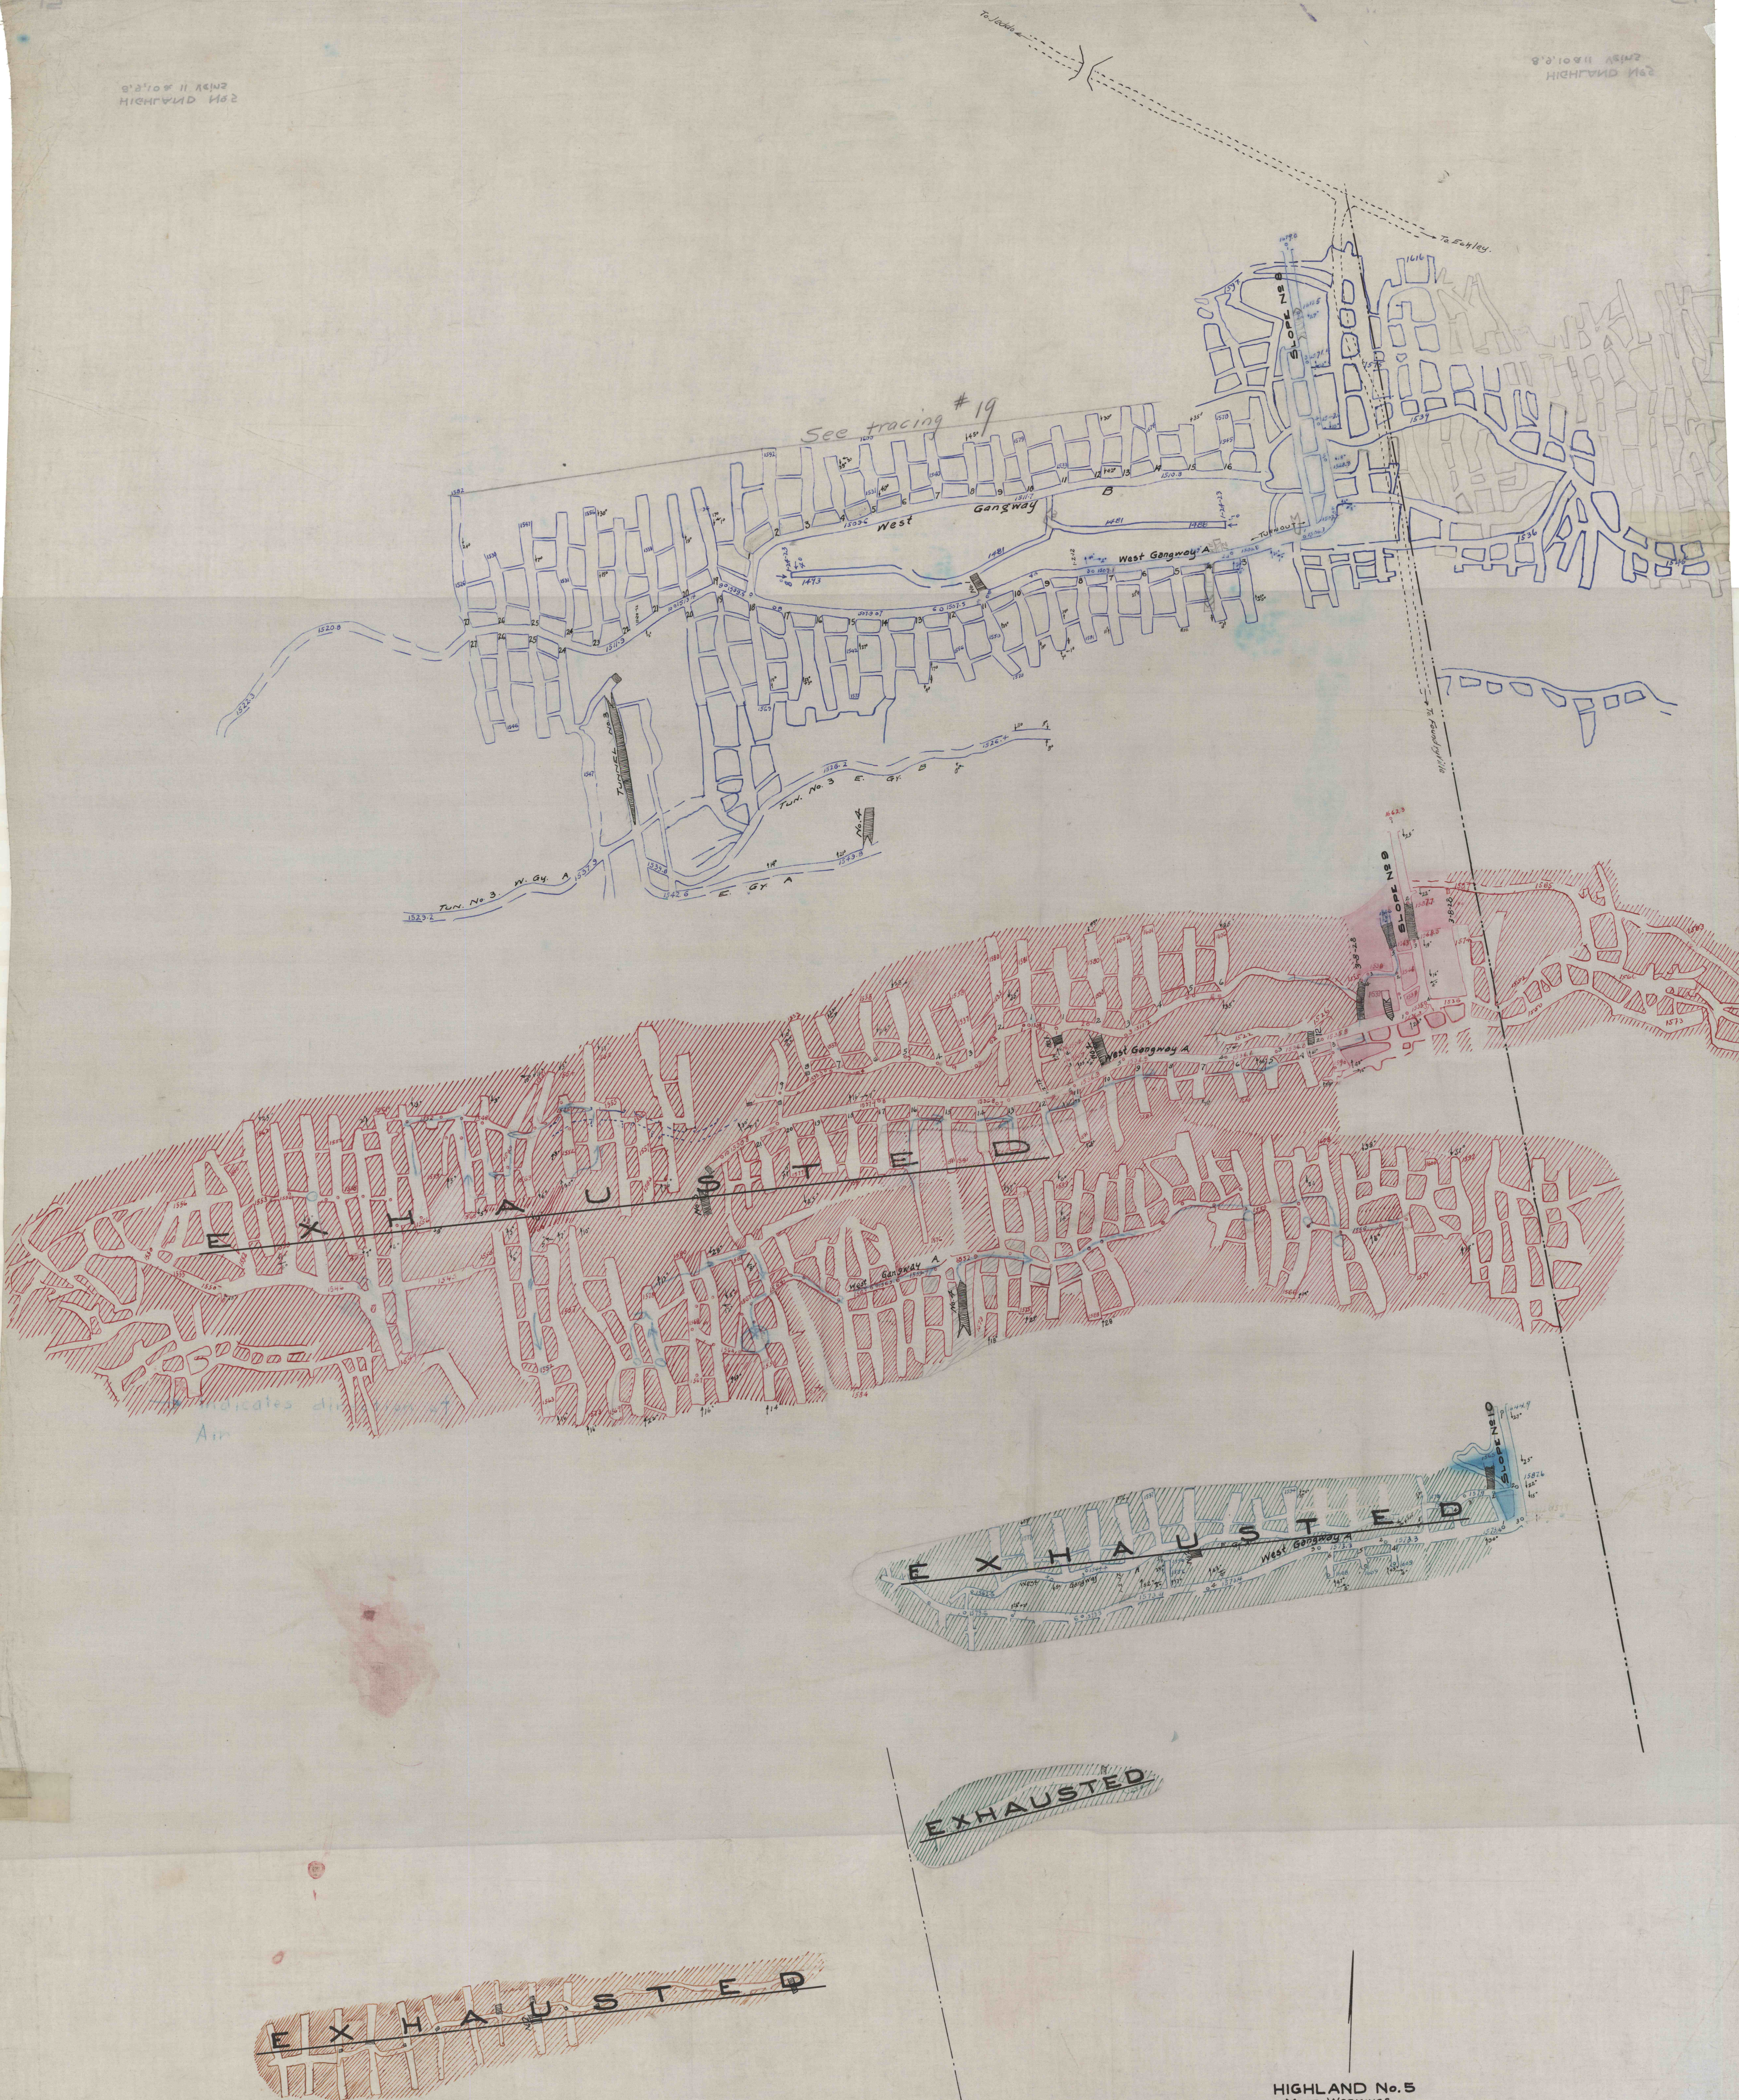

Extended To Jan. 2nd. 1935			
"	"	Jan. 20	1936
"	"	"	11 1938
"	"	JUNE 12	1940.
EXHAUSTED			
Extended To April	25	1947	
"	"	23	1948
"	"	Nov 17.	1948
"	"	Oct 10	1948
"	"	May 28	1951

HIGHLAND No. 2
MINE WORKINGS
SLOPES No. 8, 9, & 10
G.B. Markle Co.