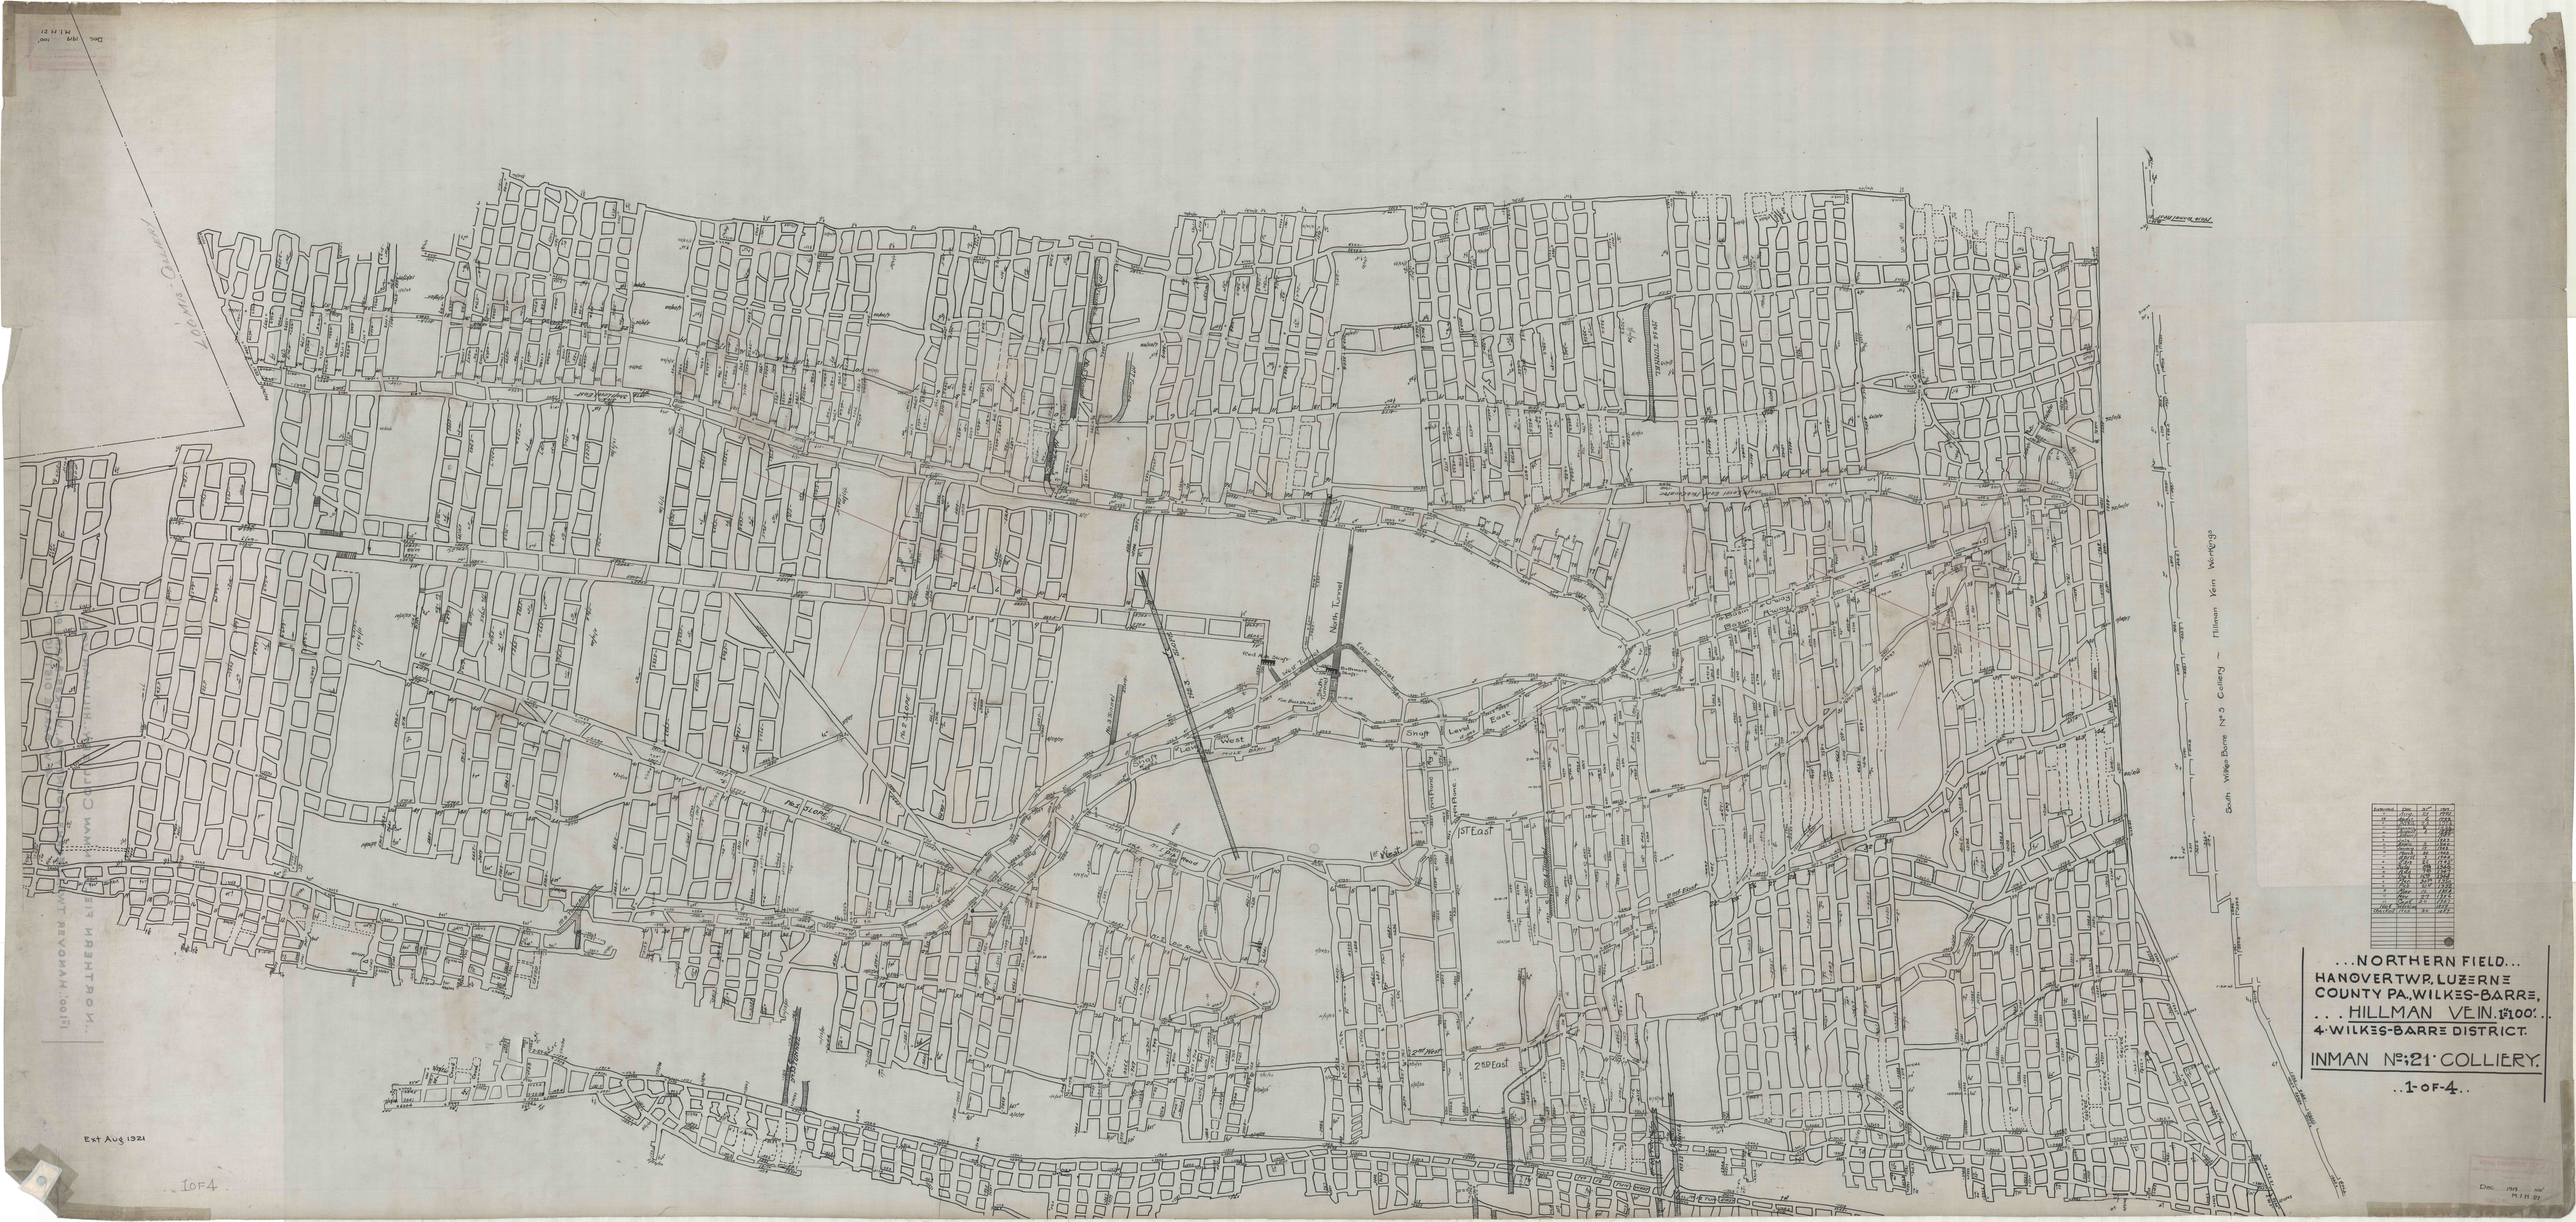
...NORTHERN FIELD...
HANOVER TWP, LUZERNE
COUNTY PA, WILKES-BARRE,
...HILLMAN VEIN 13100'...
4 WILKES-BARRE DISTRICT.
INMAN No 21 COLLIERY.
..1 OF 4..
Ext Aug 1921
1 OF 4
North Tunnel
Shaft
Level
East
West
1st East
2nd East
1st West
South Wilkes-Barre No 5 Colliery ~ Hillman Vein Workings