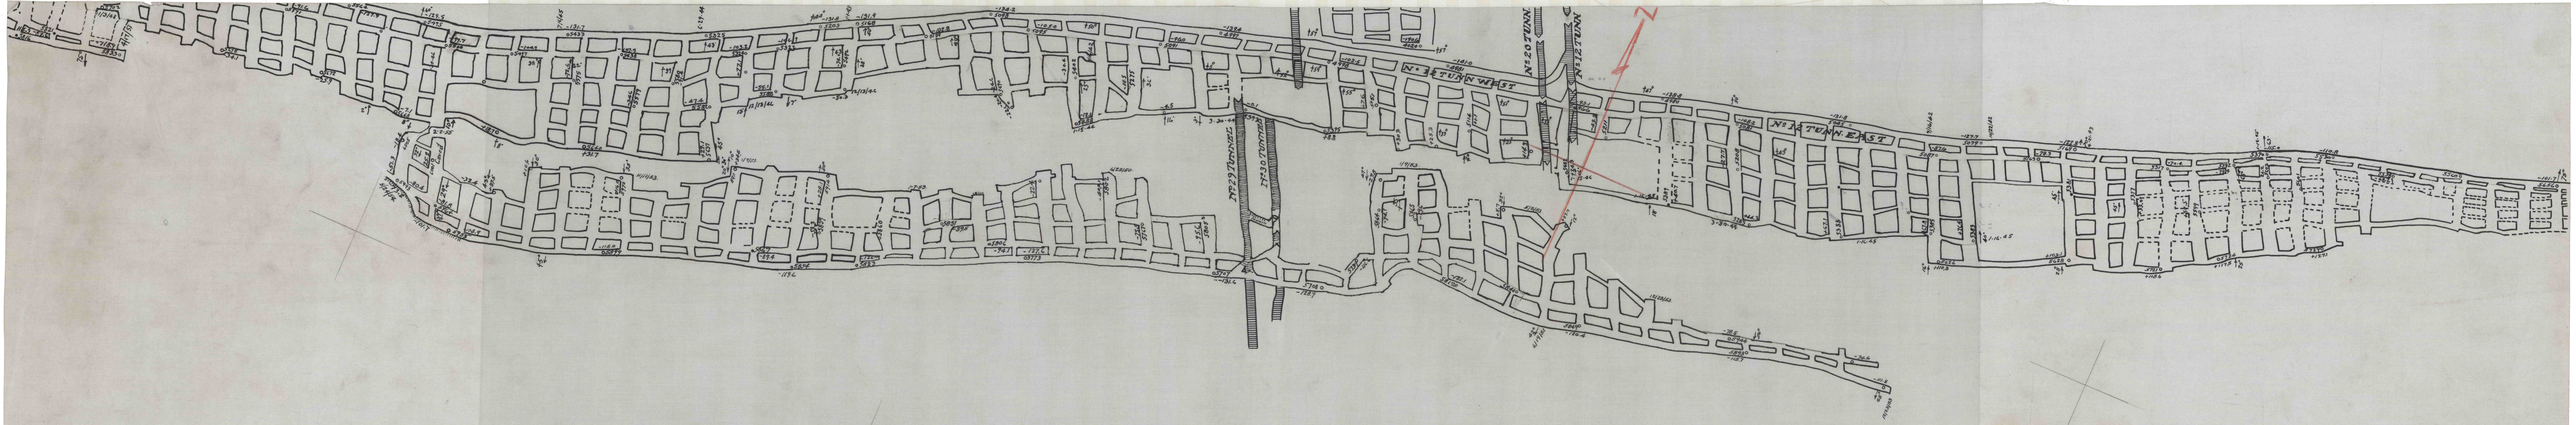

Extended	April	3	1944
"	July	26	1948
"	July	29	1964
"	Aug.	7th	1949
"	Sept.	18th	1949
"	Nov.	30th	1950
"	Feb.	21st	1957
"	Mar.	25	1958
"	June	27	1958
"	June	26	1959
1956	Various		1957
Checked	Nov.	30	1957

NORTHERN FIELD.. HANOVER TOWNSHIP, LUZERNE COUNTY,

4-WILKES-BARRE, PA., DISTRICT. ..1"=100'.. HILLMAN VEIN

..4-OF-4. ..INMAN COLLIERY.

..4 OF 4.