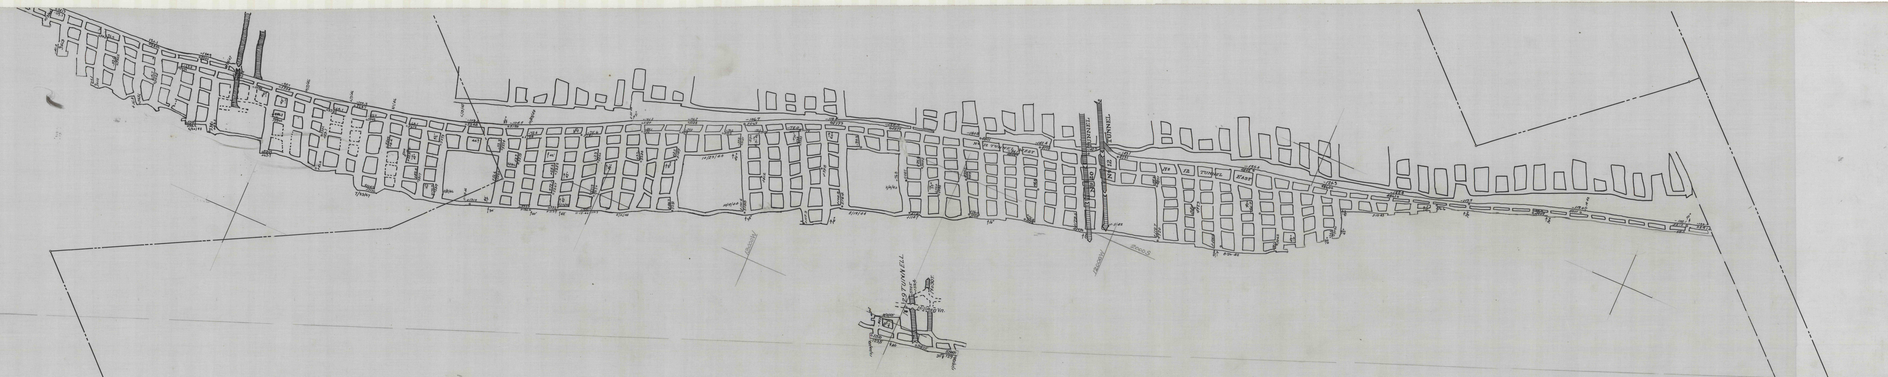

Extended

..3 OF 3..

..Northern FIELD...

INMAN COLLIERY

..KIDNEY VEIN..

..SCALE: 1"=100'..

HANOVER TWP. Luzerne County Pa., WILKES-BARRE,

4-WILKES-BARRE DISTRICT.