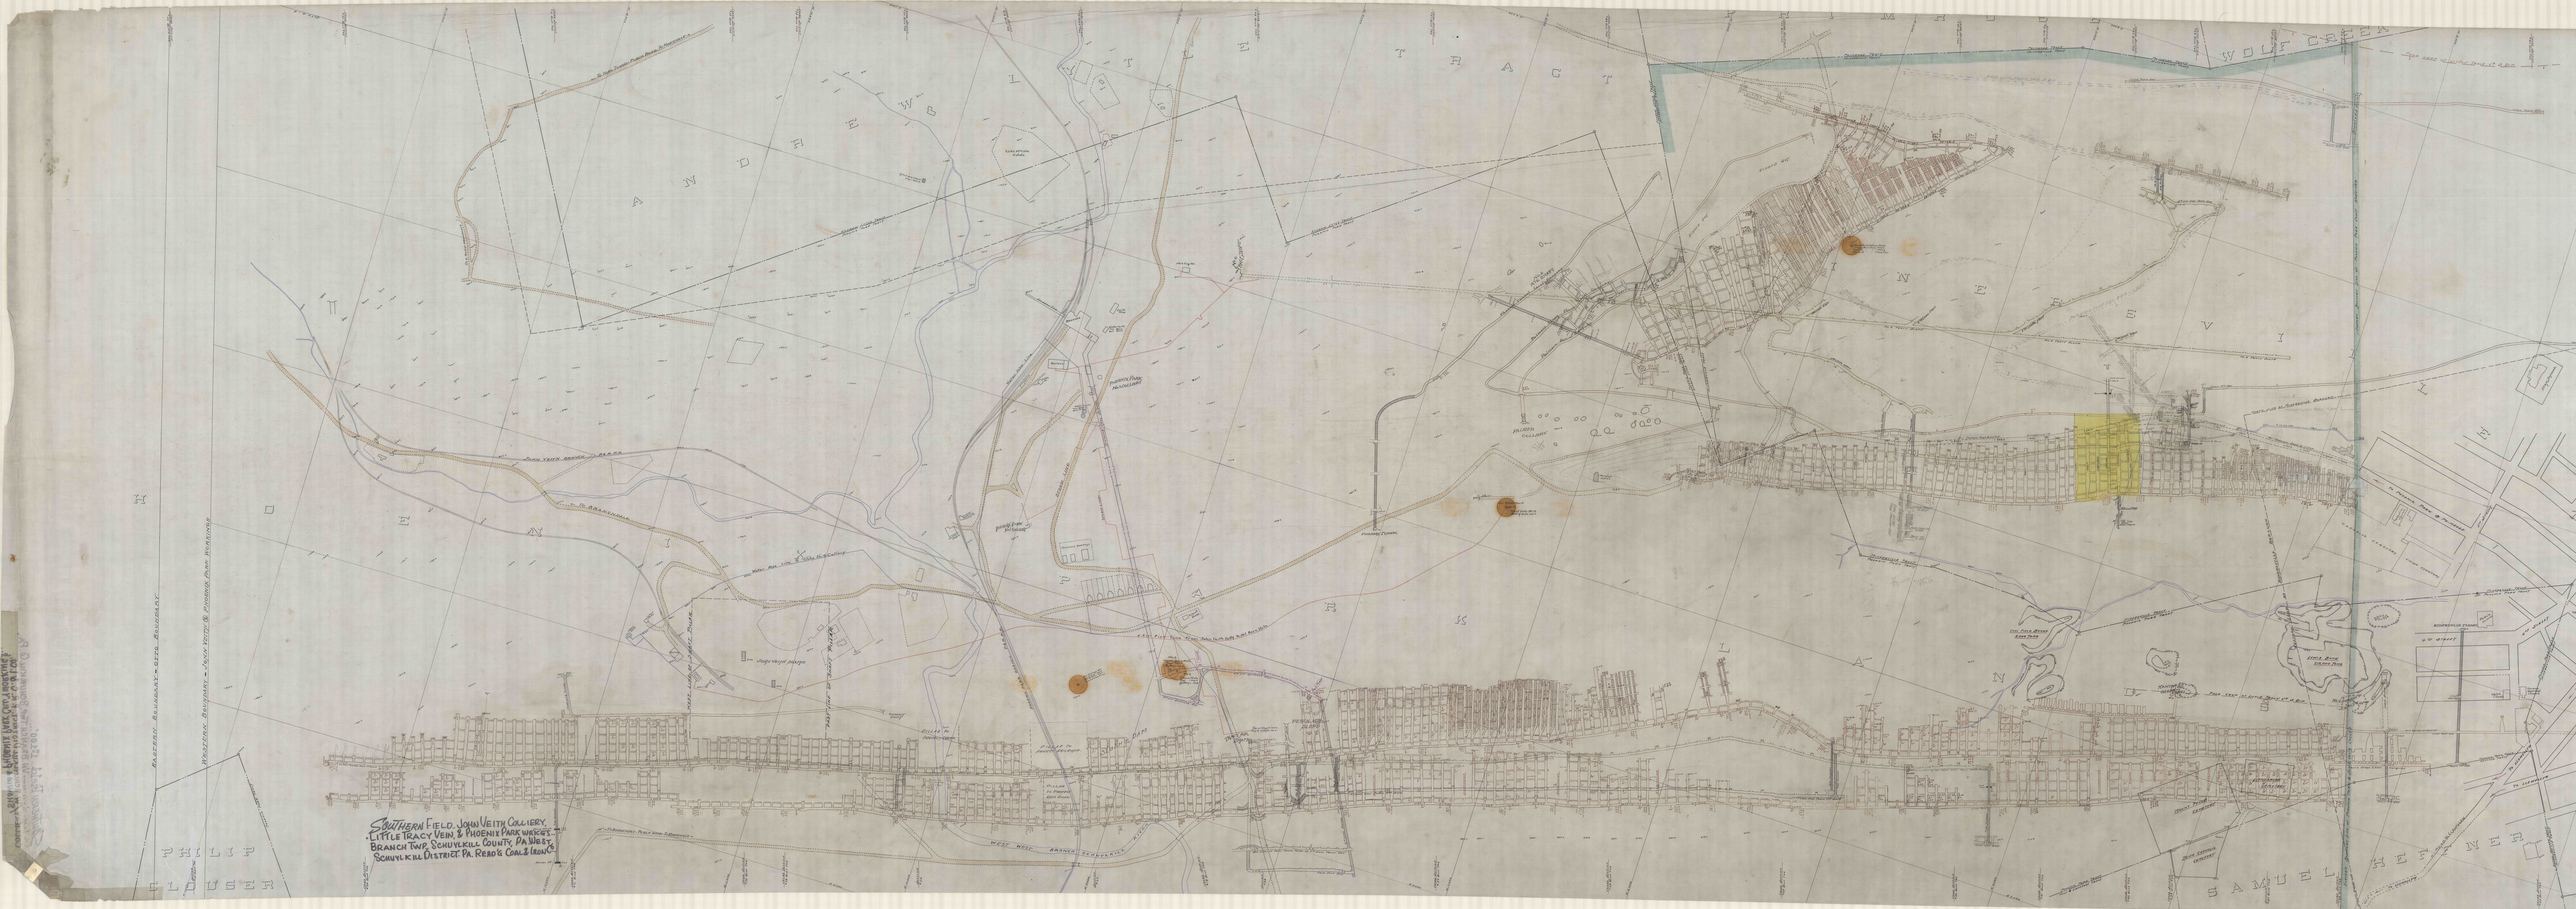

Southern Field, John Veith Colliery,
Little Tracy Vein & Phoenix Park Workings
Branch Twp. Schuylkill County, Pa. West
Schuylkill District. Pa. Read & Coal & Iron Co.
PHILIP
KLOUSER
SAMUEL
HEFFNER
WOLF CREEK
PHOENIX PARK
