


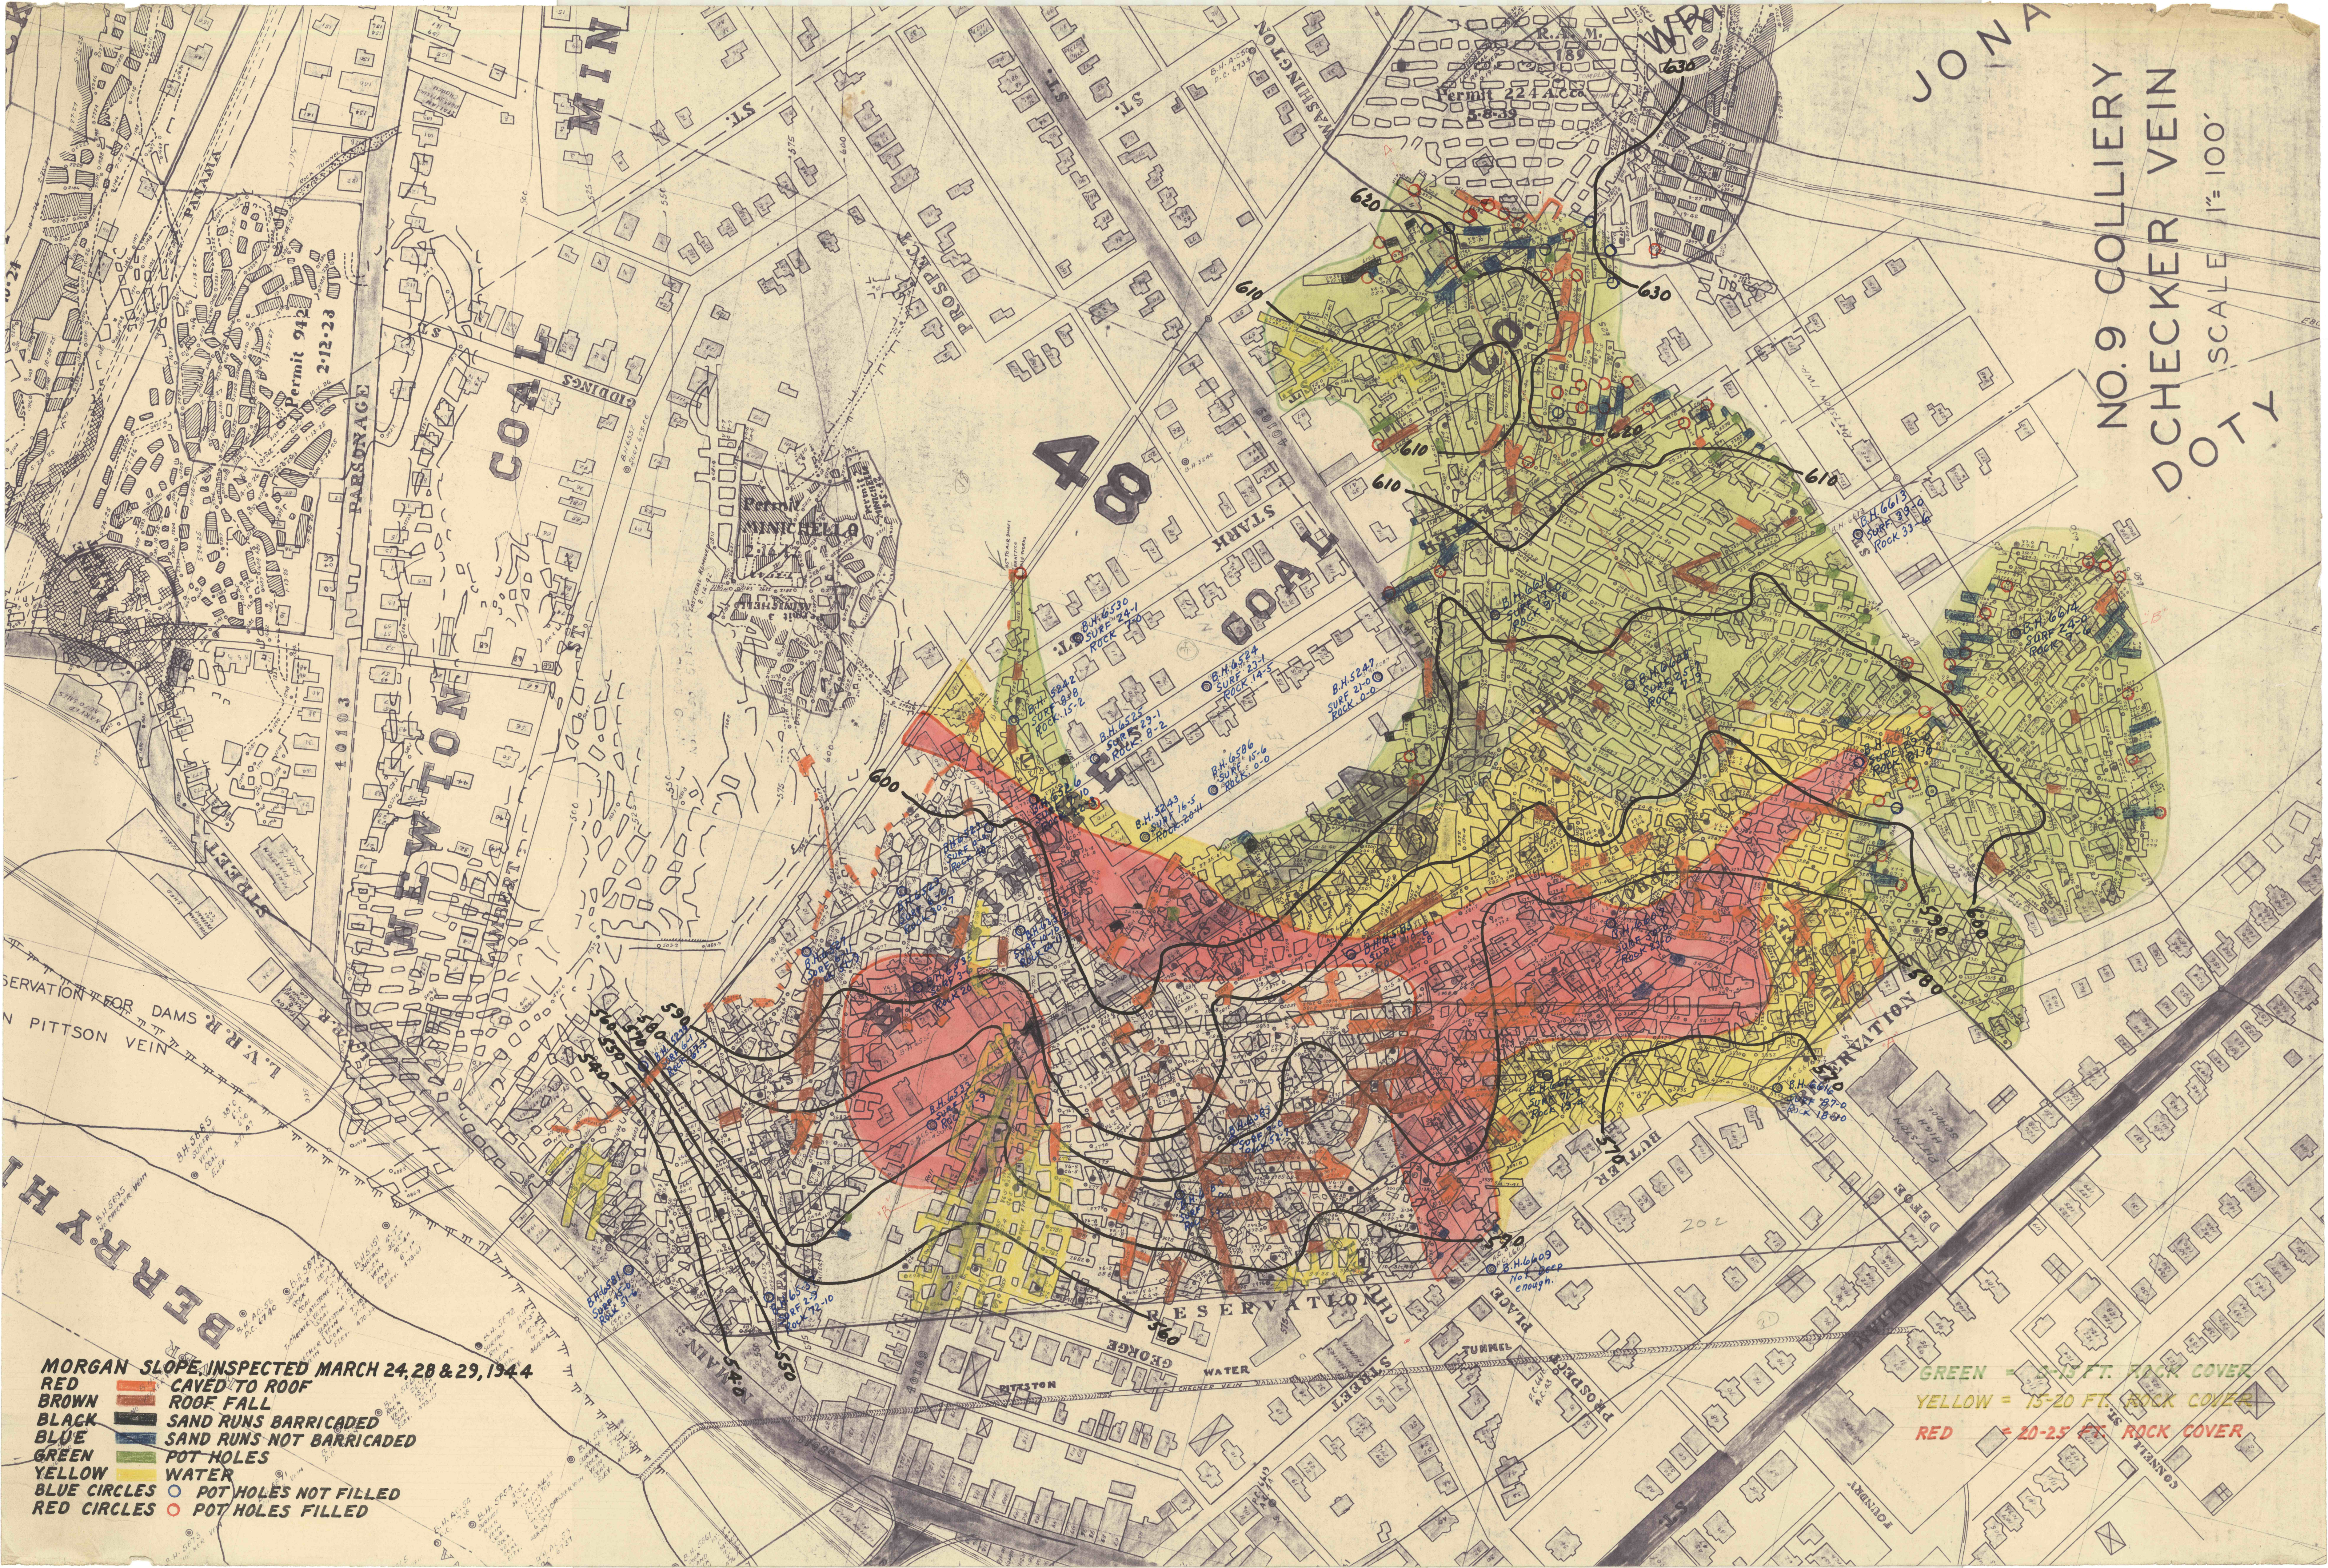

JON A

NO. 9 COLLIERY
DCHECKER VEIN
DOT Y
SCALE 1"=100'

MORGAN SLOPE INSPECTED MARCH 24, 28 & 29, 1944

RED CAVED TO ROOF
BROWN ROOF FALL
BLACK SAND RUNS BARRICADED
BLUE SAND RUNS NOT BARRICADED
GREEN POT HOLES
YELLOW WATER
BLUE CIRCLES POT HOLES NOT FILLED
RED CIRCLES POT HOLES FILLED

GREEN = 5-10 FT. ROCK COVER
YELLOW = 15-20 FT. ROCK COVER
RED = 20-25 FT. ROCK COVER