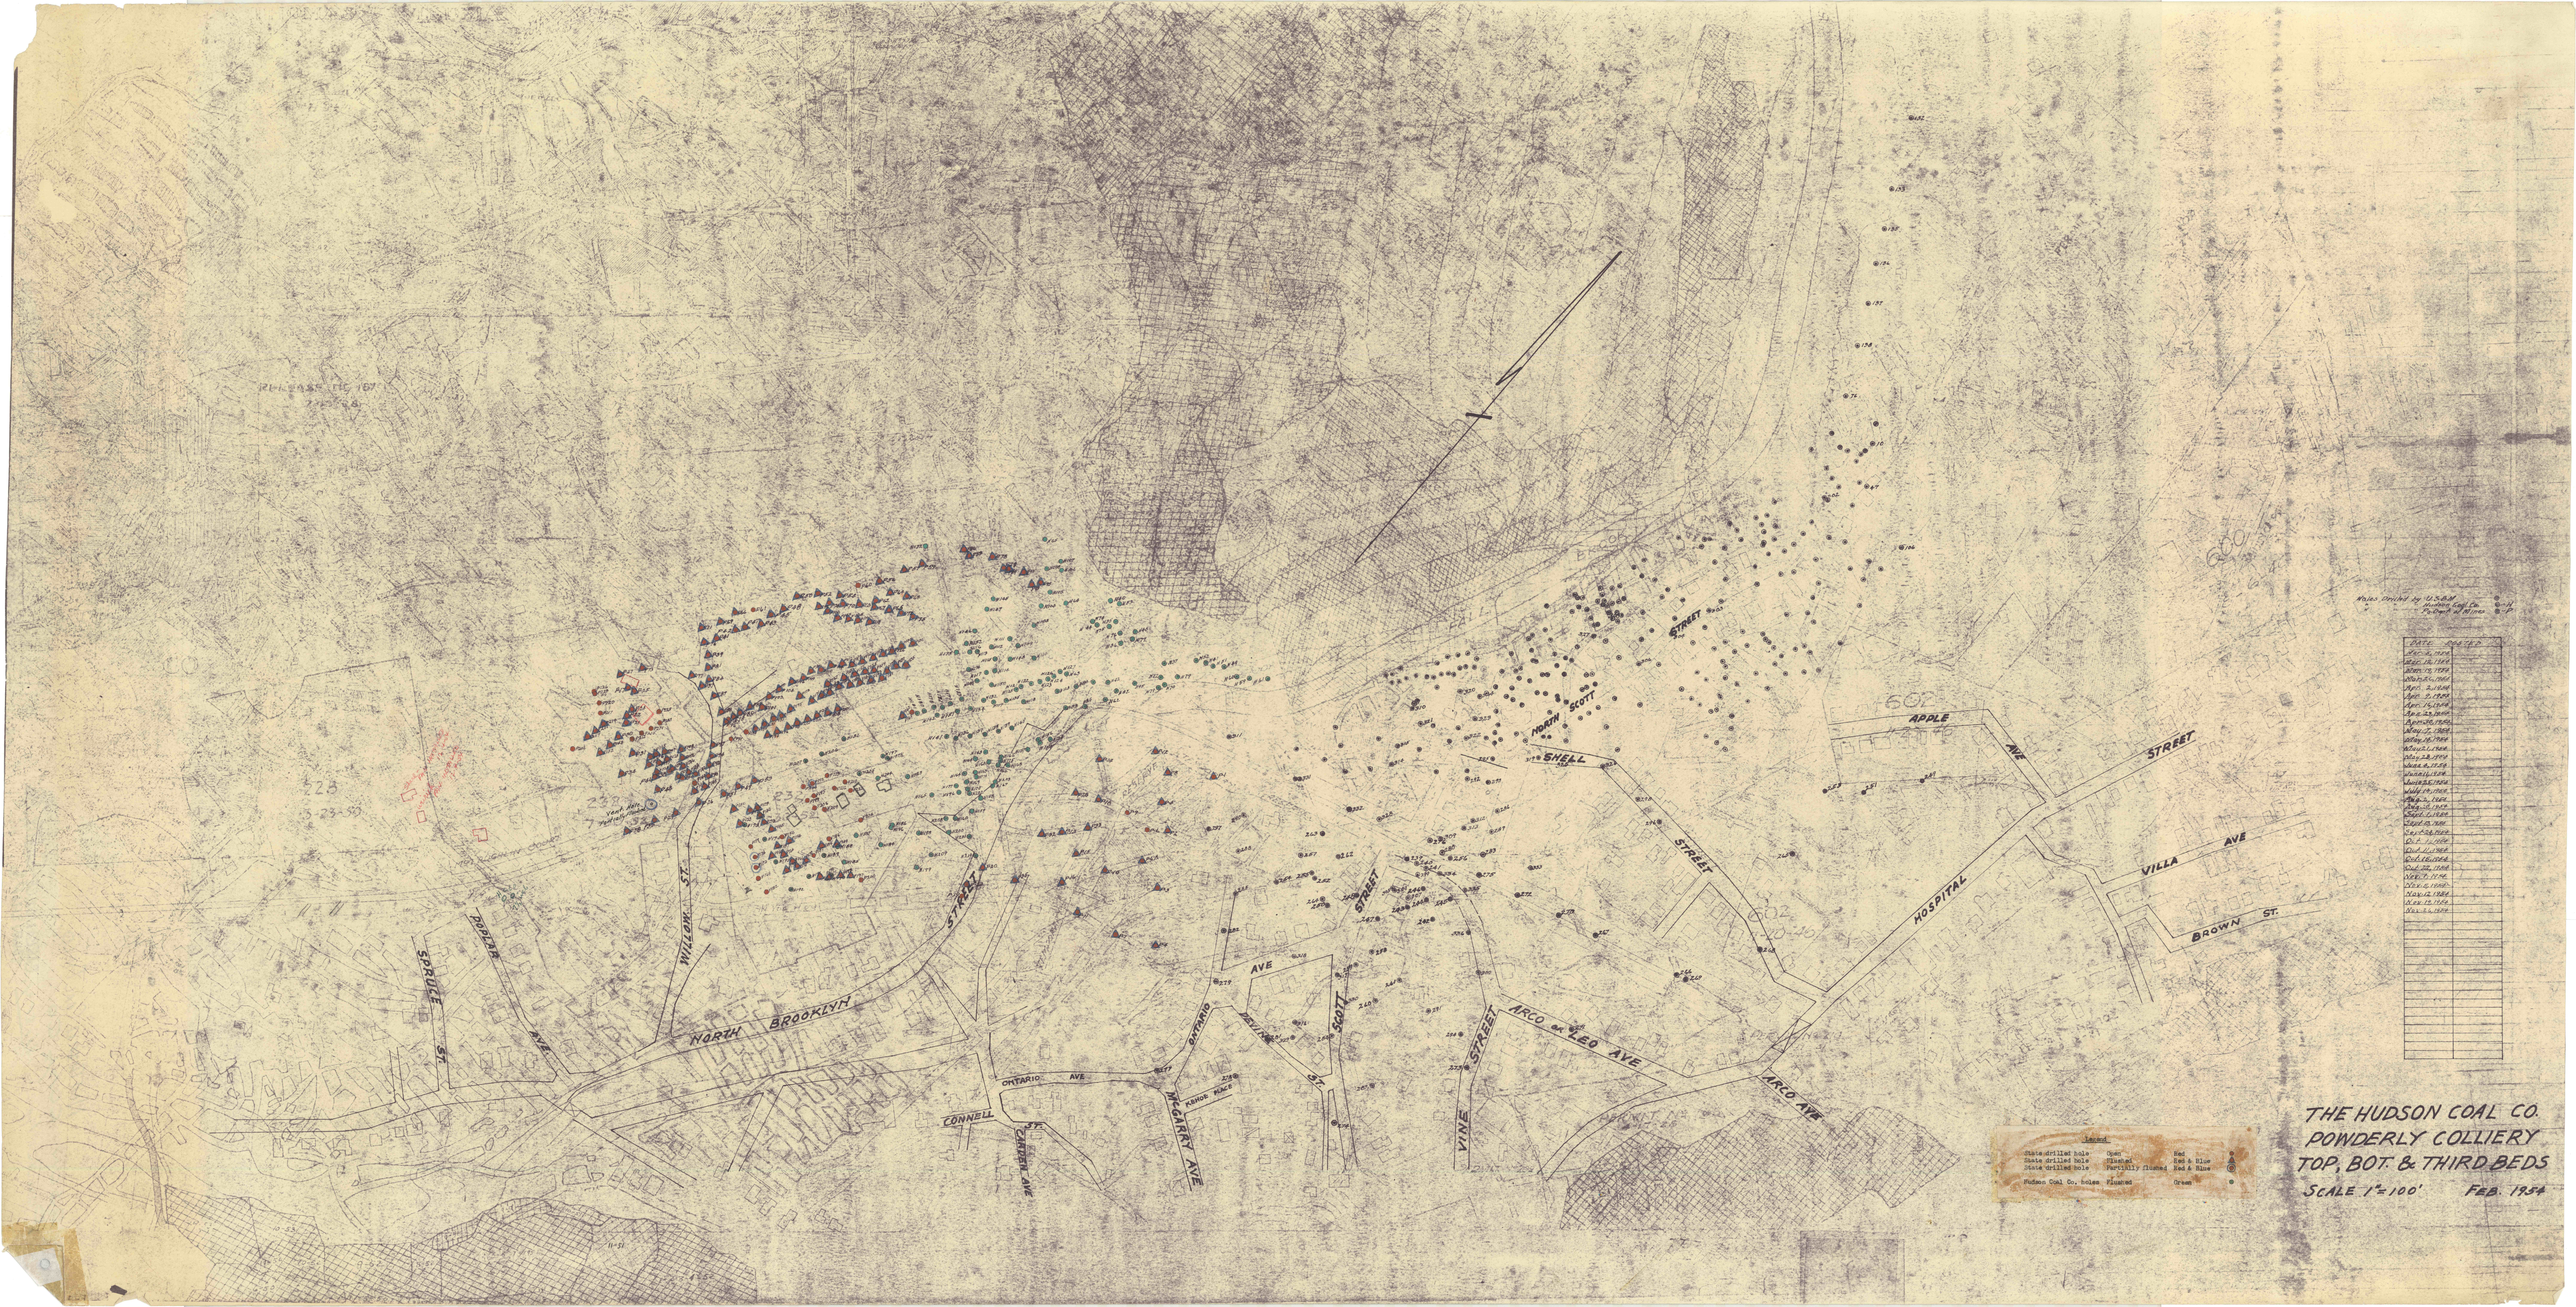
PLEASE FILE 167
Yard Rail Tipple
Shaft
Slope
Boreholes
Holes drilled by U.S.B.M.
Hudson Coal Co.
Records of Mines
DATE
SHELL
NORTH SCOTT STREET
APPLE AVE
STREET
HOSPITAL
VILLA AVE
BROWN ST.
NORTH BROOKLYN
WILLOW ST.
POPLAR AVE
SPRUCE ST.
ONTARIO AVE
CONNELL ST.
CARVER AVE
McGARRY AVE
ASHOE ROAD
OXFORD AVE
PHILLIPS ST.
SCOTT STREET
VINE STREET
ARCO or LEO AVE
ARCO AVE
Legend
State drilled hole
Open
Red
Red & Blue
Plugged
Partially flooded
Flooded
Green
Hudson Coal Co. holes
THE HUDSON COAL CO.
POWDERLY COLLIERY
TOP, BOT. & THIRD BEDS
SCALE 1"=100'
FEB. 1954