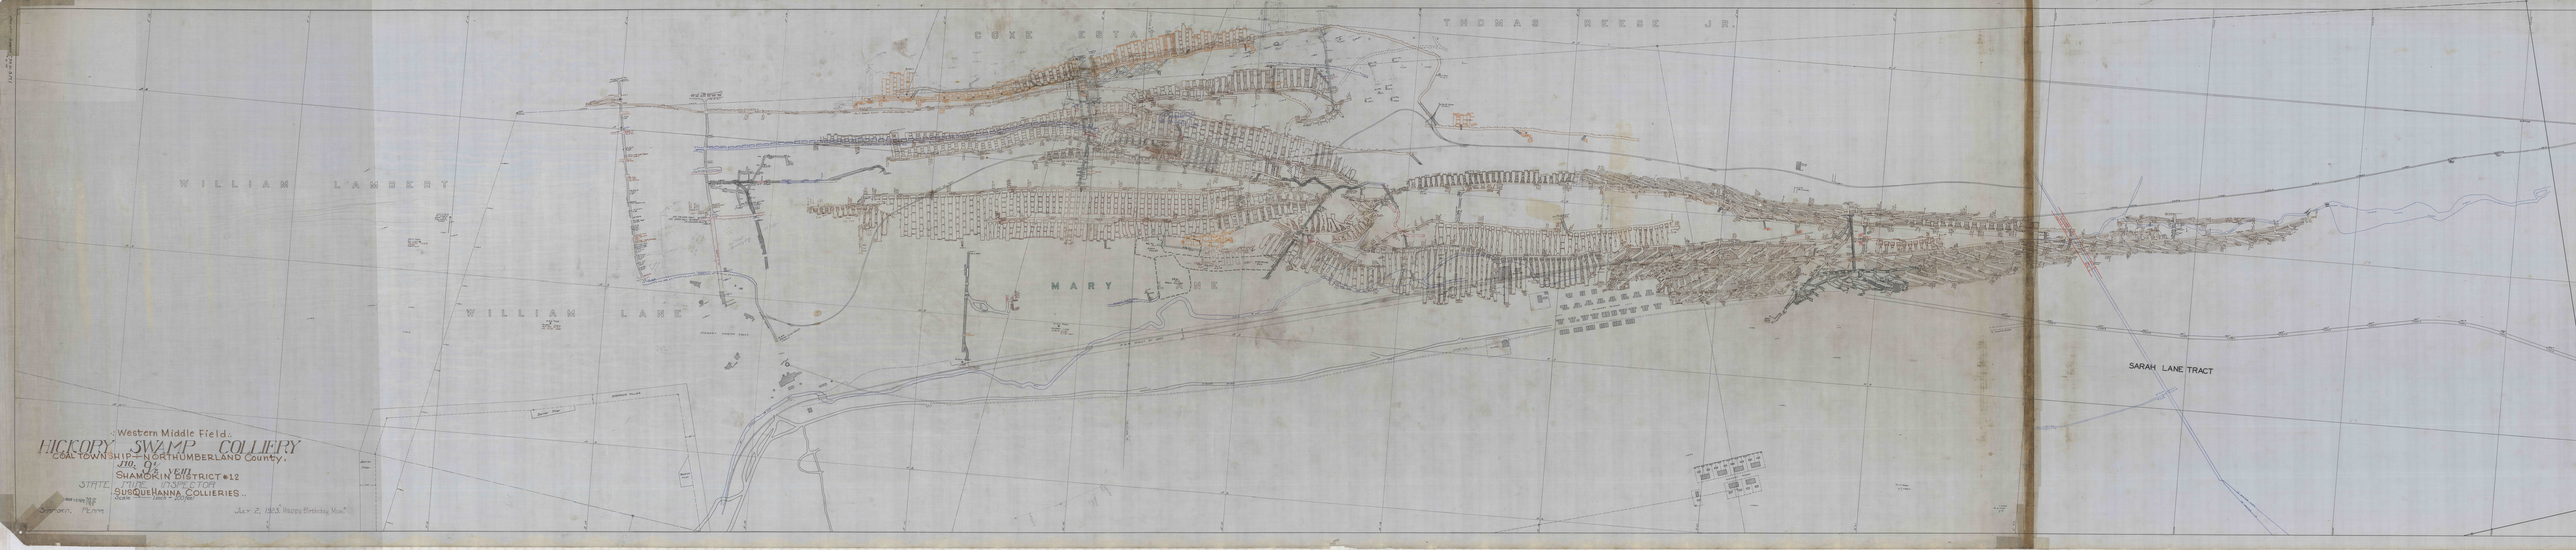

Western Middle Field.

HICKORY SWAMP COLLIERY

COAL TOWNSHIP NORTHUMBERLAND County.

No. 92 VEIN

SHAMOKIN DISTRICT #12

STATE MINE INSPECTION

SUSQUEHANNA COLLIERIES.

Jan 2, 1903 Happy Birthday Mom