


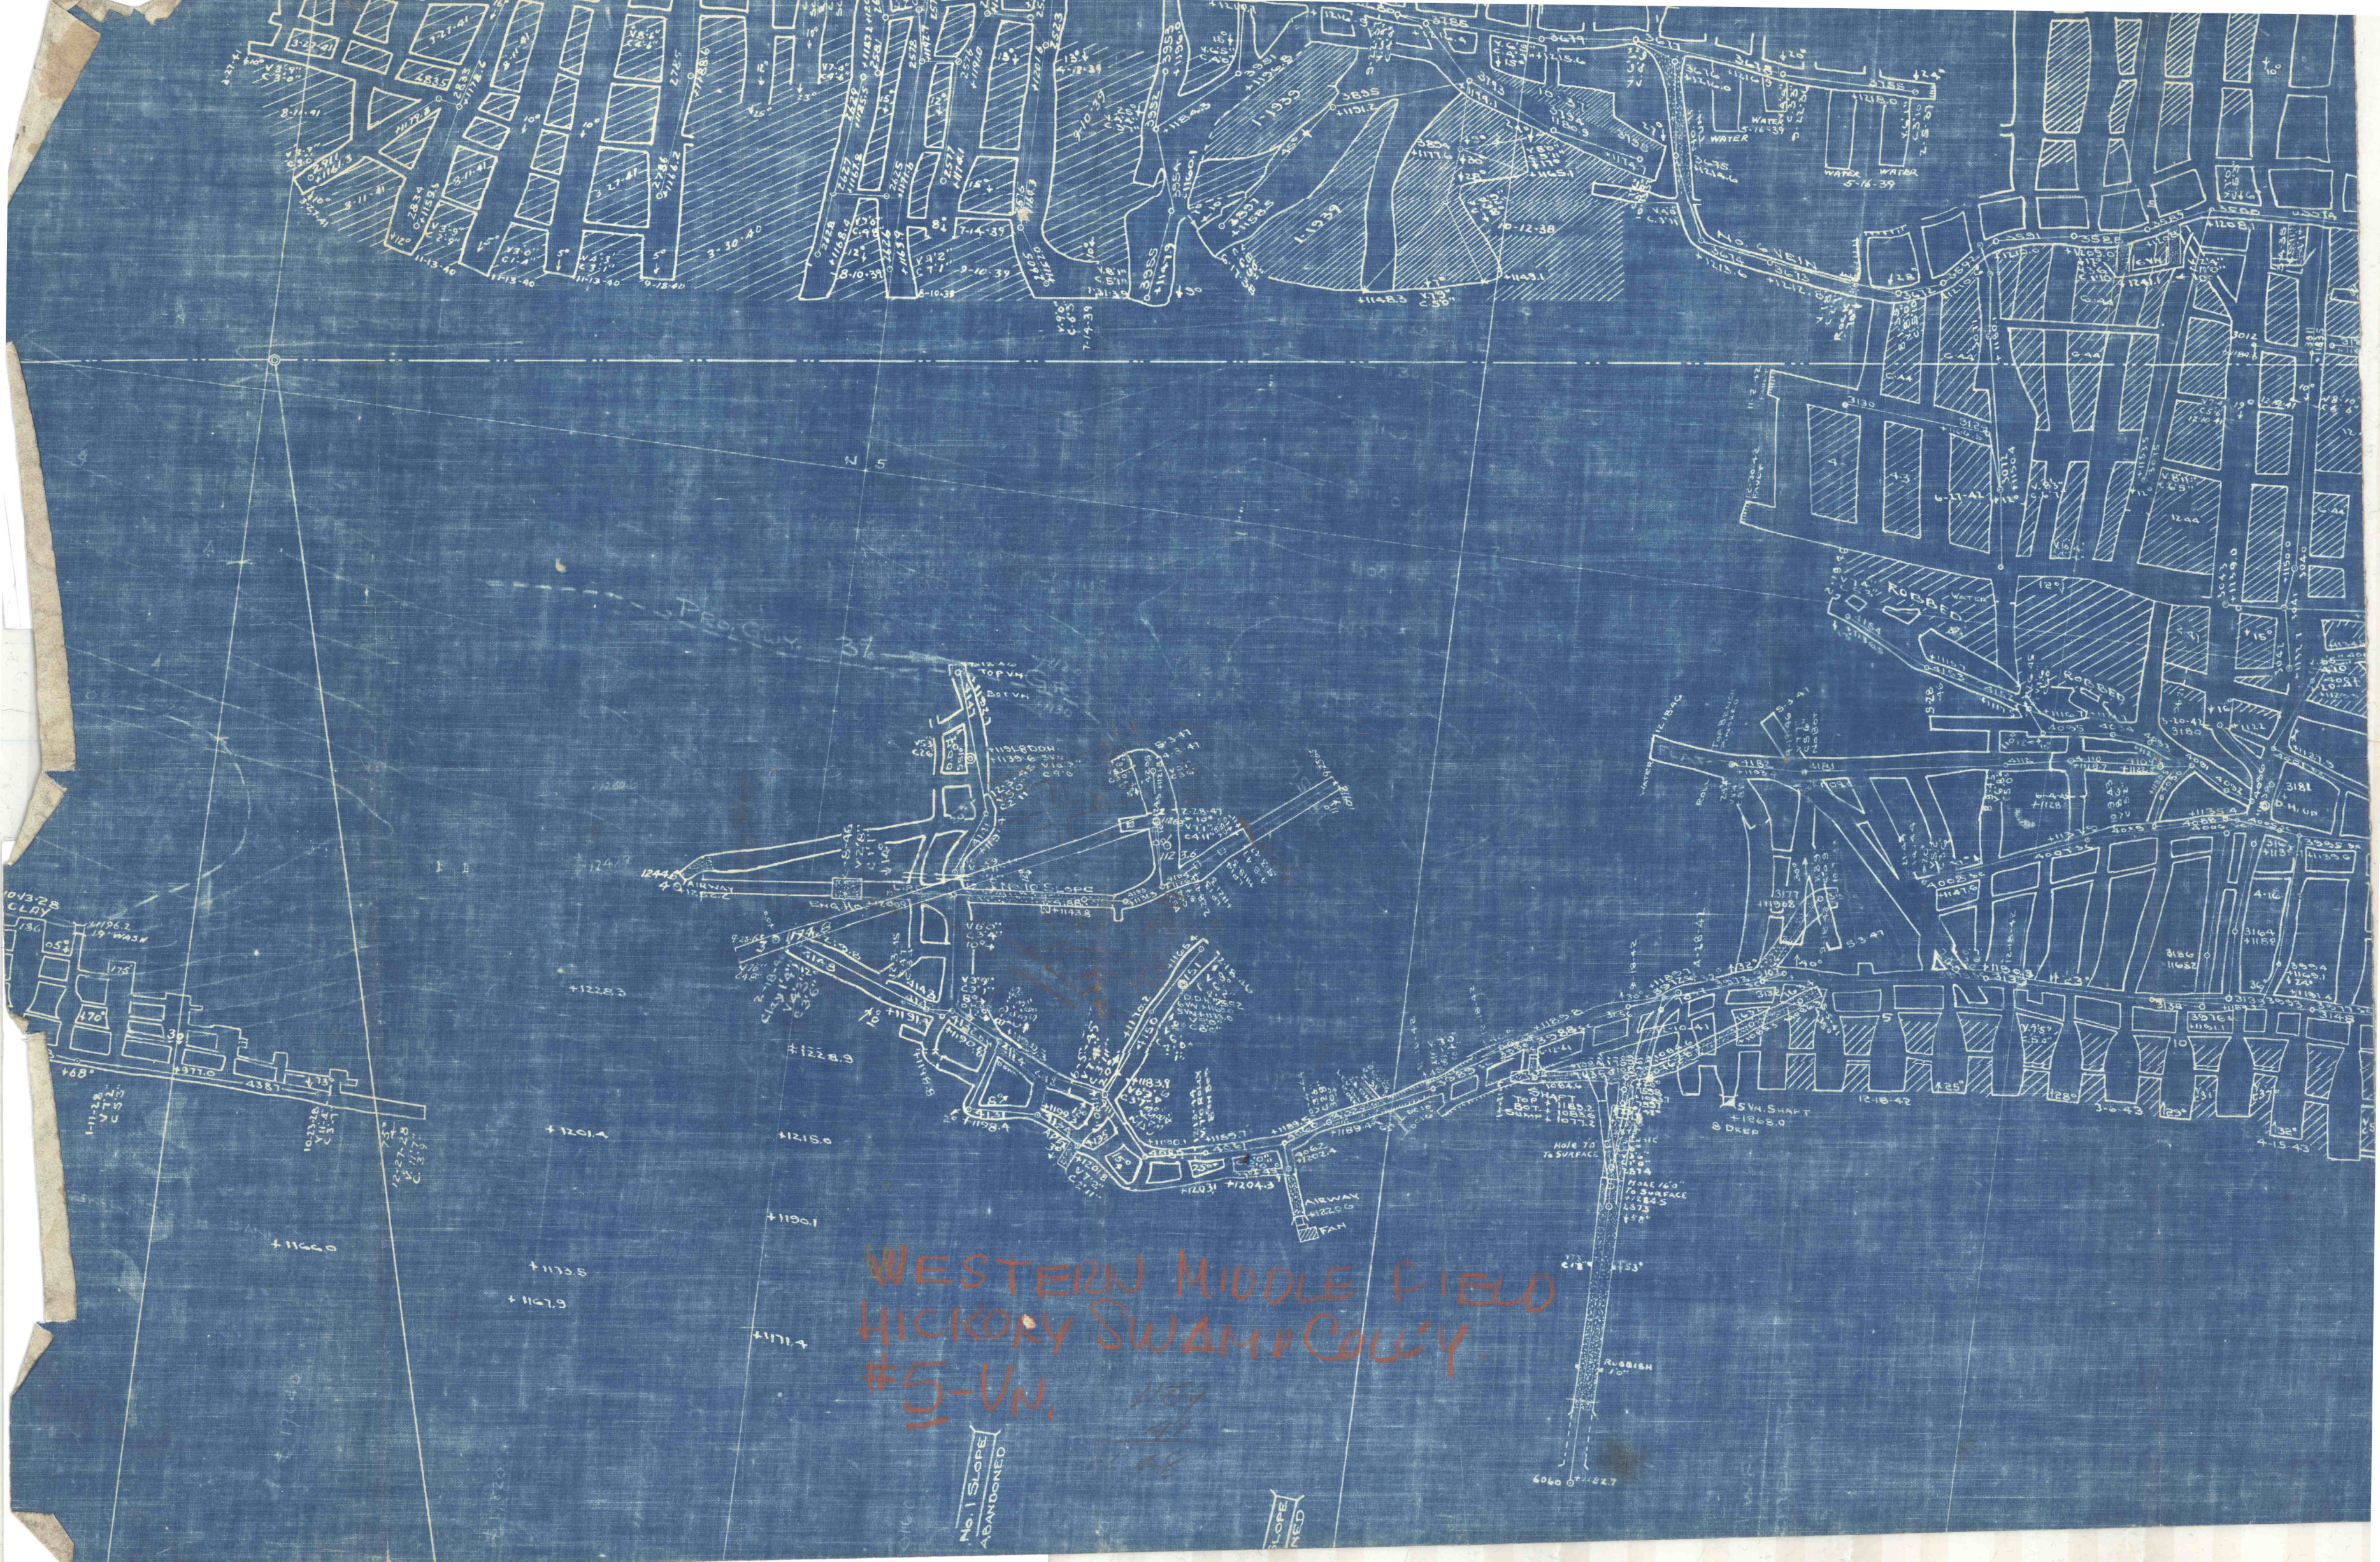

WESTERN MIDDLE FIELD
#5-VN.

No. 1 SLOPE
ABANDONED

SLOPE
NEED